


NEW FACILITY FOR:
PARAGON GLOBAL RESOURCES
CANTERA CORPORATE CENTER - LOT 1
27501 BELLA VISTA PARKWAY, WARRENVILLE, IL

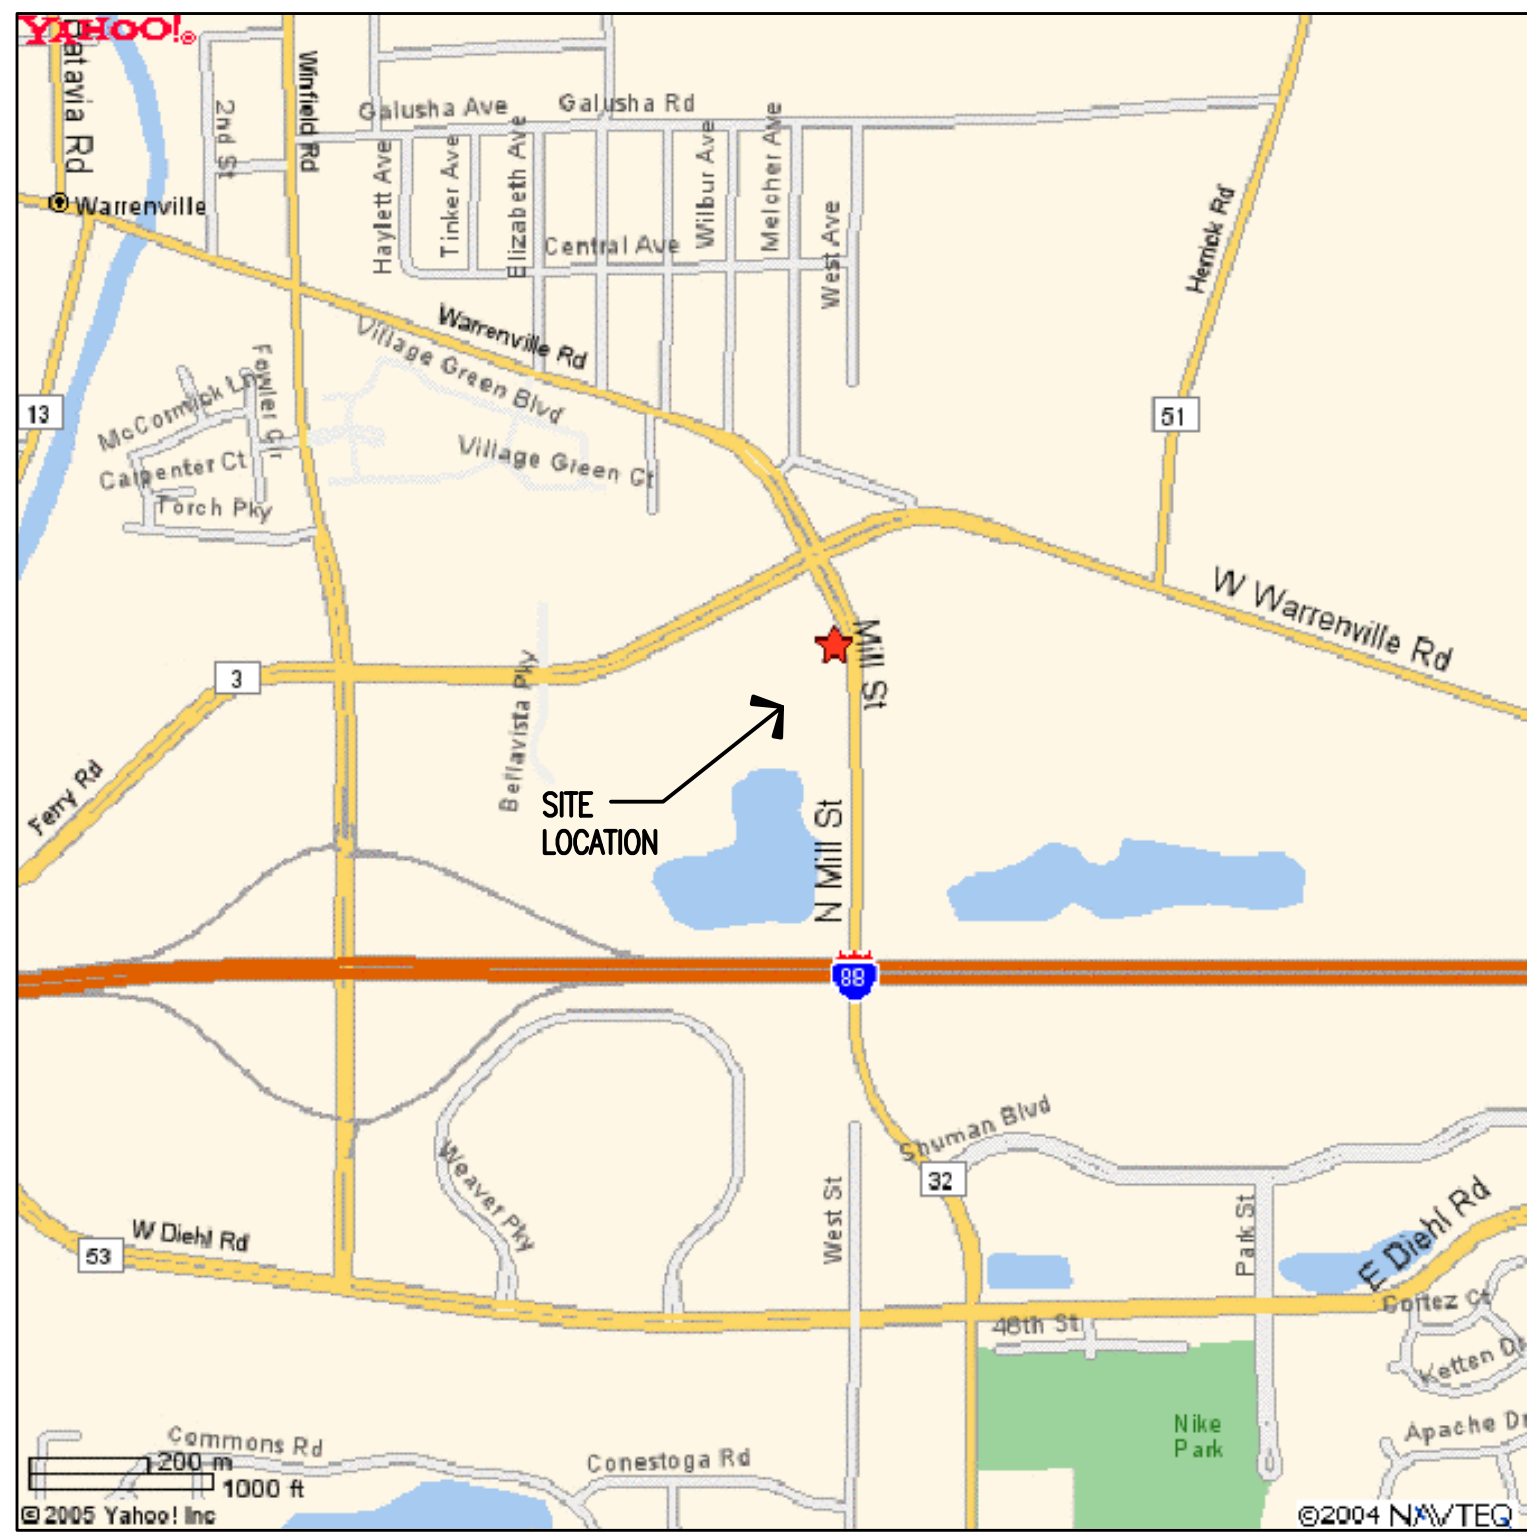

1
A101

SITE LOCATION MAP

Scale: NOT TO SCALE

SITE/BUILDING DATA

SITE AREA: x ACRES (x S.F.)

SQUARE FOOTAGE SUMMARY:

FIRST FLOOR	20,000 SF
SECOND FLOOR	20,000 SF
ROOF CORNICE OVERHANG	909 SF
EXTERIOR CANOPY-NORTH	292 SF
EXTERIOR CANOPY-SOUTH	292 SF
ROOF SCREEN ENCLOSURE	4,000 SF
TRASH ENCLOSURE	225 SF
GENERATOR ENCLOSURE	168 SF
FUTURE PATIO	4,200 SF
TOTAL AREA =	50,086 SF

1999 BOCA BUILDING CODE

BUILDING USE GROUPS: B, BUSINESS

CONSTRUCTION CLASSIFICATION:

NON-COMBUSTIBLE, UNPROTECTED, TYPE 2-C

ALLOWABLE BLD'G. HEIGHT (W/ SPRINKLERS): 3 STORY, 60 FT

FACILITY SHALL HAVE A FULLY AUTOMATIC SPRINKLER SYSTEM

AREA LIMITATIONS:

BASE	14,400 SF
STREET FRONTAGE INCREASE: (OPEN PERIMETER/PERIMETER-.25) x 2 =	
(500 / 600 - .25) x 2 x 14,400 =	16,800 SF
AUTOMATIC SPRINKLER SYSTEM	28,800 SF
TOTAL ALLOWABLE AREA = 60,000 SF > 20,000 SF ACTUAL	

STRUCTURAL ELEMENTS (FBI. 602):

EXTERIOR LOAD BEARING WALLS	0 HOUR
FIRE WALL & PARTY WALLS	2 HOURS
FIRE SEPARATION ASSEMBLIES:	
EXITS (sect. 1014.11)	1 HOUR
SHAFTS (sect. 710.3)	1 HOUR

FIRE PARTITIONS:

EXIT ACCESS CORRIDORS (tbl. 1011.4)	0 HOURS
TENANT SEPARATION	0 HOUR

INTERIOR BEARING WALLS, COLUMNS, GIRDERS, TRUSSES (OTHER THAN ROOF TRUSSES) & FRAMING	0 HOUR
FLOOR CONSTRUCTION INCL. BEAMS	0 HOUR
ROOF CONSTRUCTION, INCL. BEAMS, TRUSSES & ROOF DECK, 15' OR LESS IN HT.	0 HOURS
LENGTH OF EXIT TRAVEL (sect. 1006.5) -----	250 FT.

CLIENT:

DUKE CONSTRUCTION
4225 NAPERVILLE ROAD, SUITE 150
LISLE, IL 60532
TEL. 630/577-7900

OWNER'S REPRESENTATIVE:

HSA COMMERCIAL REAL ESTATE
180 NORTH WACKER DRIVE
CHICAGO, IL 60606
TEL. 312/332-3555

CIVIL ENGINEER:

WEBSTER, McGRATH & AHLBERG, LTD
207 SOUTH NAPERVILLE ROAD
WHEATON, IL 60187
TEL. 630/668-7603

LANDSCAPE ARCHITECT:

MARTIN DESIGN PARTNERSHIP
335 N. RIVER ST., SUITE 201
BATAVIA, IL 60510
TEL. 630/482-2532

ARCHITECT:

TIMOTHY MORGAN ASSOCIATES
200 TRI-STATE INTERNATIONAL CENTER
LINCOLNSHIRE, IL 60069
TEL. 847/374-0058

STRUCTURAL ENGINEER:

STRUCTURES UNLIMITED
675 SEYBROOKE
CRYSTAL LAKE, IL 60012
TEL. 815/444-6424

PLUMBING ENGINEER:

MVP PLUMBING GROUP
1995 AUCUTT ROAD
MONTGOMERY, IL 60538
TEL. 630/897-6000

FIRE PROTECTION ENGINEER:

SHAMBAUGH & SON, L.P.
2820 THATCHER ROAD, UNIT 1
DOWNERS GROVE, IL 60515
TEL. 630/725-0500

MECHANICAL ENGINEER:

PRAIRIE MECHANICAL, INC.
2256 SOUTHWIND BLVD.
BARTLETT, IL 60103
TEL. 630/497-7600

ELECTRICAL ENGINEER:

ELECTRICAL DESIGN SYSTEMS CORP.
510 EXCHANGE COURT
AURORA, IL 60504
TEL. 630/499-7800

DRAWING INDEX

A101 TITLE SHEET

CIVIL:

- C1 COVER SHEET
- C2 EXISTING CONDITIONS PLAN
- C3 PAVING AND LAYOUT PLAN
- C4 GRADING PLAN
- C5 UTILITY PLAN
- C6 EROSION CONTROL PLAN
- C7 CONSTRUCTION DETAILS
- C8 CONSTRUCTION DETAILS
- C9 STORM WATE POLLUTION PREVENTION PLAN
- C10 STORM WATE POLLUTION PREVENTION PLAN

LANDSCAPE:

- L1 LANDSCAPE PLAN
- L2 LANDSCAPE DETAILS

ARCHITECTURAL:

- A201 FIRST FLOOR PLAN
- A202 SECOND FLOOR PLAN
- A203 ROOF FLOOR PLAN
- A204 ENLARGED CORE PLANS
- A205 FIRST FLOOR REFLECTED CEILING PLAN
- A206 SECOND FLOOR REFLECTED CEILING PLAN
- A301 EXTERIOR ELEVATIONS
- A302 BUILDING SECTION, TRASH & GENERATOR ENCLOSURE PLANS
- A303 STAIR DETAILS, INTERIOR ELEVATIONS
- A304 INTERIOR ELEVATIONS
- A401 WALL SECTIONS
- A402 DETAILS
- A501 DOOR SCHEDULE, DETAILS
- A502 ROOM FINISH SCHEDULE, DETAILS

STRUCTURAL:

- S1 FOUNDATION PLAN
- S2 FOUNDATION DETAILS
- S3 SECOND FLOOR FRAMING PLAN
- S4 ROOF FRAMING PLAN
- S5 STEEL DETAILS
- S6 STEEL DETAILS
- S7 GENERAL NOTES

PLUMBING:

- P1 FIRST FLOOR PLUMBING PLAN
- P2 SECOND FLOOR PLUMBING PLAN
- P3 SPECIFICATION AND DETAILS

FIRE PROTECTION:

- FP-1 FIRST FLOOR FIRE PROTECTION PLAN
- FP-2 SECOND FIRE PROTECTION PLAN
- FP-3 DETAILS & GENERAL NOTES

MECHANICAL:

- M1 FIRST FLOOR MECHANICAL PLAN
- M2 SECOND FLOOR MECHANICAL PLAN
- M3 MECHANICAL ROOF PLAN
- M4 SCHEDULES AND DETAILS

ELECTRICAL:

- E201 ELECTRICAL SITE PLAN
- E202 FIRST FLOOR LIGHTING PLAN
- E203 SECOND FLOOR LIGHTING PLAN
- E204 FIRST FLOOR POWER & HVAC PLAN
- E205 SECOND FLOOR POWER & HVAC PLAN
- E206 FIRST FLOOR FIRE ALARM PLAN
- E207 SECOND FLOOR FIRE ALARM PLAN
- E501 ELECTRICAL RISER DIAGRAMS
- E502 ELECTRICAL PANEL SCHEDULES
- A503 FIRE ALARM SCHEDULES & DETAILS

STATEMENT OF COMPLIANCE

I have prepared, or caused to be prepared under my direct supervision, the attached plans and specifications and state that, to the best of my knowledge and belief and to the extent of my contractual obligation, they are in compliance with the Environmental Barriers Act [410 ILCS 25] and the Illinois Accessibility Code (71 Ill. Adm. Code 400).

Signed: _____ ILLINOIS REGISTRATION NO.: _____
Architect/Engineer

Date: _____ Expiration Date: _____

Duke
REALTY CORPORATION
4225 Naperville Road
Suite 150
Lisle, IL 60532
Phone: (630) 577-7900
Fax: (630) 577-7979

TMA

Architects - Planners

Timothy Morgan Associates

200 Tri-State International Center
Suite 100
Lincolnshire, Illinois 60069
847 374-0058 phone
847 374-0057 fax

Revisions:
5/10/05 Initial Building Permit Submittal
8/23/05 Shell Construction Set
10/14/05 Rev's-Owner Finish Rev. Mtg

Scale:

Date:

5/10/05

Drawn By:

SBT

Checked By:

PARAGON GLOBAL RESOURCES

CANTERA CORPORATE CENTER - LOT 1

27501 BELLA VISTA PARKWAY

WARRENVILLE, ILLINOIS

TITLE SHEET

Certified By:

Drawing Number:

A101

Of



Sheets

Duke Realty Job Number:

PARAGN-001

A/E Job Number:

04-094

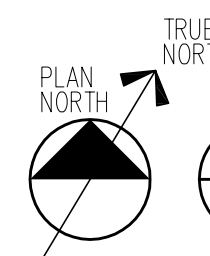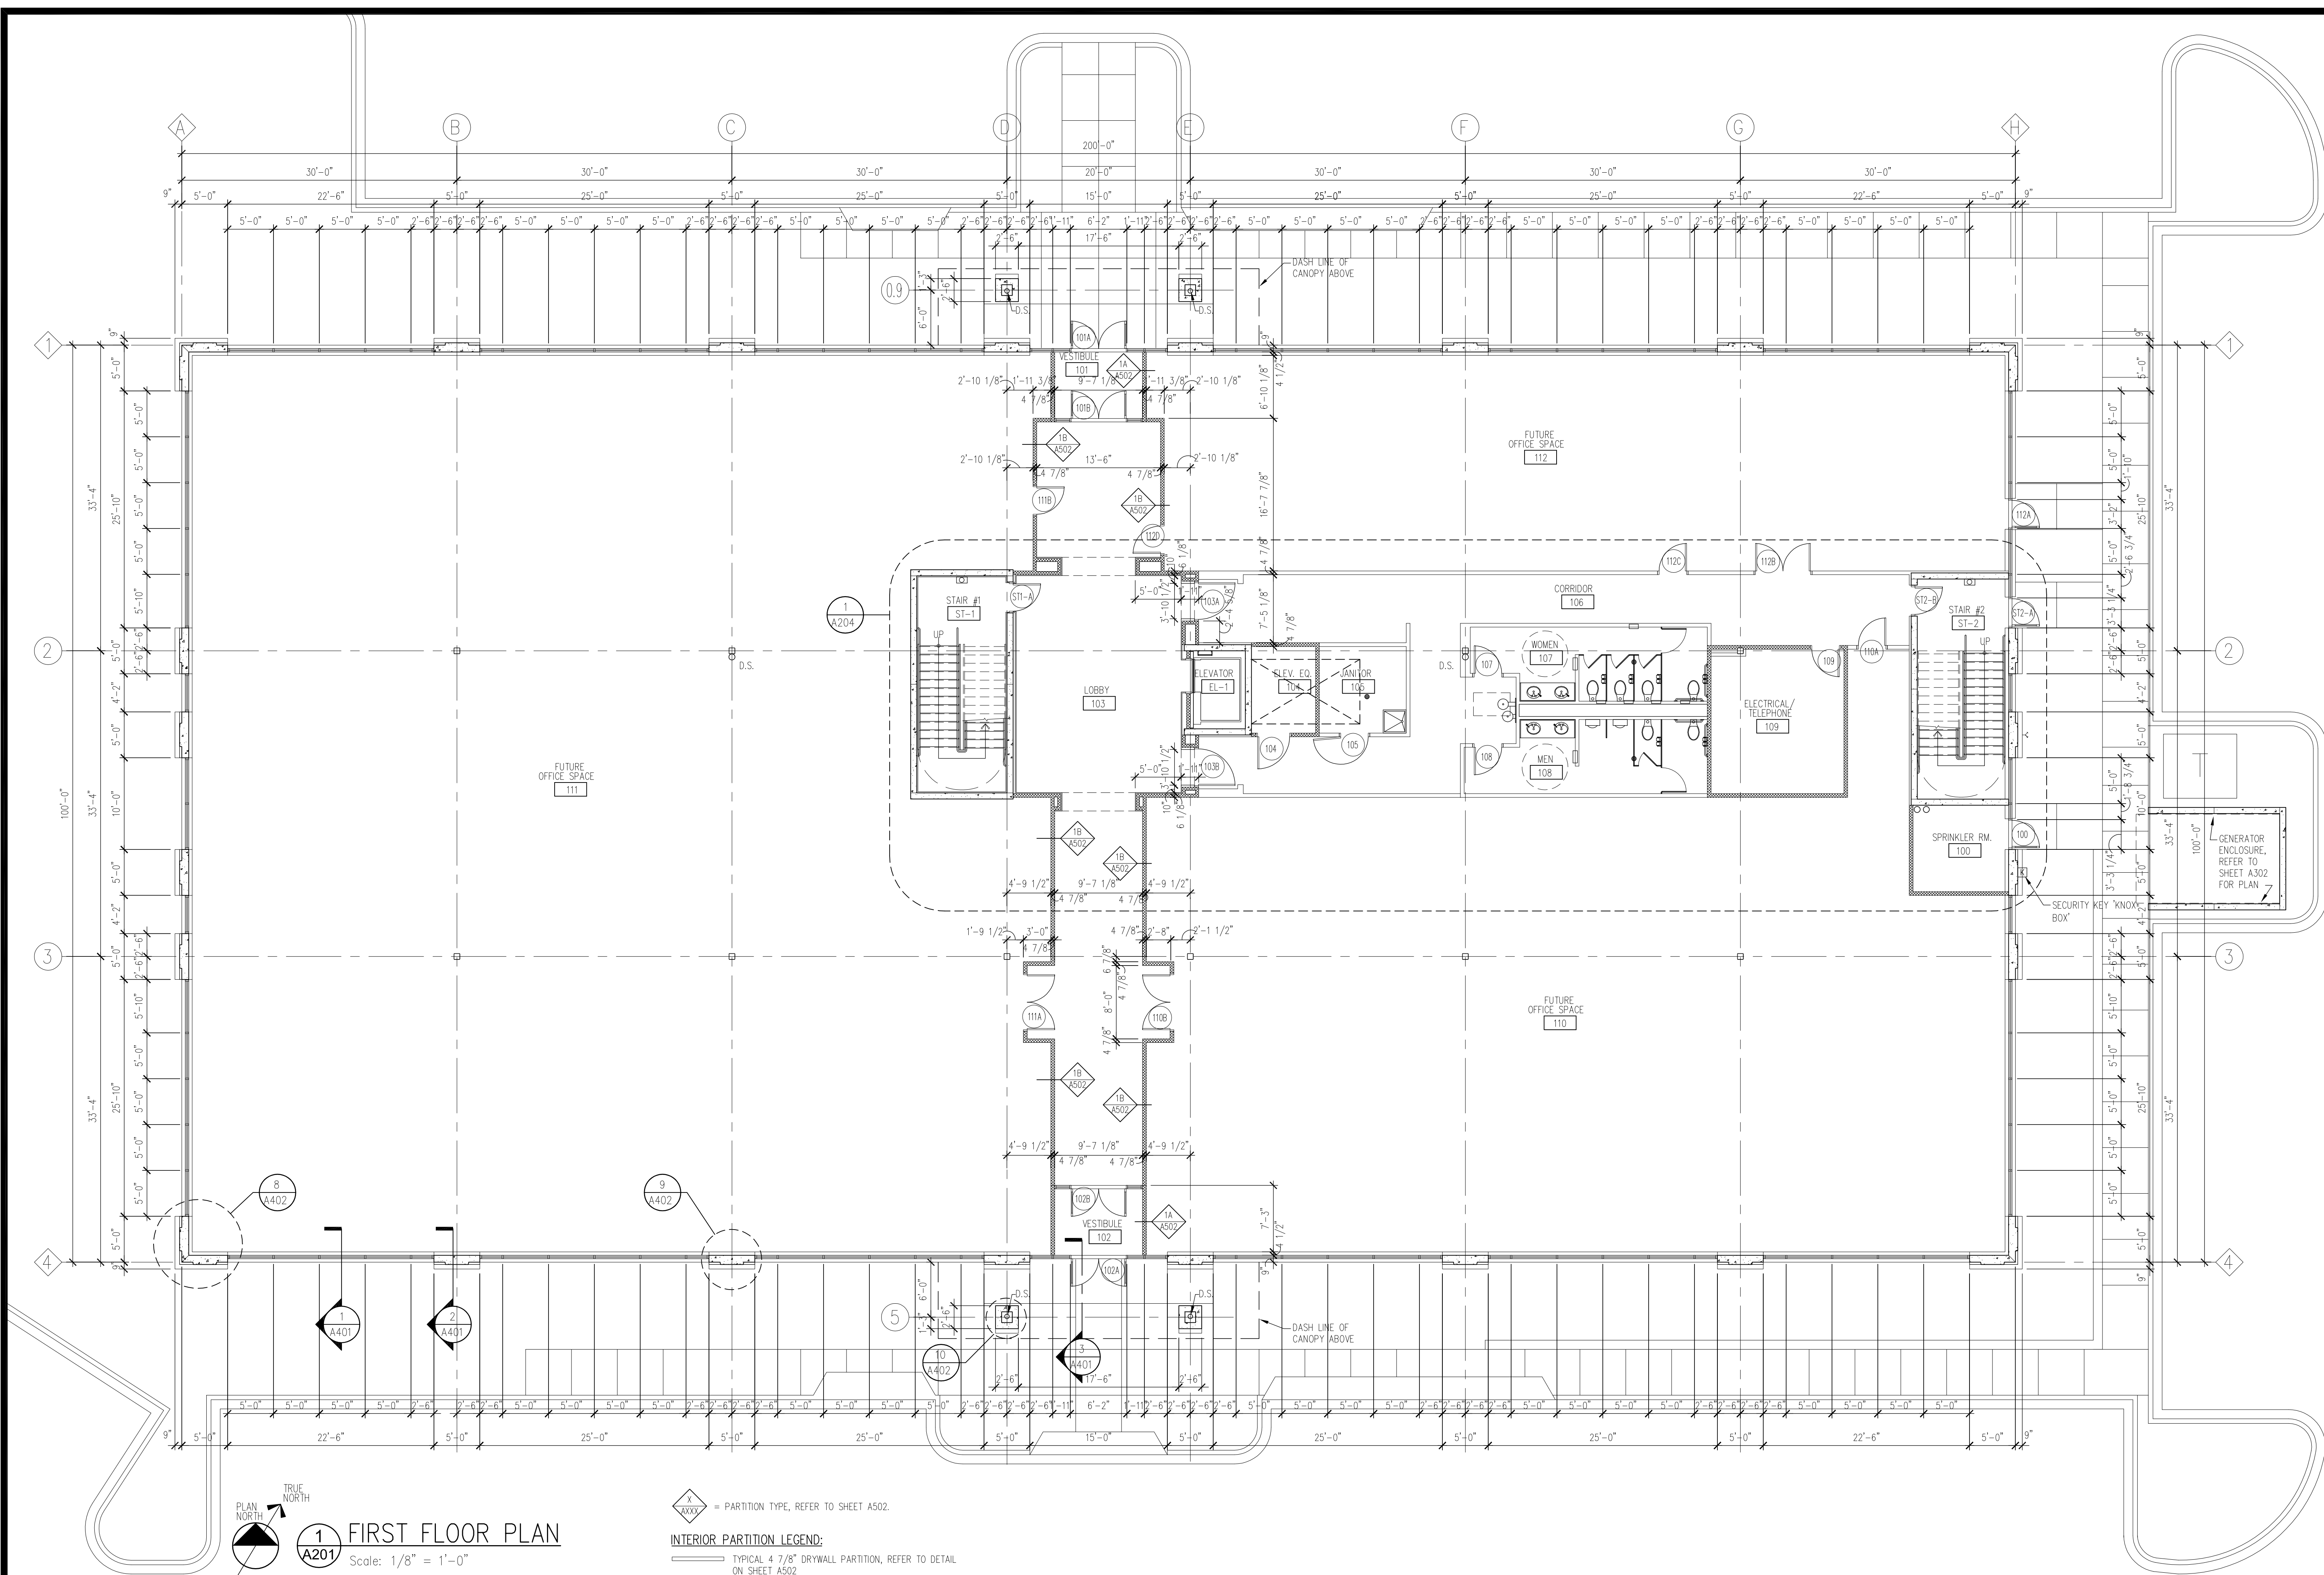

1 FIRST FLOOR PLAN
Scale: 1/8" = 1'-0"

X
XXX = PARTITION TYPE, REFER TO SHEET A502.



INTERIOR PARTITION LEGEND:

— TYPICAL 4 7/8" DRYWALL PARTITION, REFER TO DETAIL ON SHEET A502

----- TYPICAL FULL HEIGHT 4 7/8" DRYWALL, ONE-HOUR RATED, PARTITION, REFER TO DETAIL 1/A502

----- TYPICAL 3 1/8" SHAFTWALL, ONE-HOUR RATED, PARTITION, REFER TO DETAIL 6/A502

[---] TYPICAL 8" PRECAST CONCRETE INTERIOR PARTITION, ONE-HOUR REQUIRED, REFER TO DETAIL 9/A502

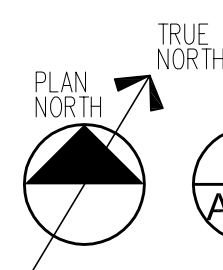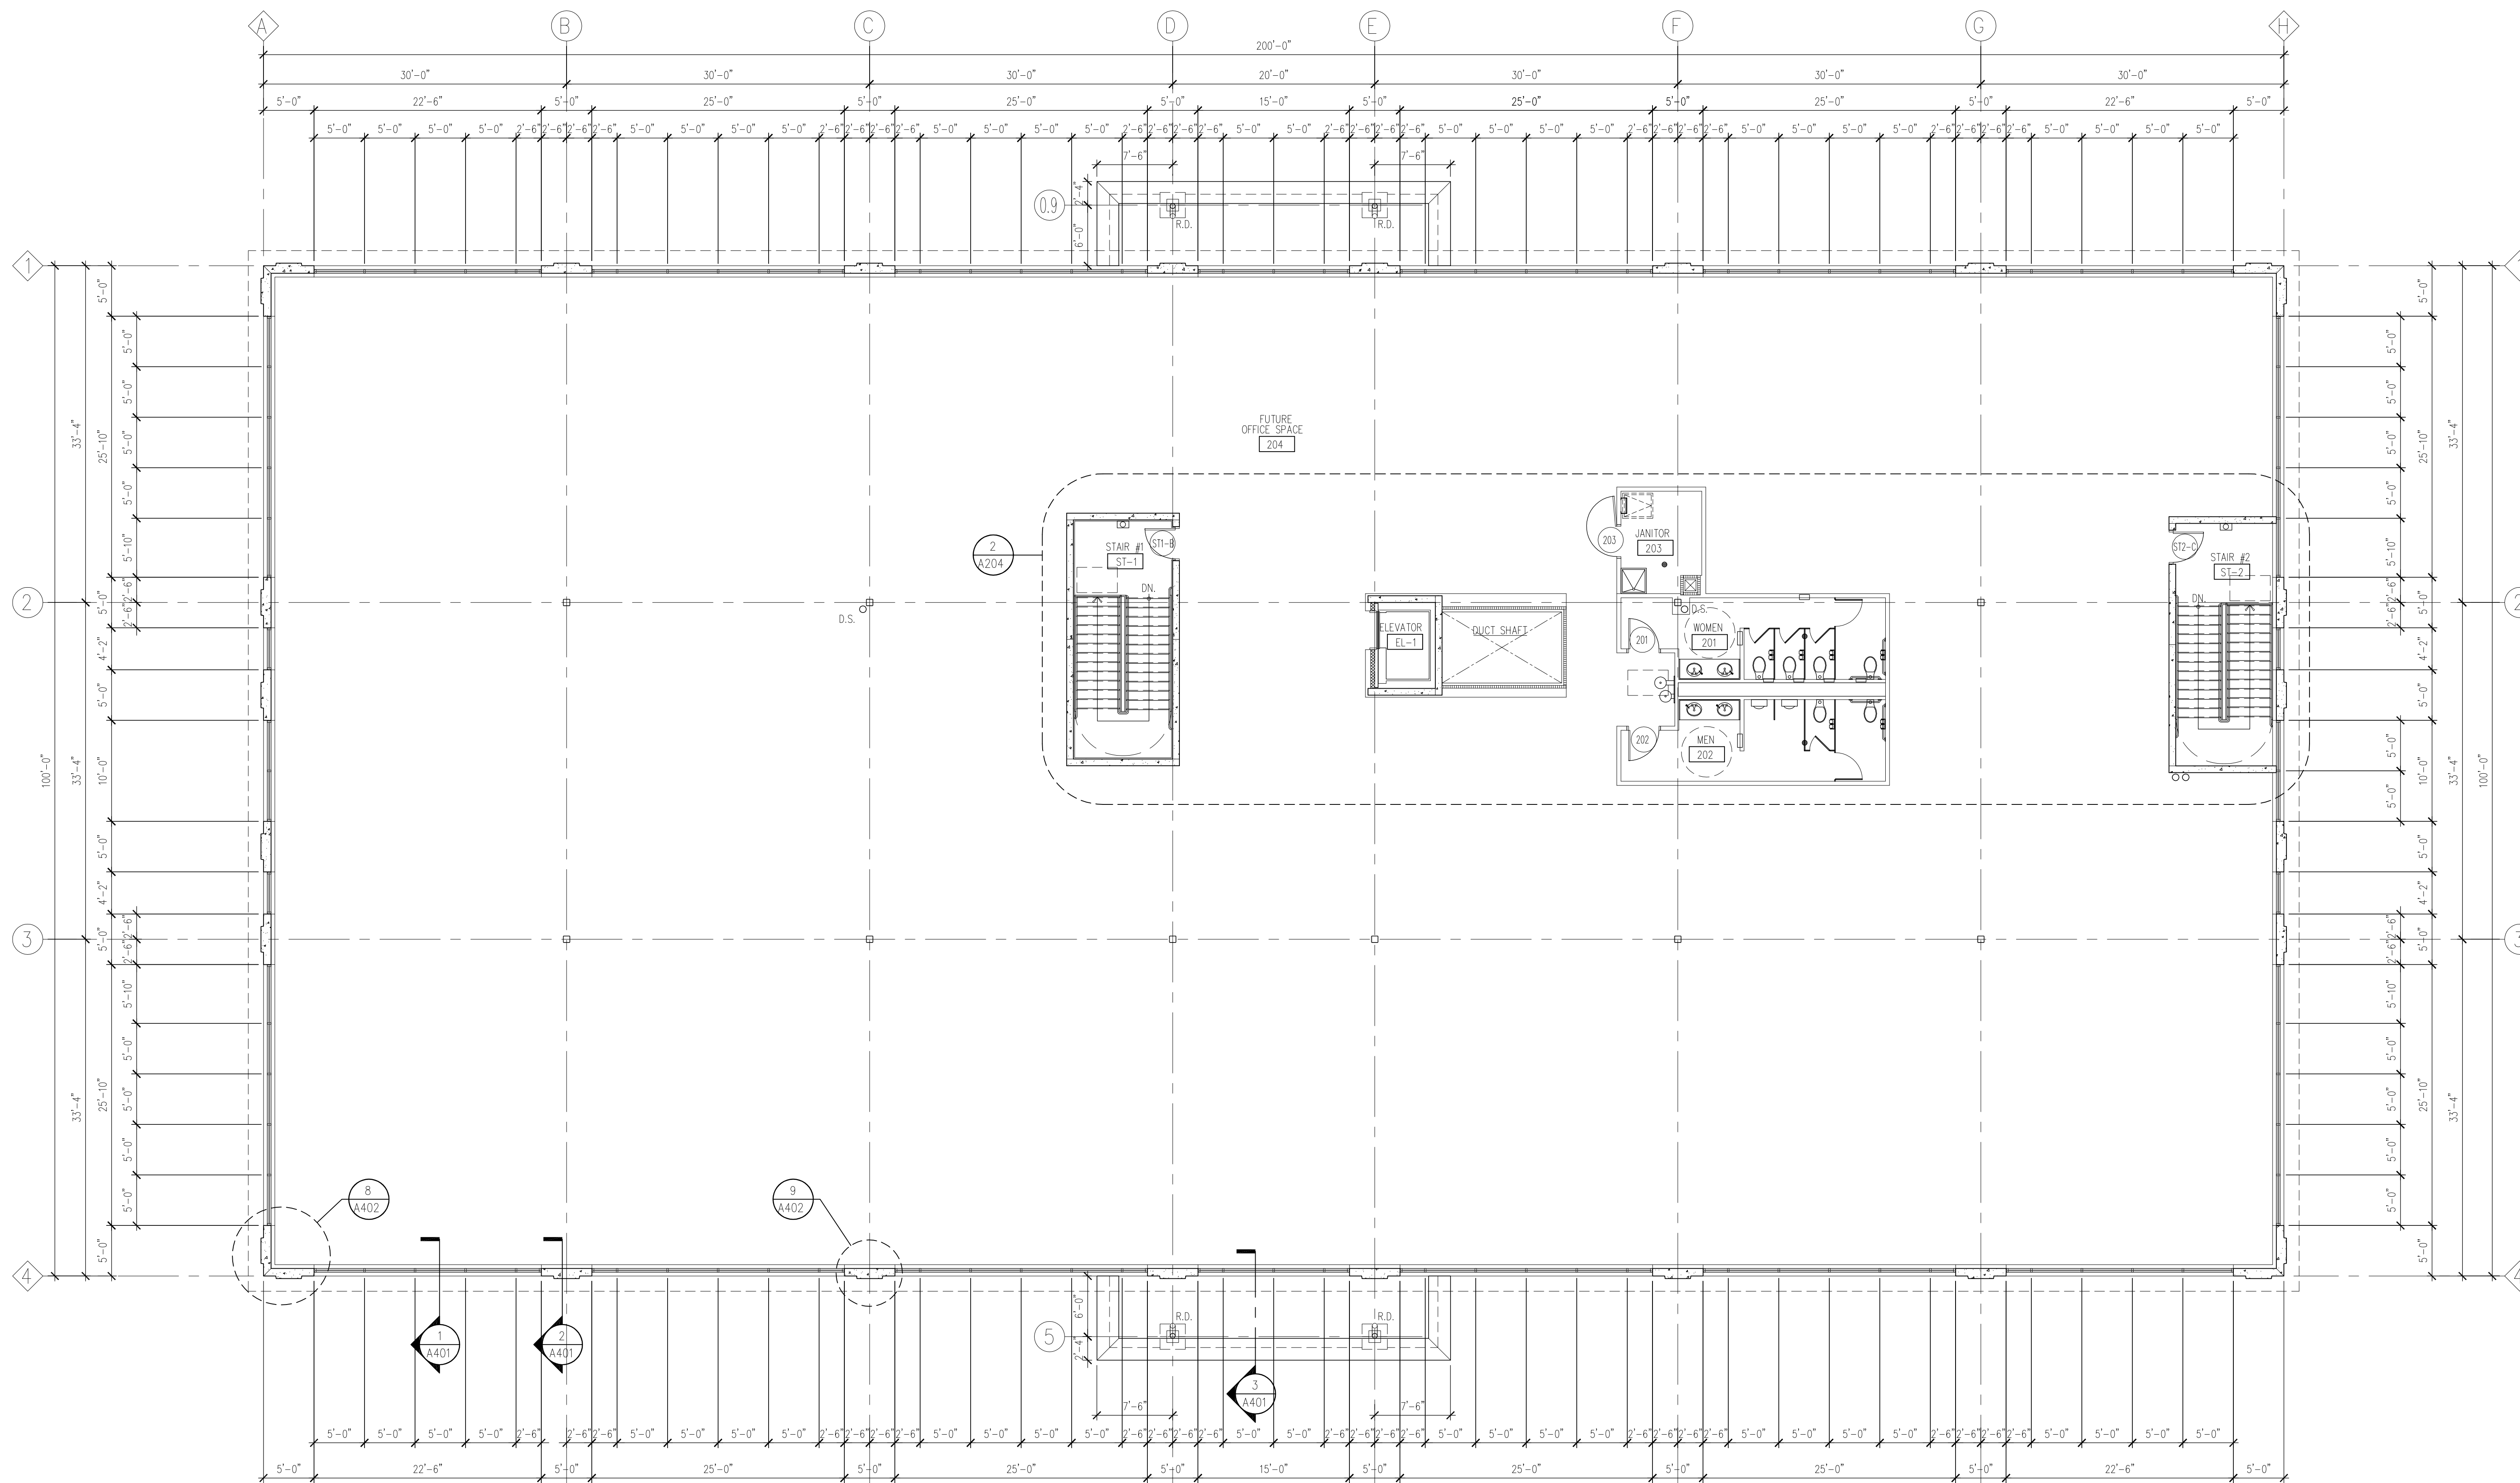

1 SECOND FLOOR PLAN
A202
Scale: 1/8" = 1'-0"



= PARTITION TYPE, REFER TO SHEET A502.



INTERIOR PARTITION LEGEND:

— TYPICAL 4 7/8" DRYWALL PARTITION, REFER TO DETAIL ON SHEET A502



===== TYPICAL FULL HEIGHT 4 7/8" DRYWALL, ONE-HOUR RATED, PARTITION, REFER TO DETAIL 1/A502



===== TYPICAL 3 1/8" SHAFTWALL, ONE-HOUR RATED, PARTITION, REFER TO DETAIL 6/A502

===== TYPICAL 8" PRECAST CONCRETE INTERIOR PARTITION, ONE-HOUR REQUIRED, REFER TO DETAIL 9/A502

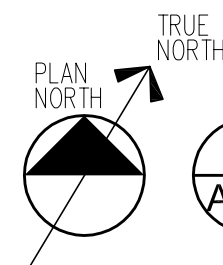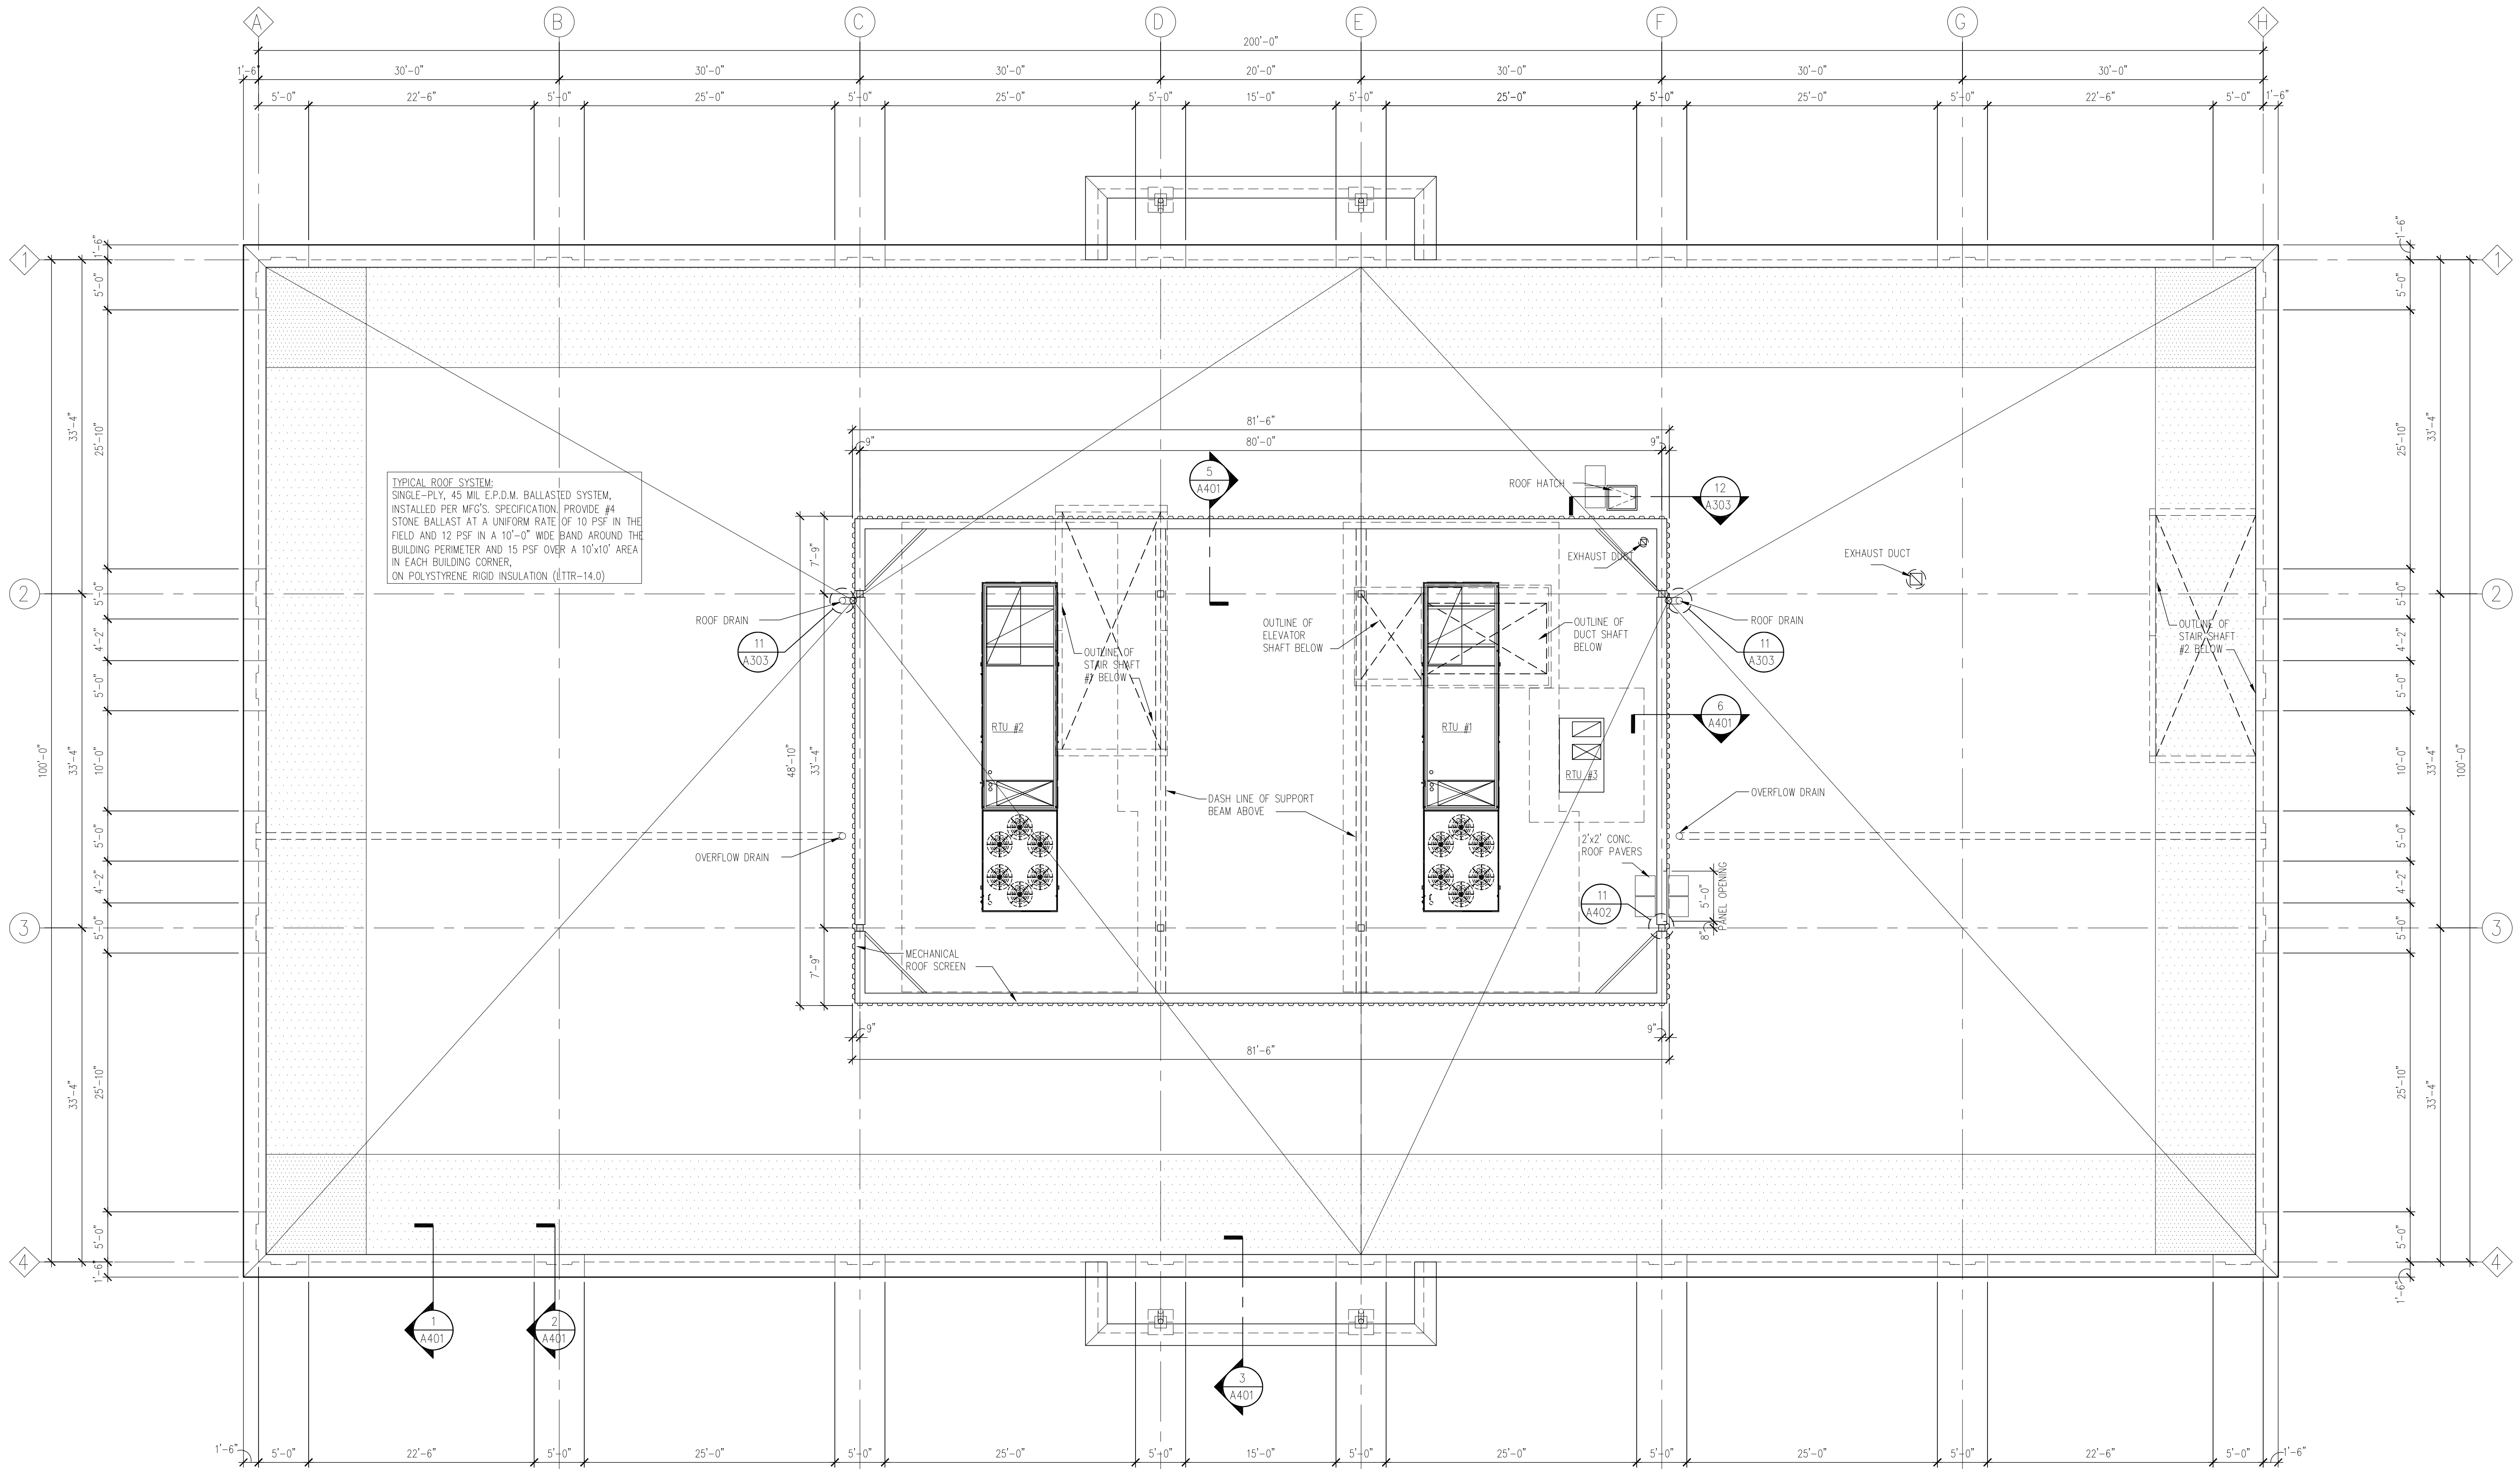

1 ROOF PLAN
A203
Scale: 1/8" = 1'-0"

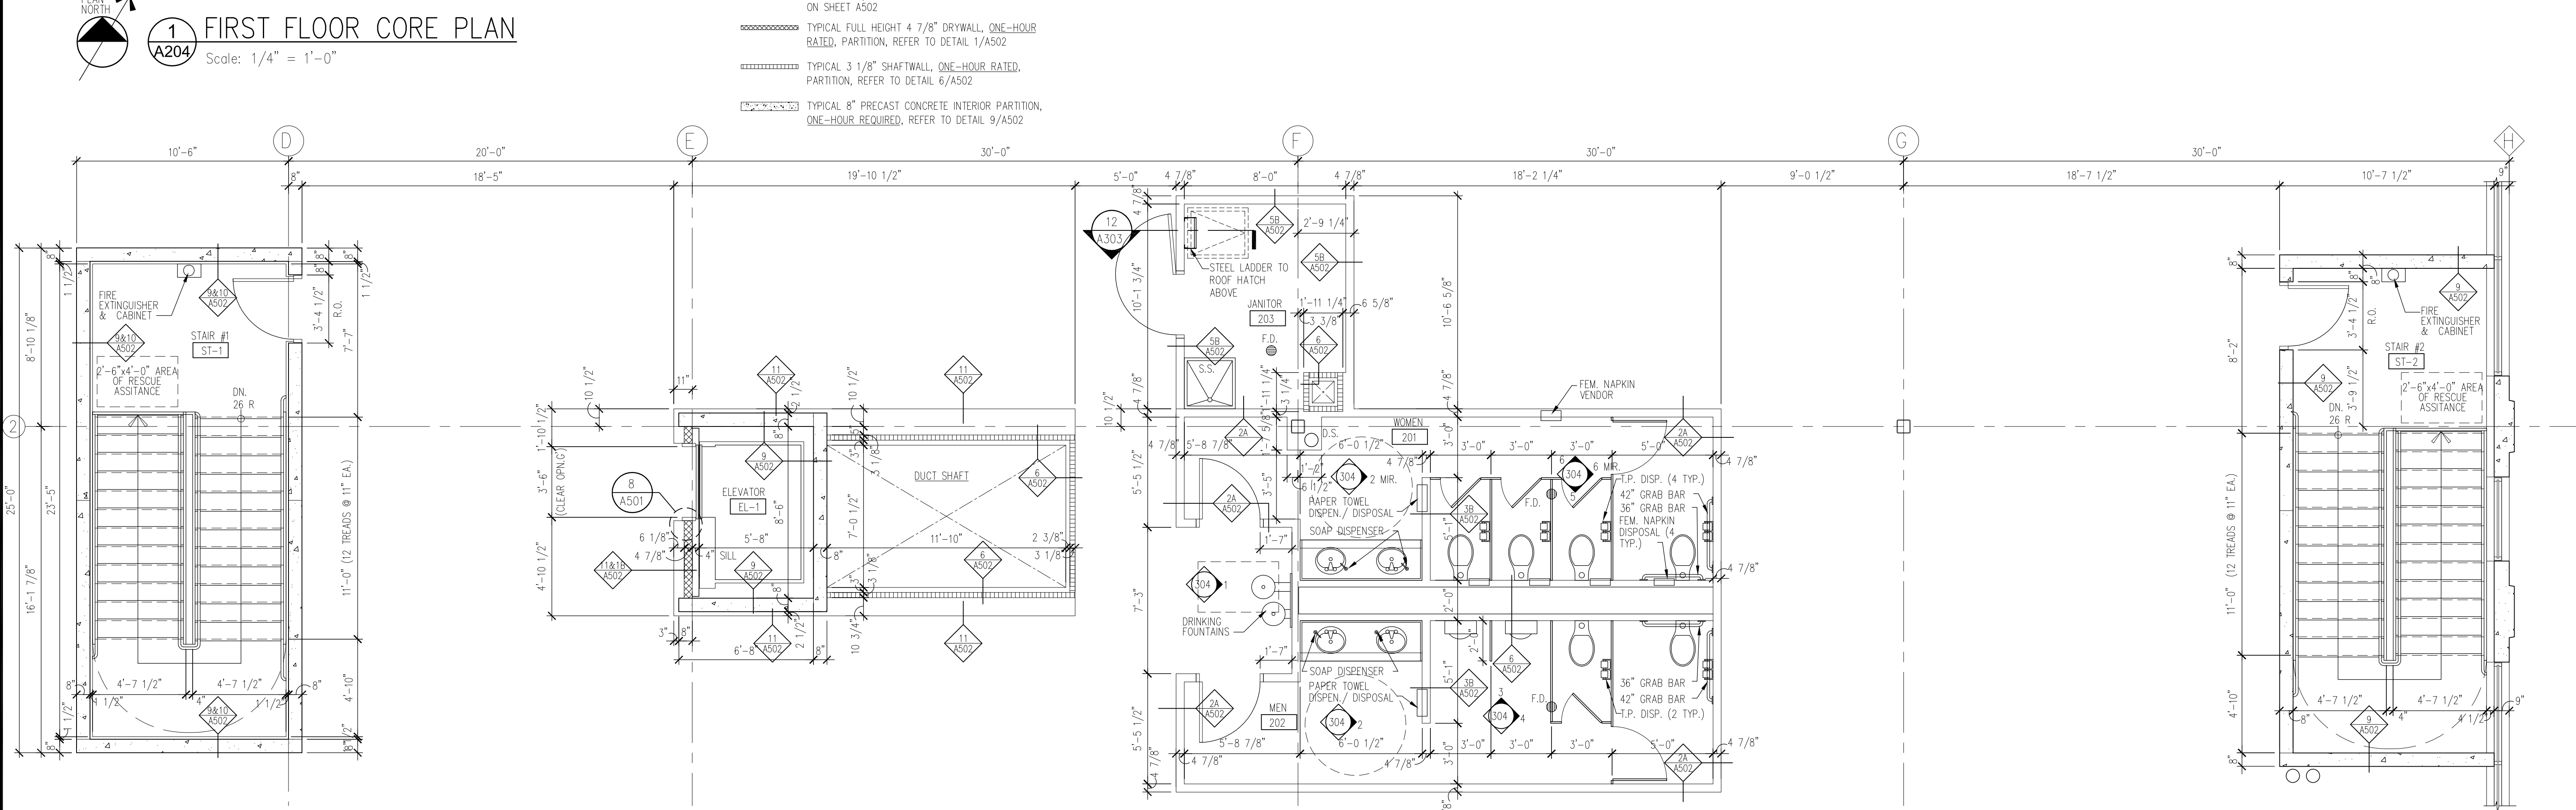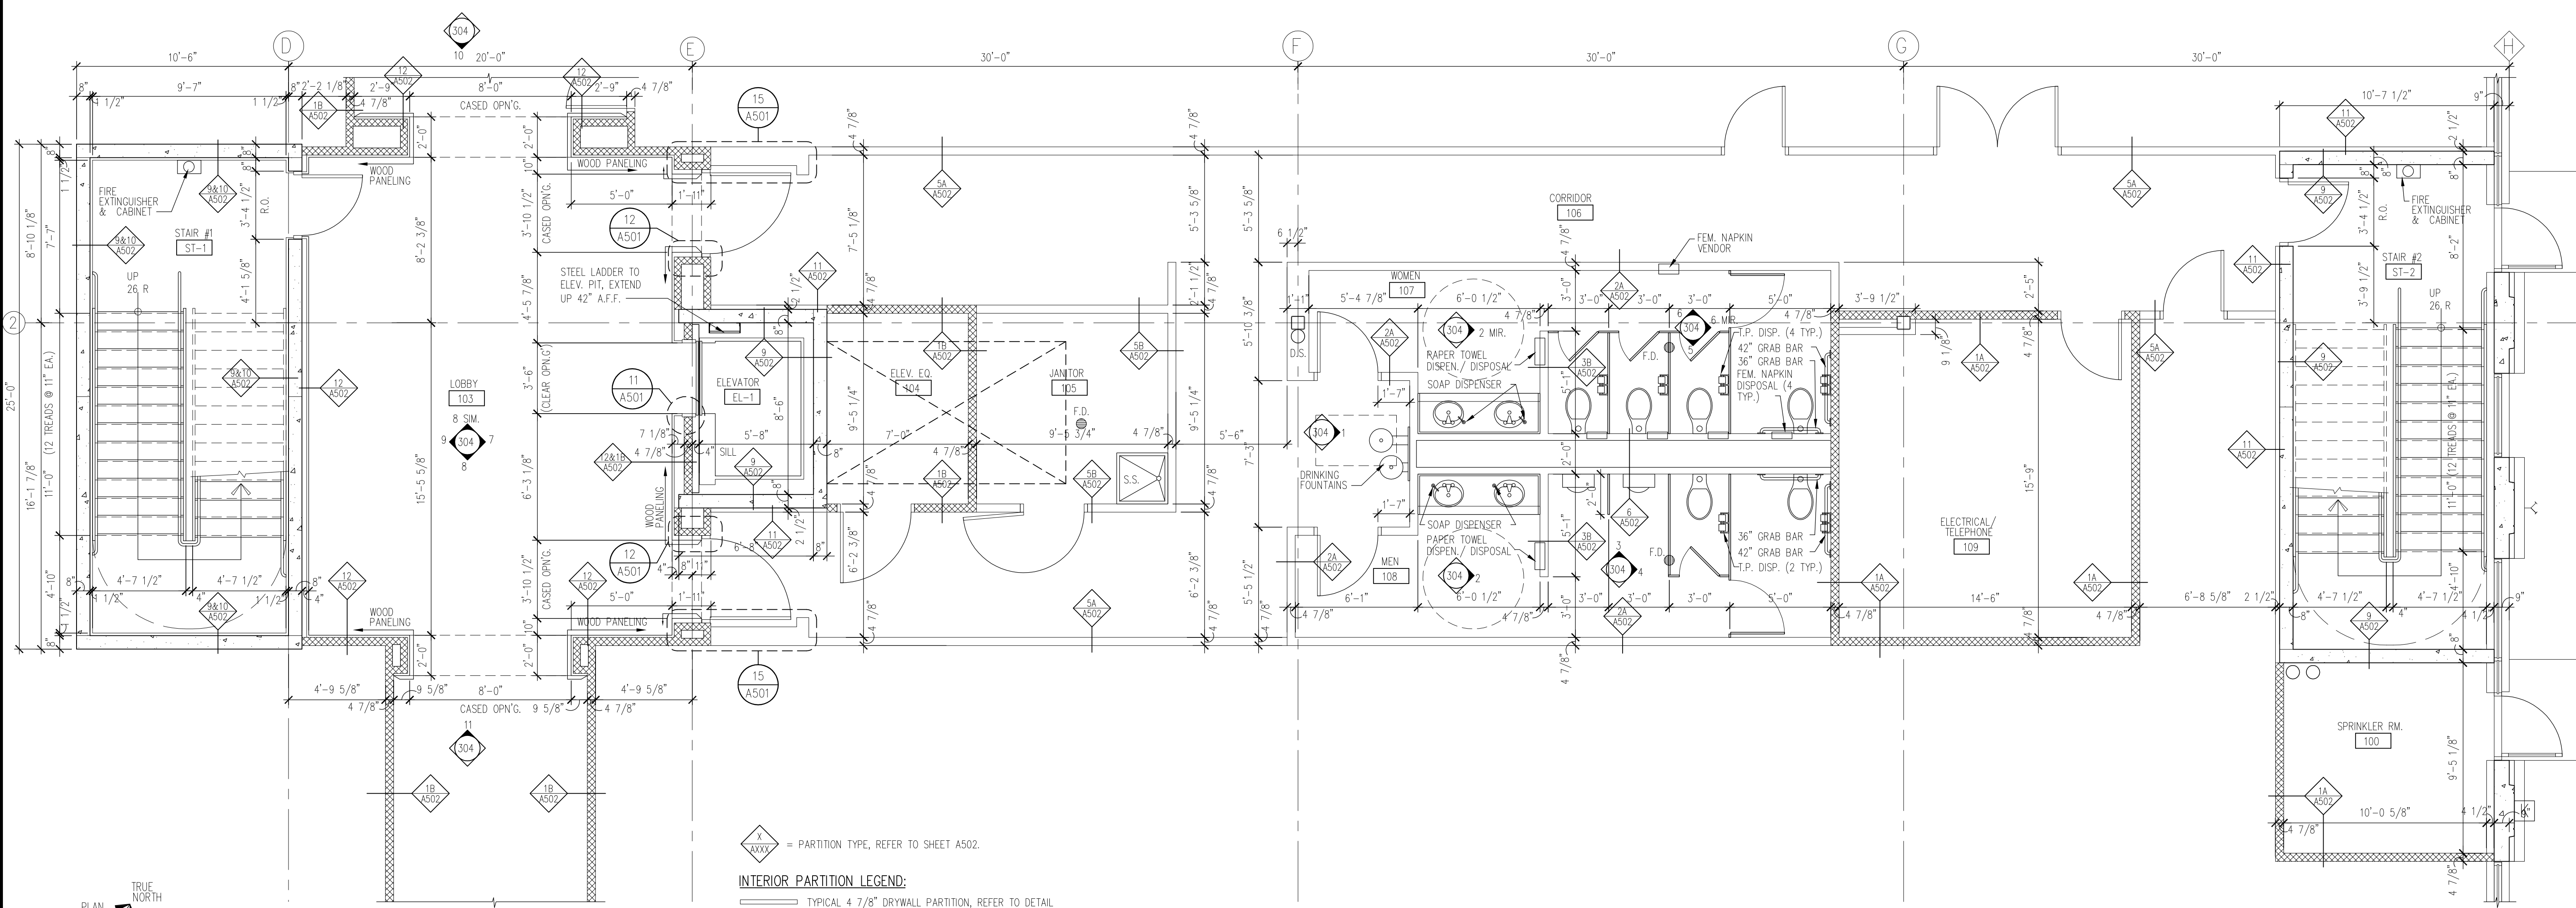

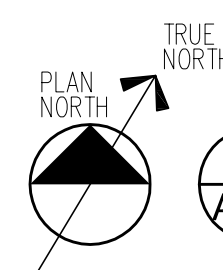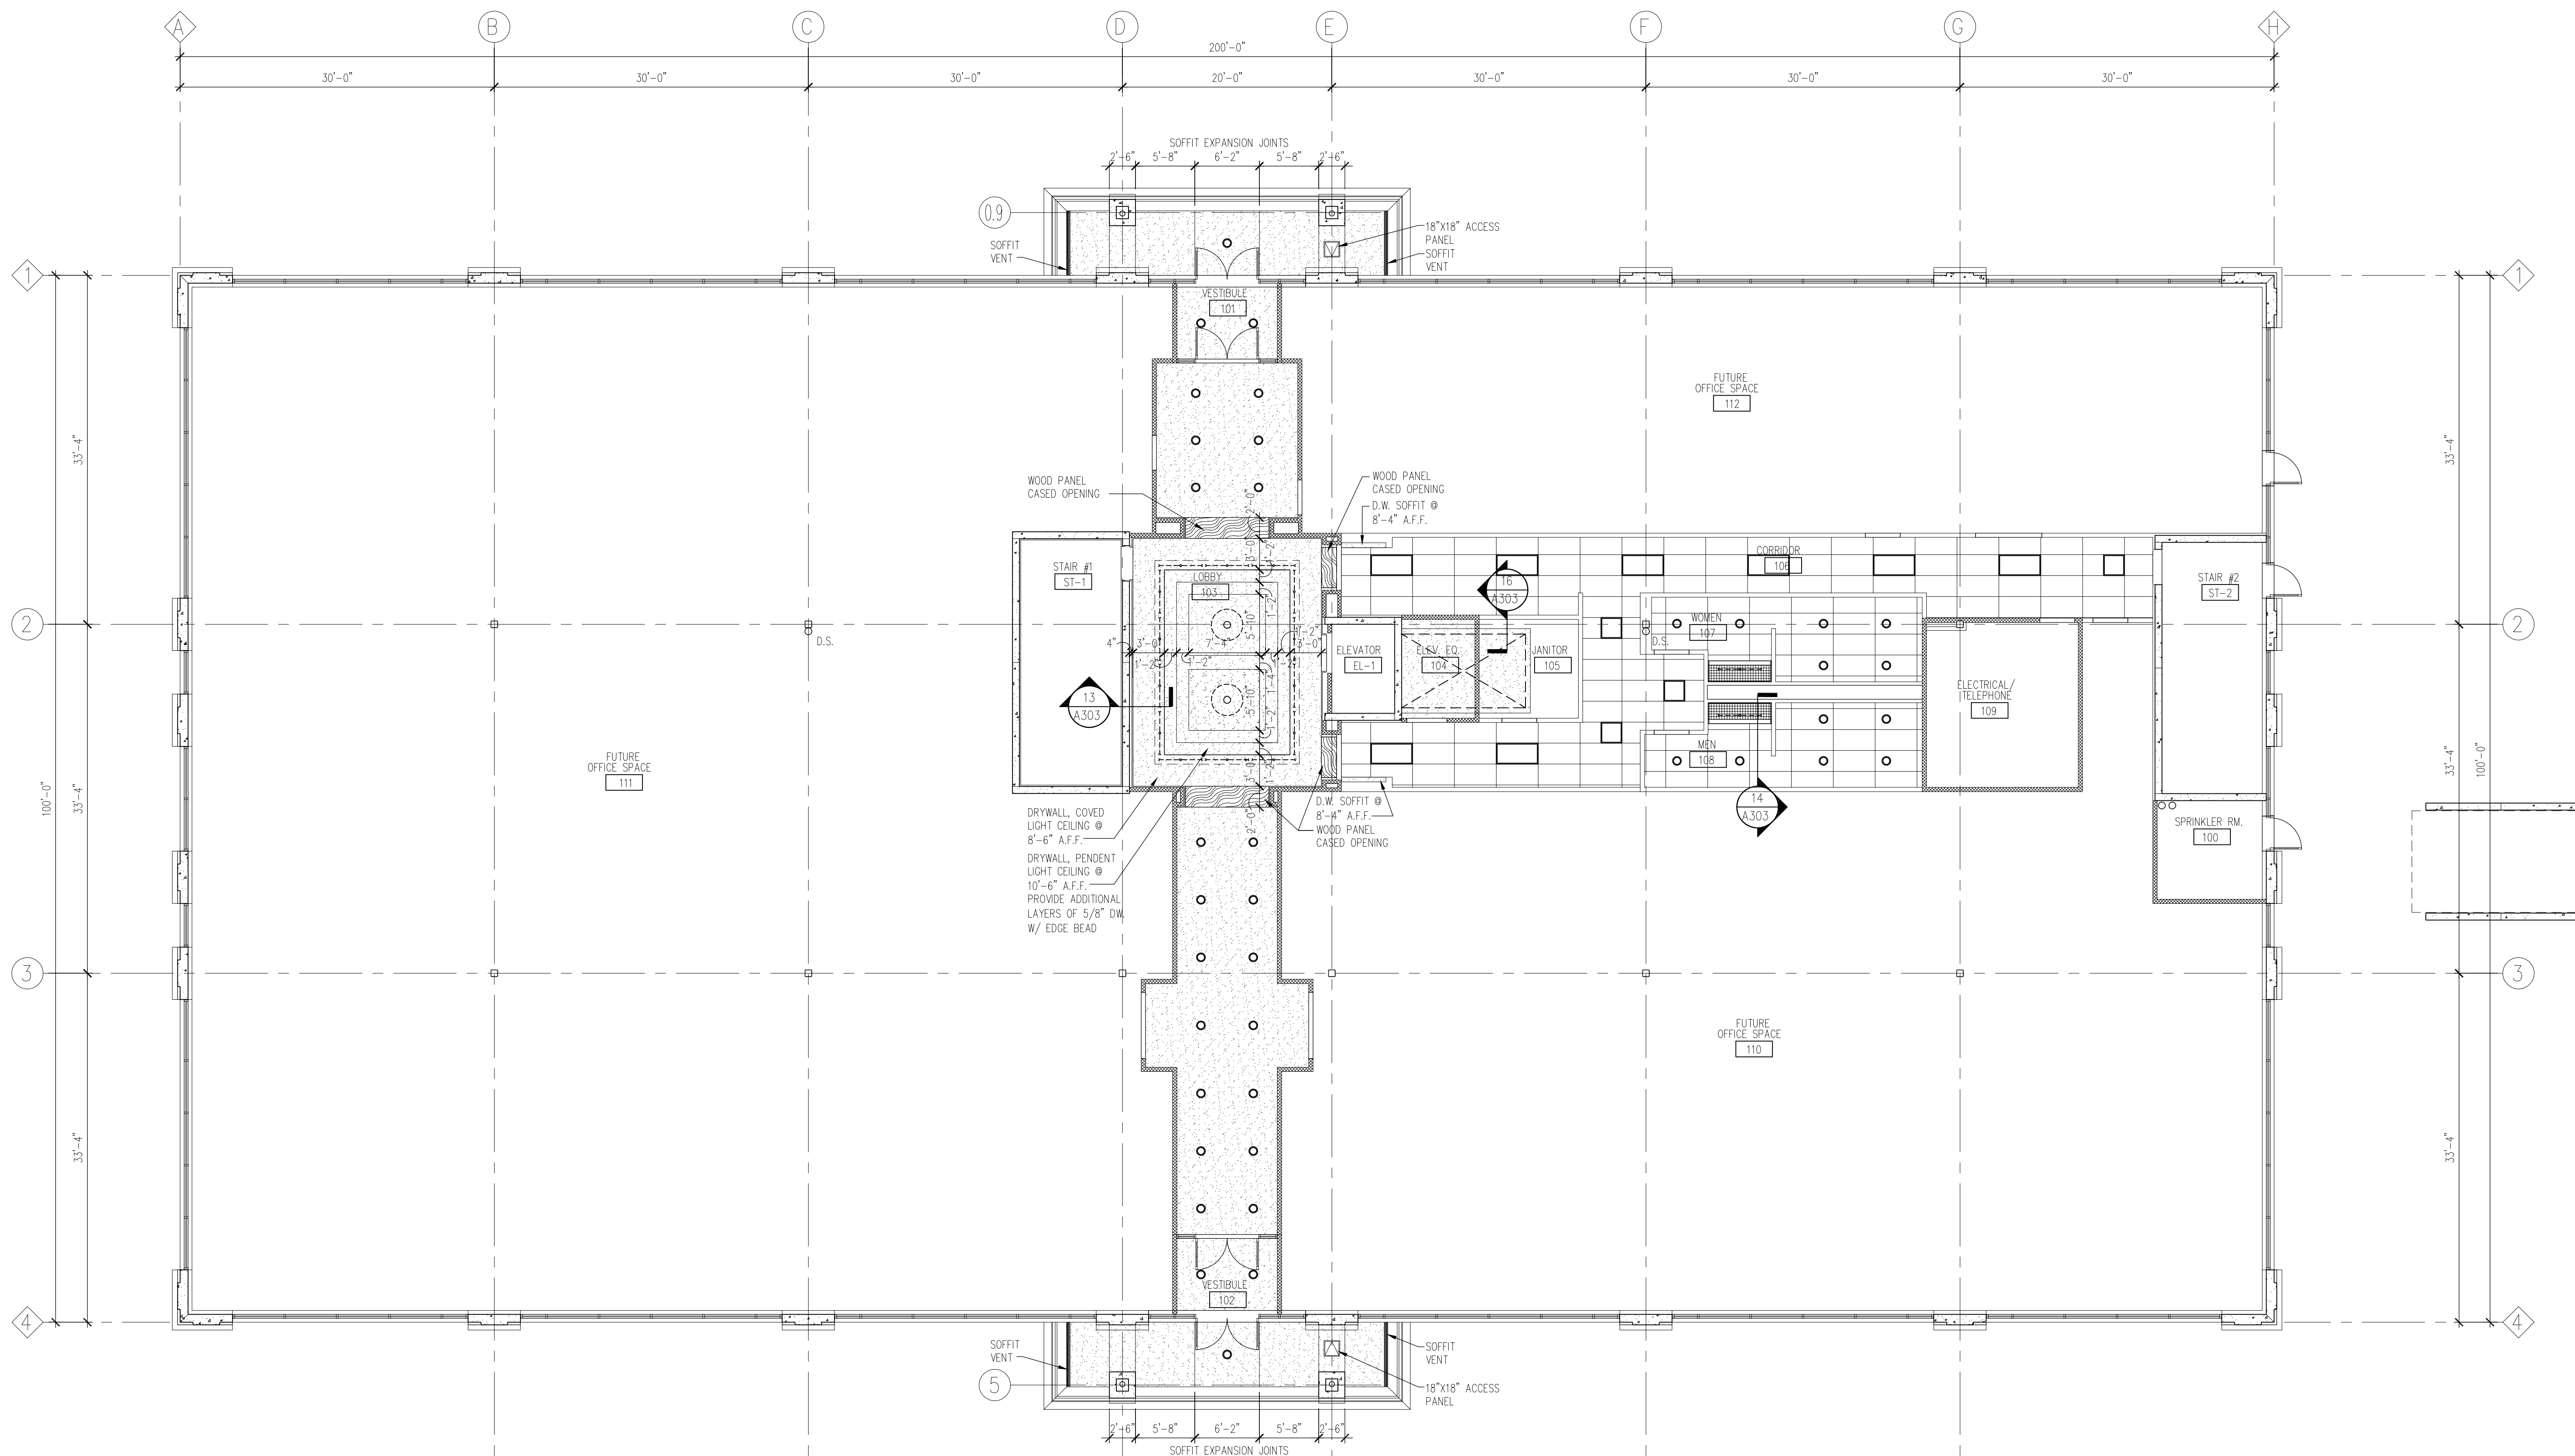



1
A205

FIRST FLOOR REFLECTED CEILING PLAN

Scale: 1/8" = 1'-0"

LEGEND:

- 2x4 FLUORESCENT LIGHT FIXTURE
- 2x2 FLUORESCENT LIGHT FIXTURE
- FLUORESCENT DOWNLIGHT FIXTURE
- DECORATIVE PENDANT LIGHT
- PROVIDE SUPPORT FRAMING FOR 200LB. MIN. LOAD
- STRIP FLUORESCENT FIXTURE

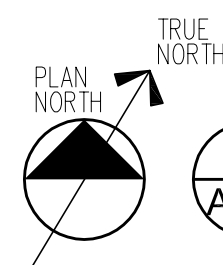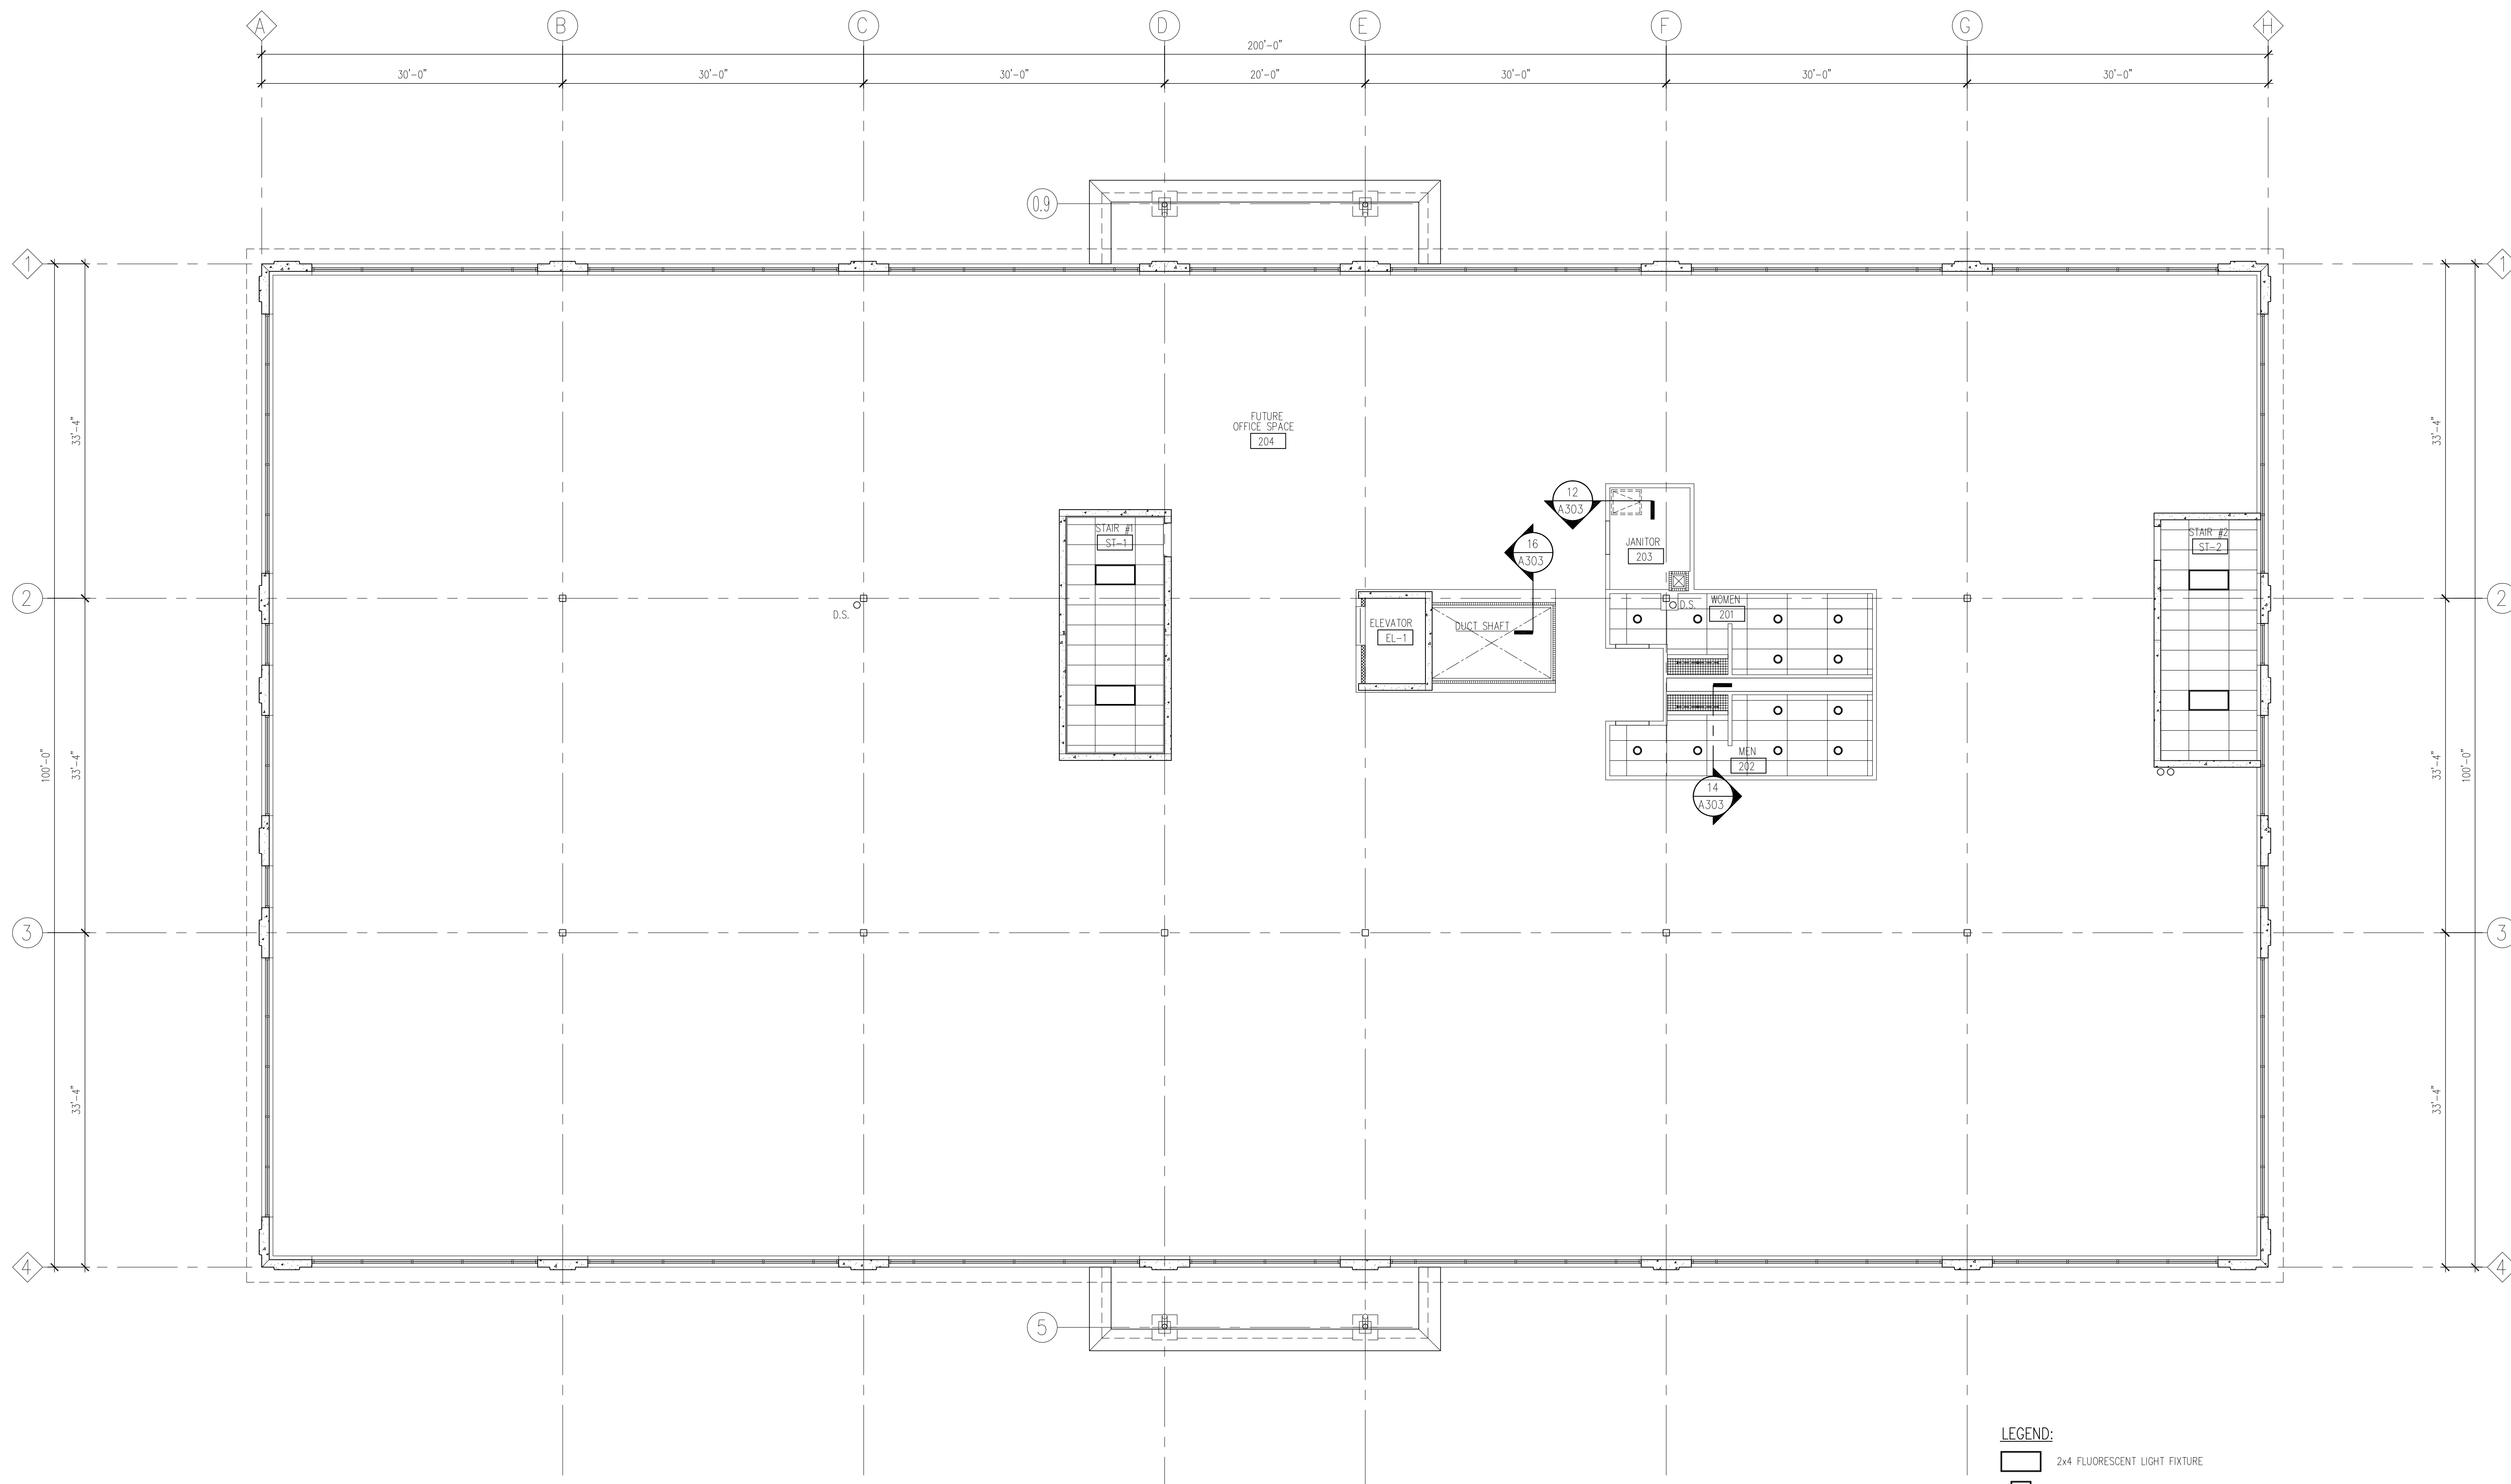




1
A202


SECOND FLOOR PLAN

Scale: 1/8" = 1'-0"


LEGEND:

- 2x4 FLUORESCENT LIGHT FIXTURE
- 2x2 FLUORESCENT LIGHT FIXTURE
- FLUORESCENT DOWNLIGHT FIXTURE
- DECORATIVE PENDENT LIGHT
PROVIDE SUPPORT FRAMING FOR
200LB. MIN. LOAD
- STRIP FLUORESCENT FIXTURE

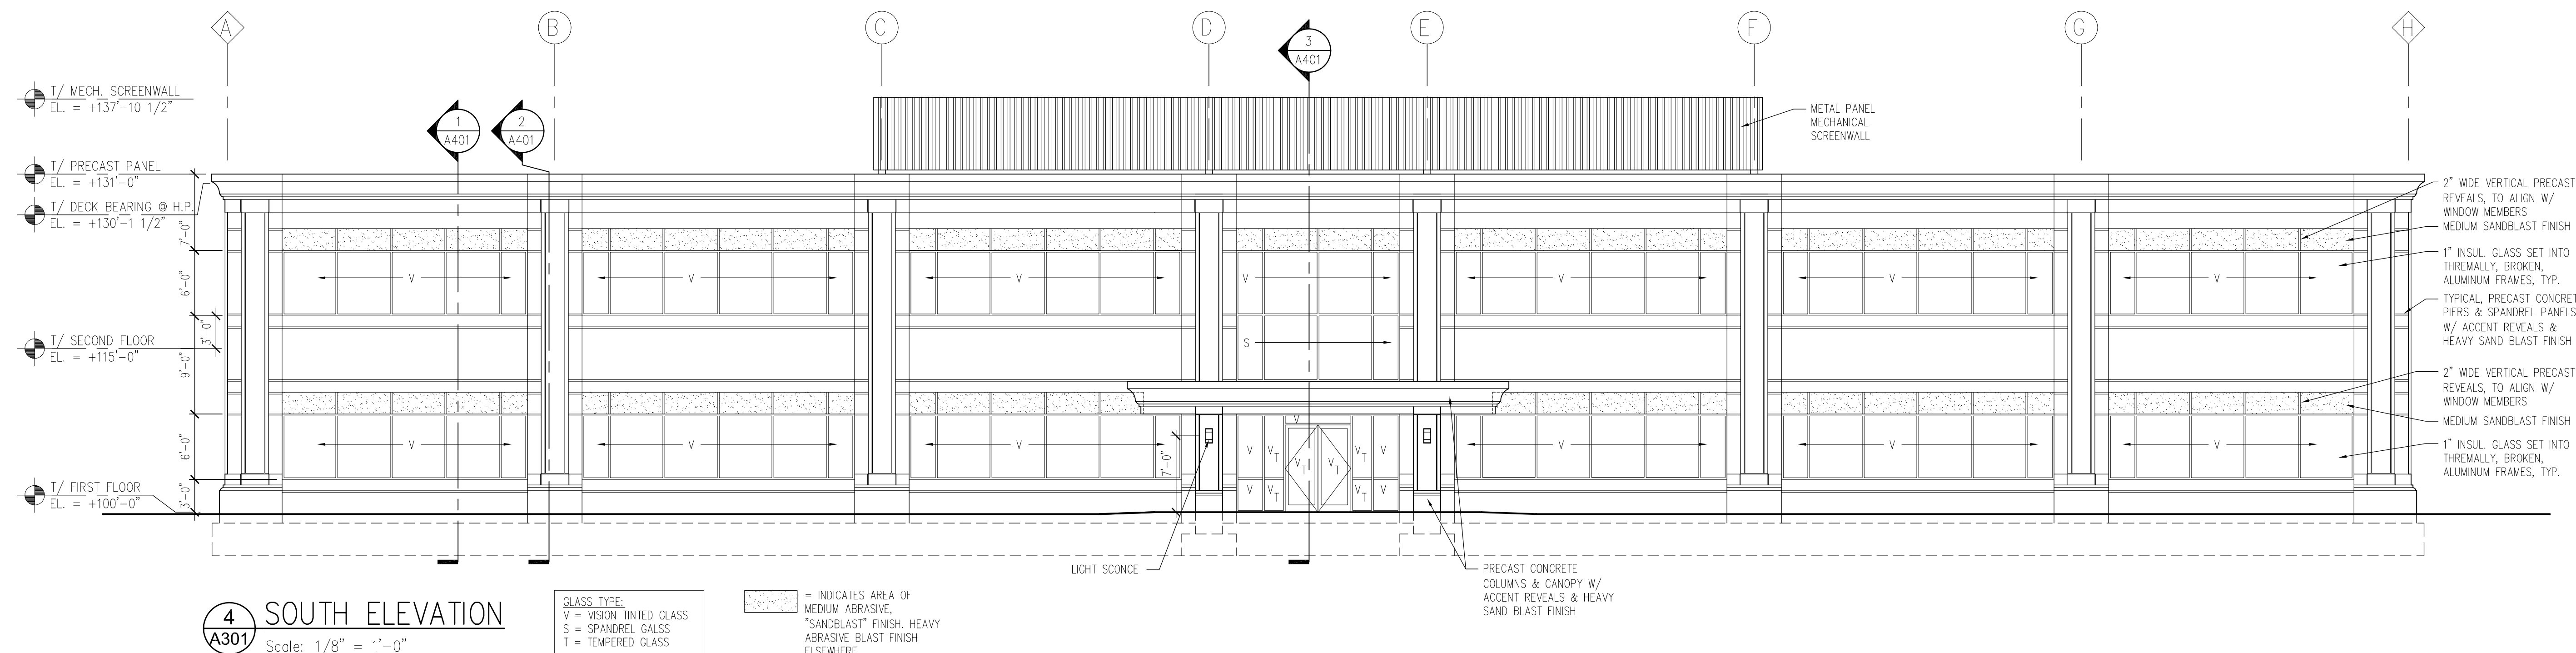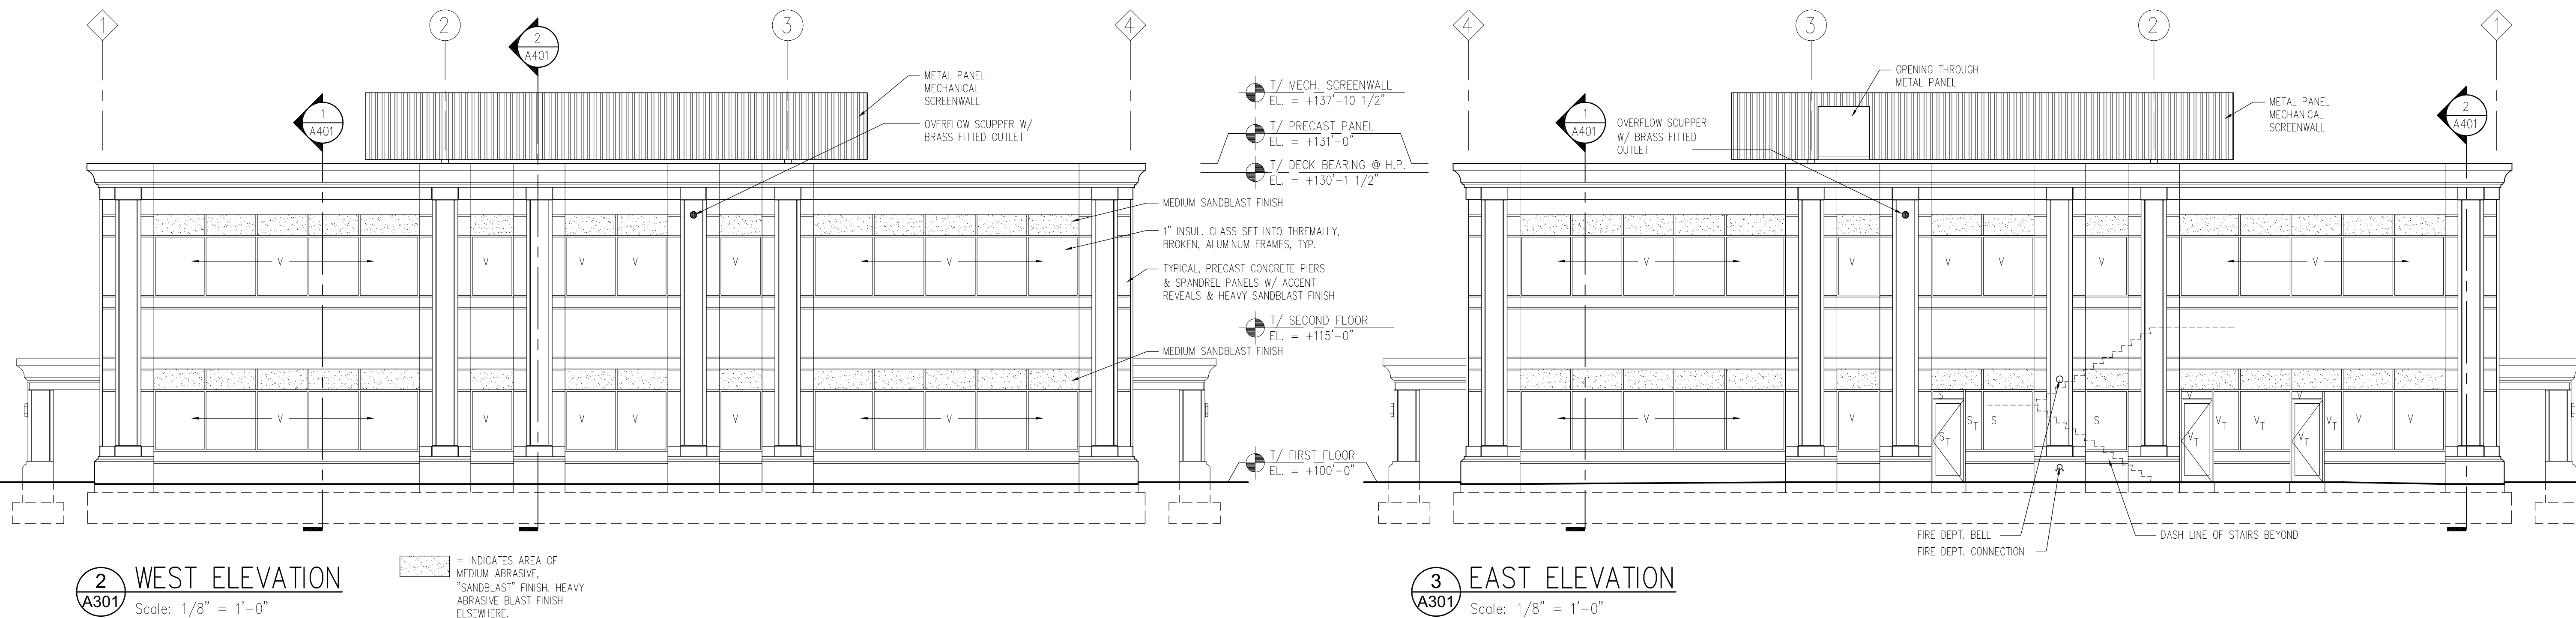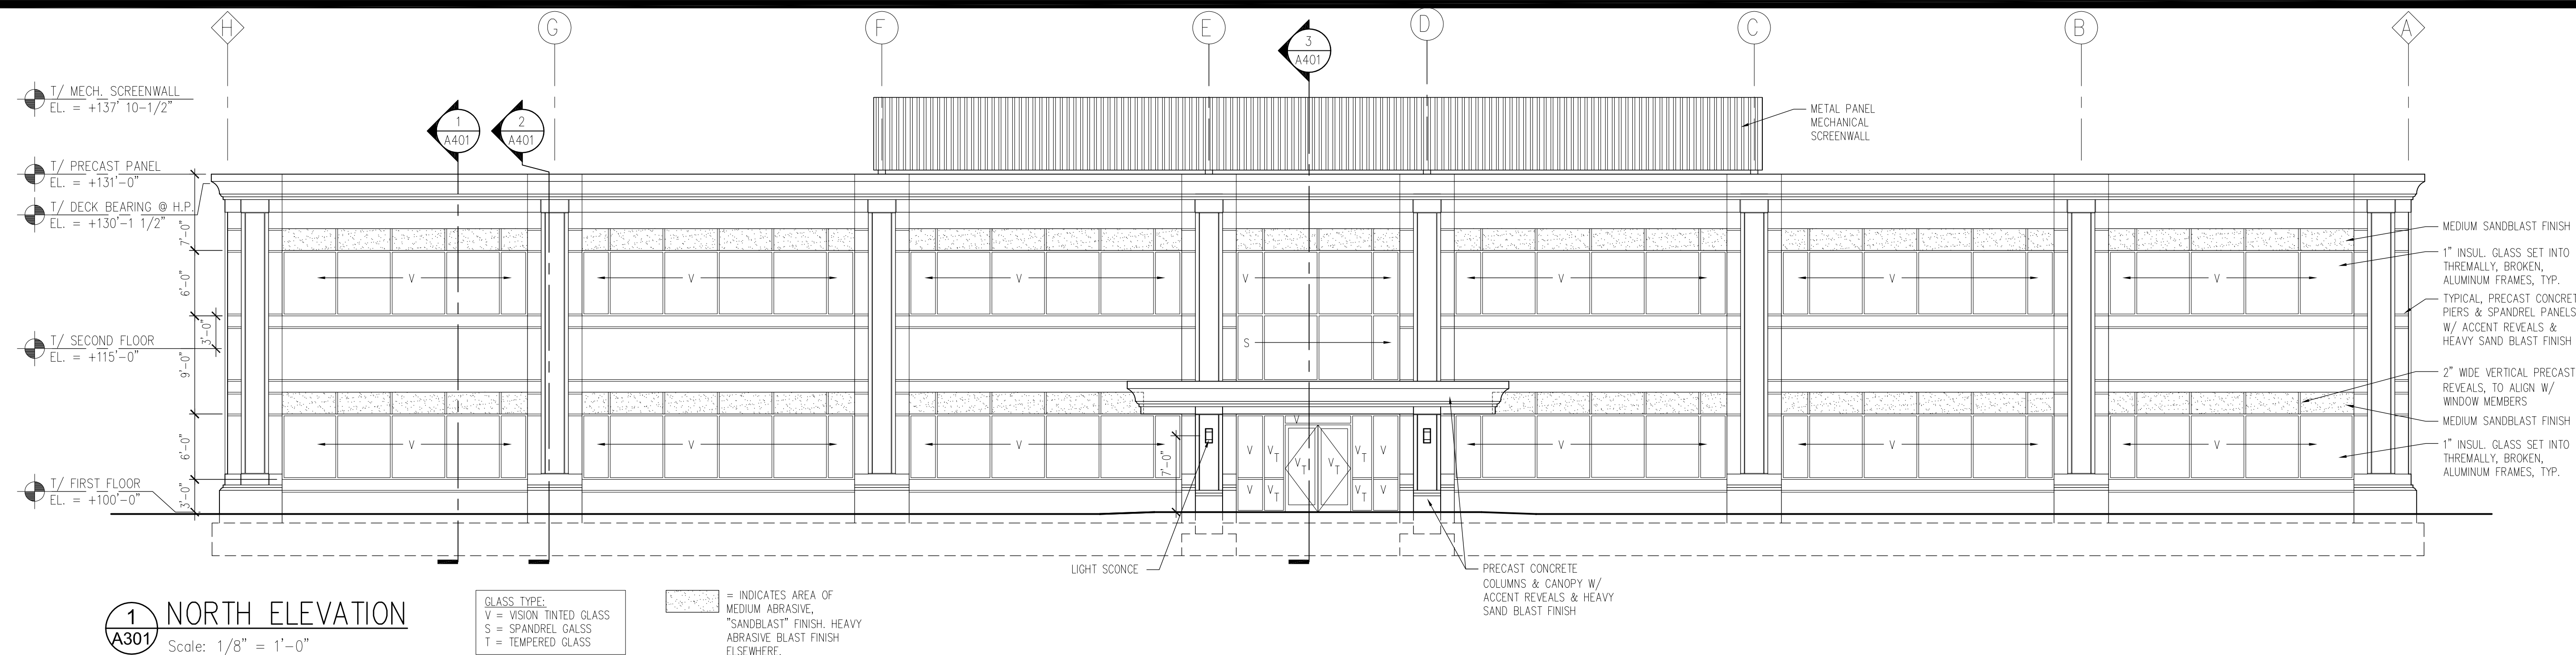


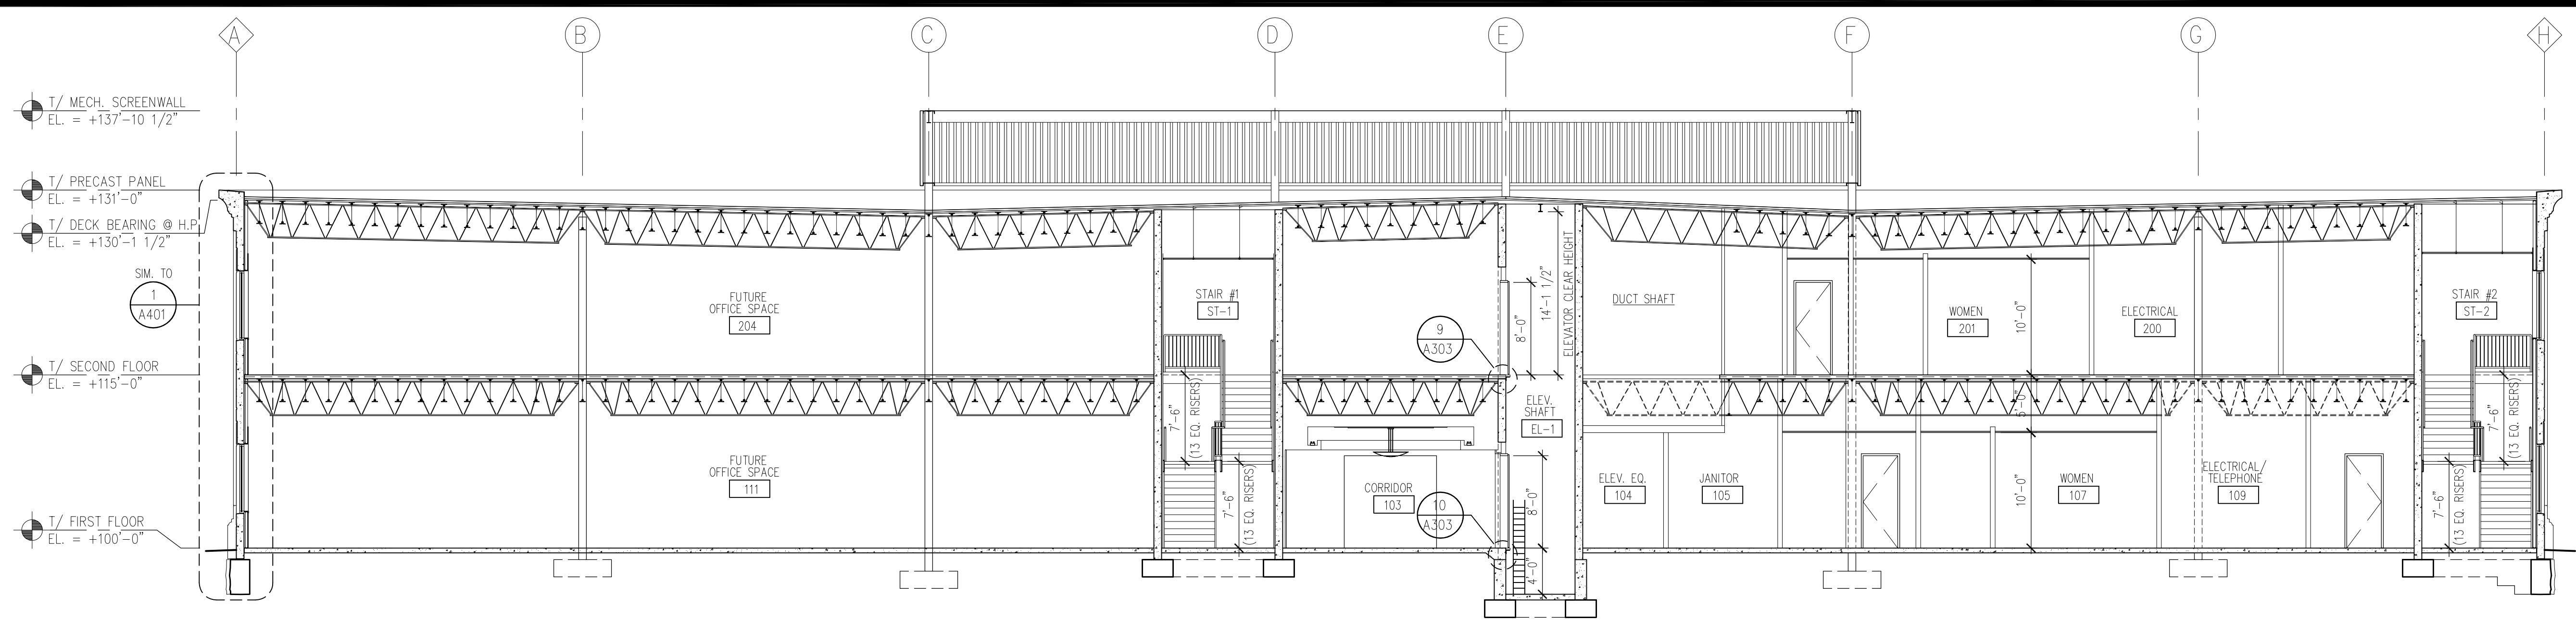


1 BUILDING SECTION
Scale: 1/8" = 1'-0"

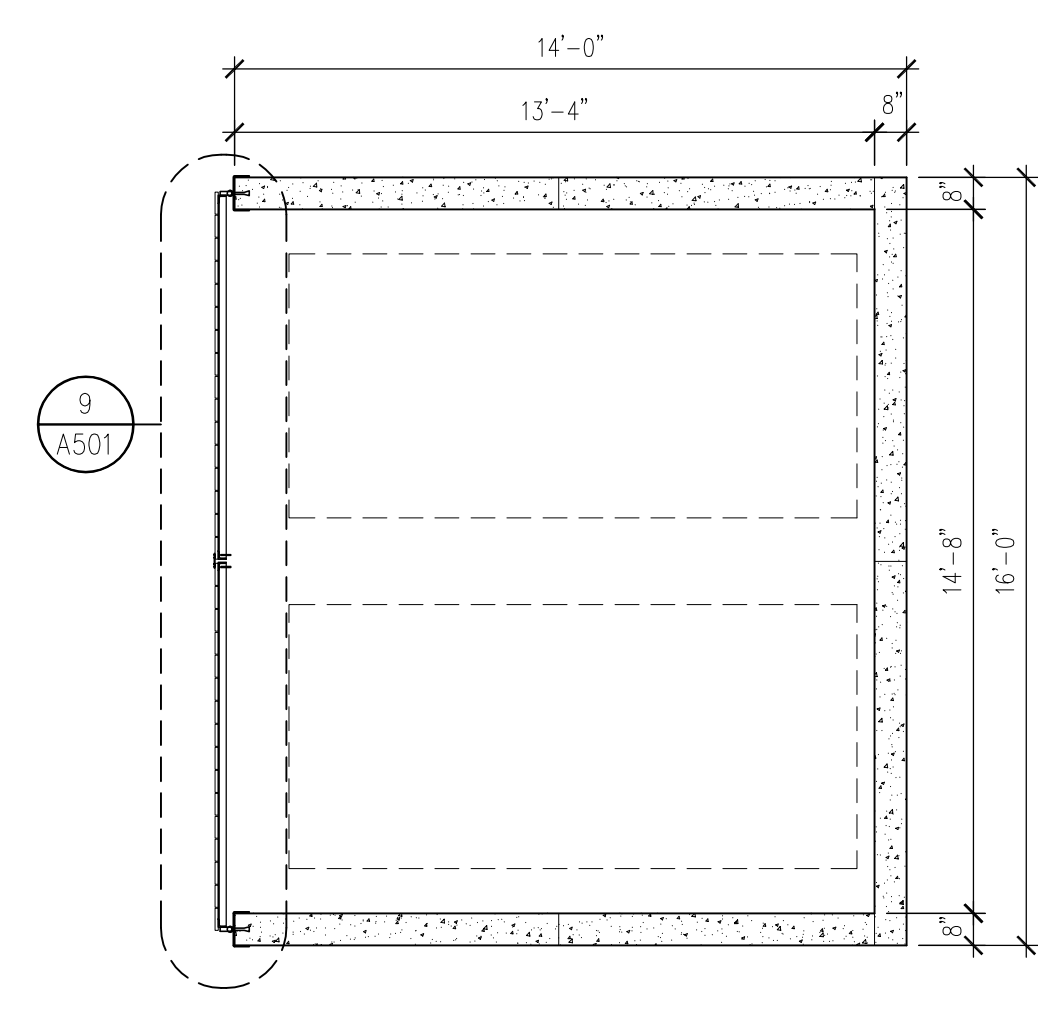


2 TRASH ENCLOSURE PLAN
Scale: 1/4" = 1'-0"

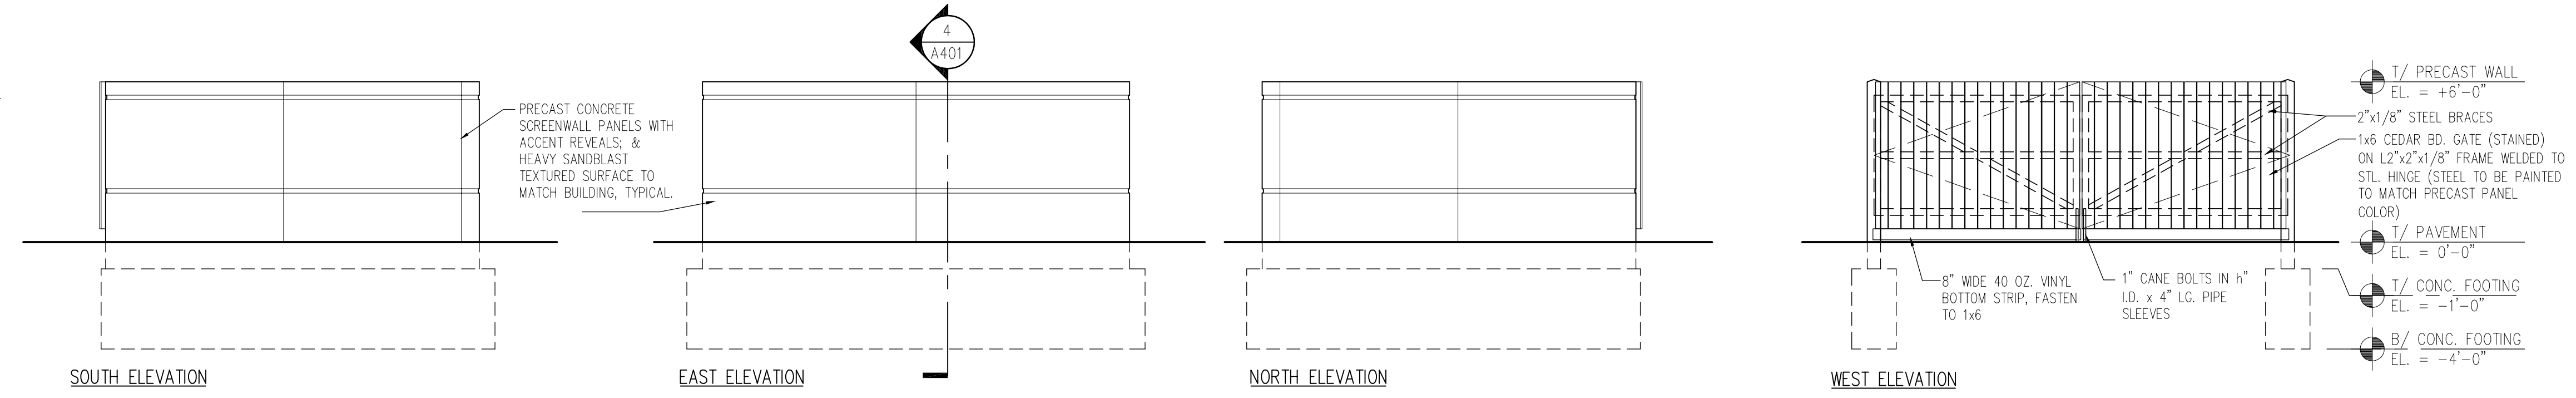


3 TRASH ENCLOSURE EXTERIOR ELEVATIONS
Scale: 1/4" = 1'-0"

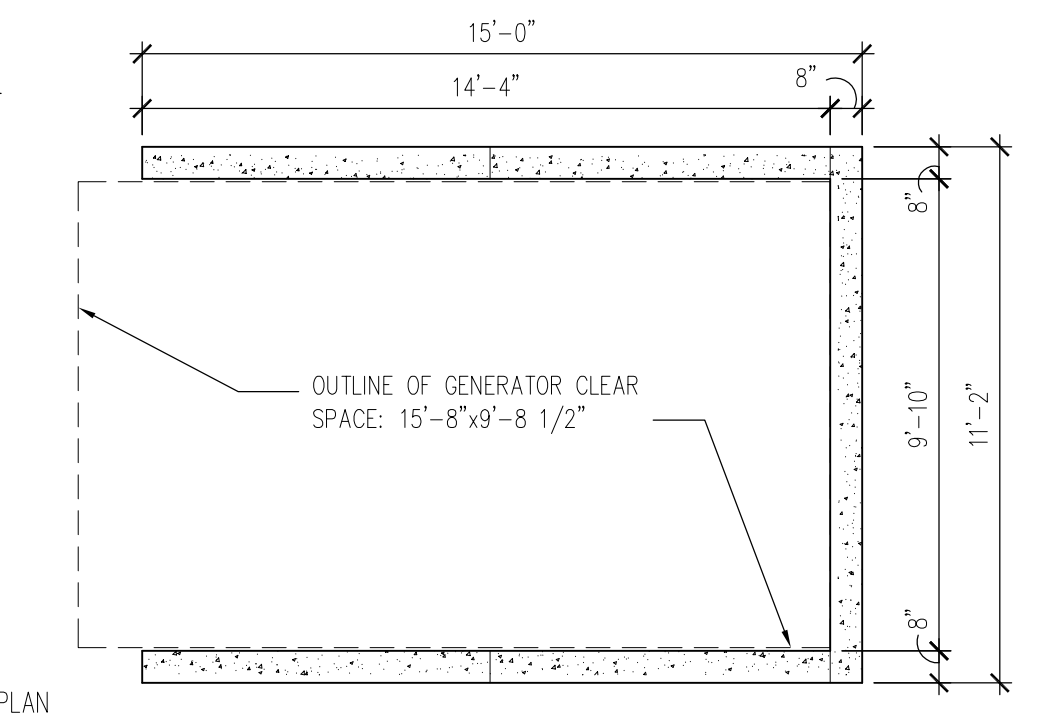















4 GEN. ENCLOSURE PLAN
Scale: 1/4" = 1'-0"

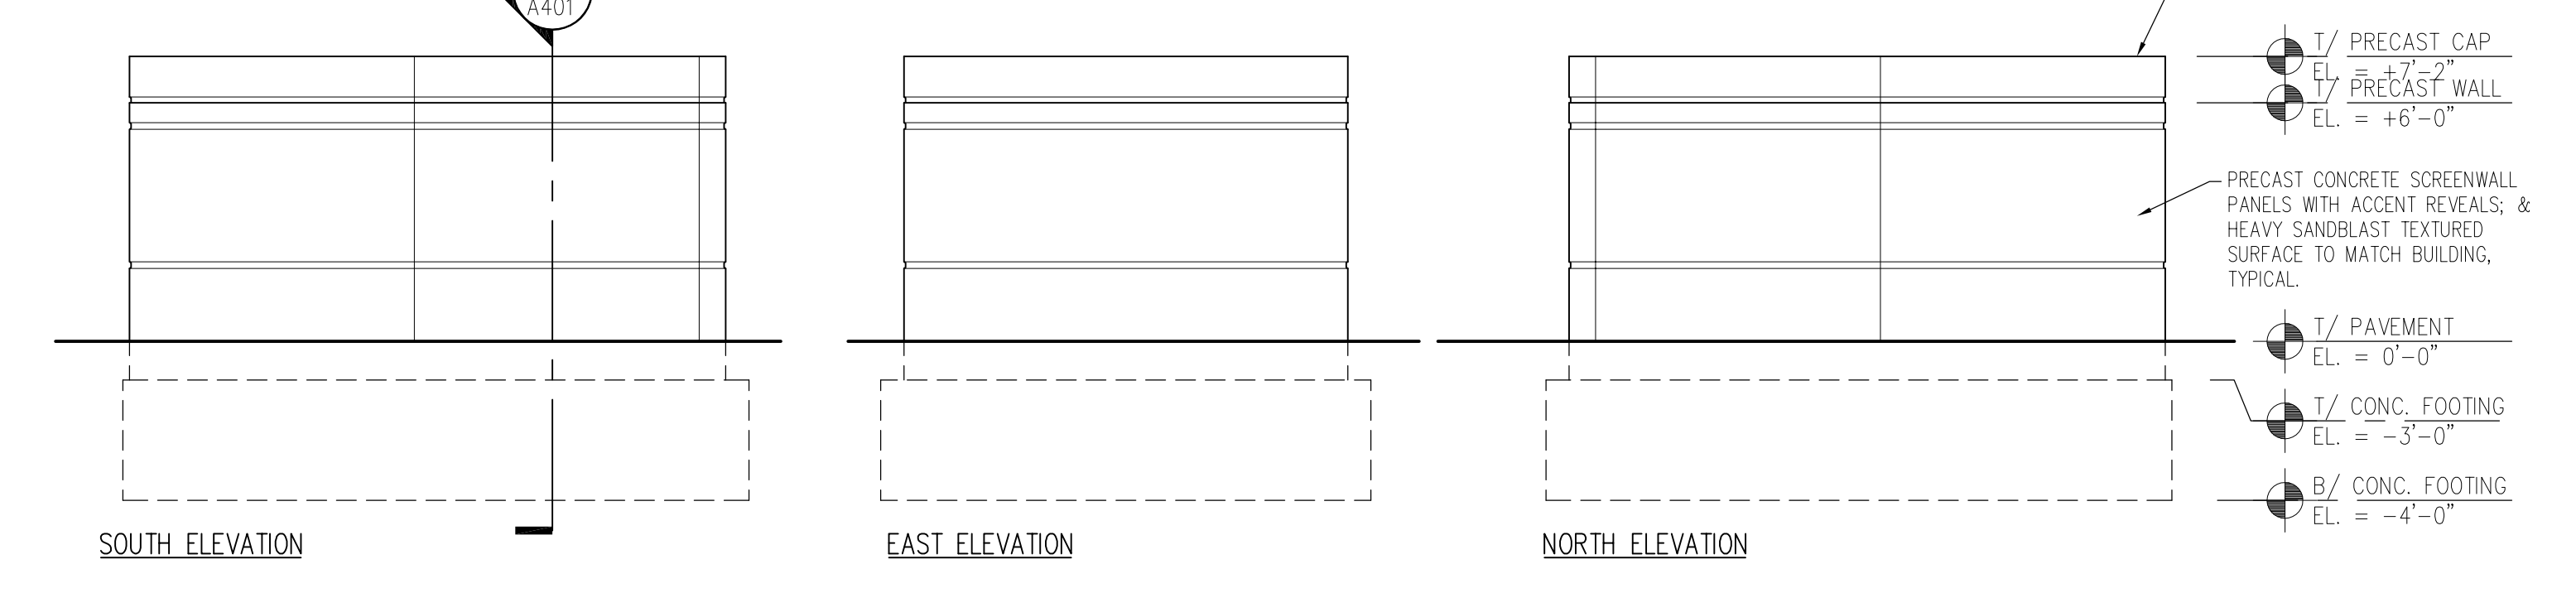

5 GENERATOR ENCLOSURE EXTERIOR ELEVATIONS
Scale: 1/4" = 1'-0"

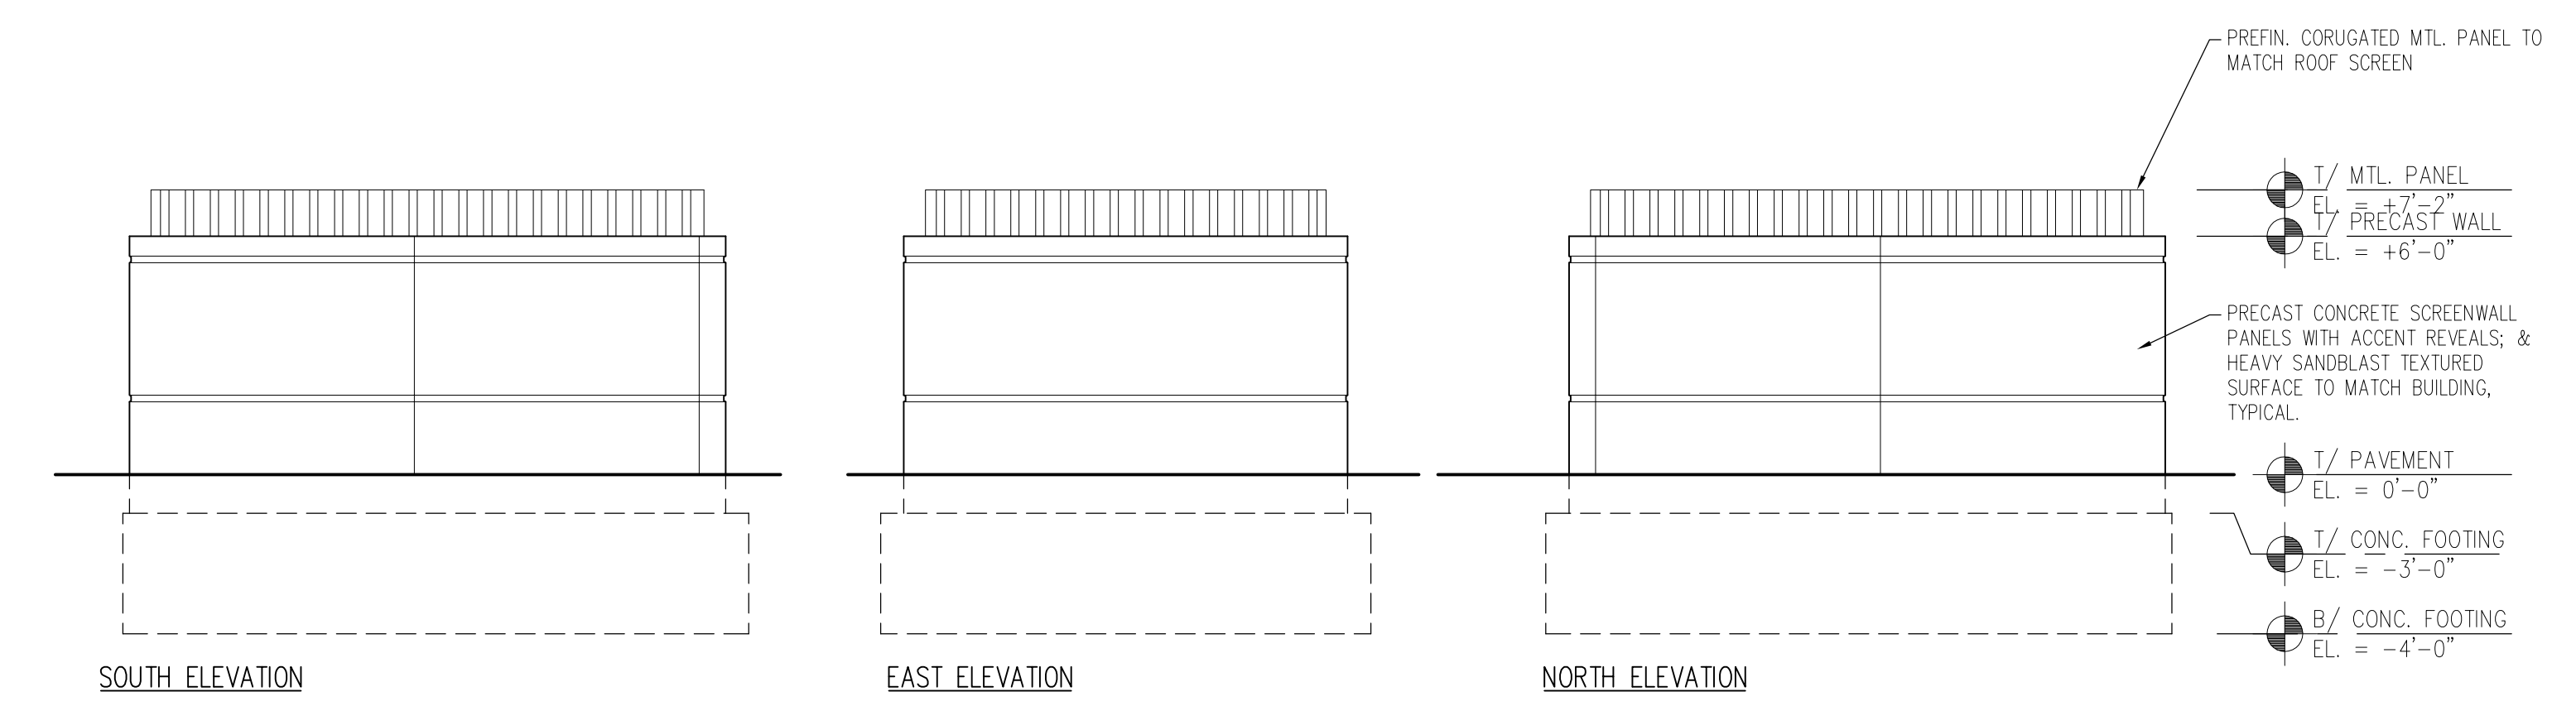

5 ALT. GENERATOR ENCLOSURE EXTERIOR ELEVATIONS
Scale: 1/4" = 1'-0"

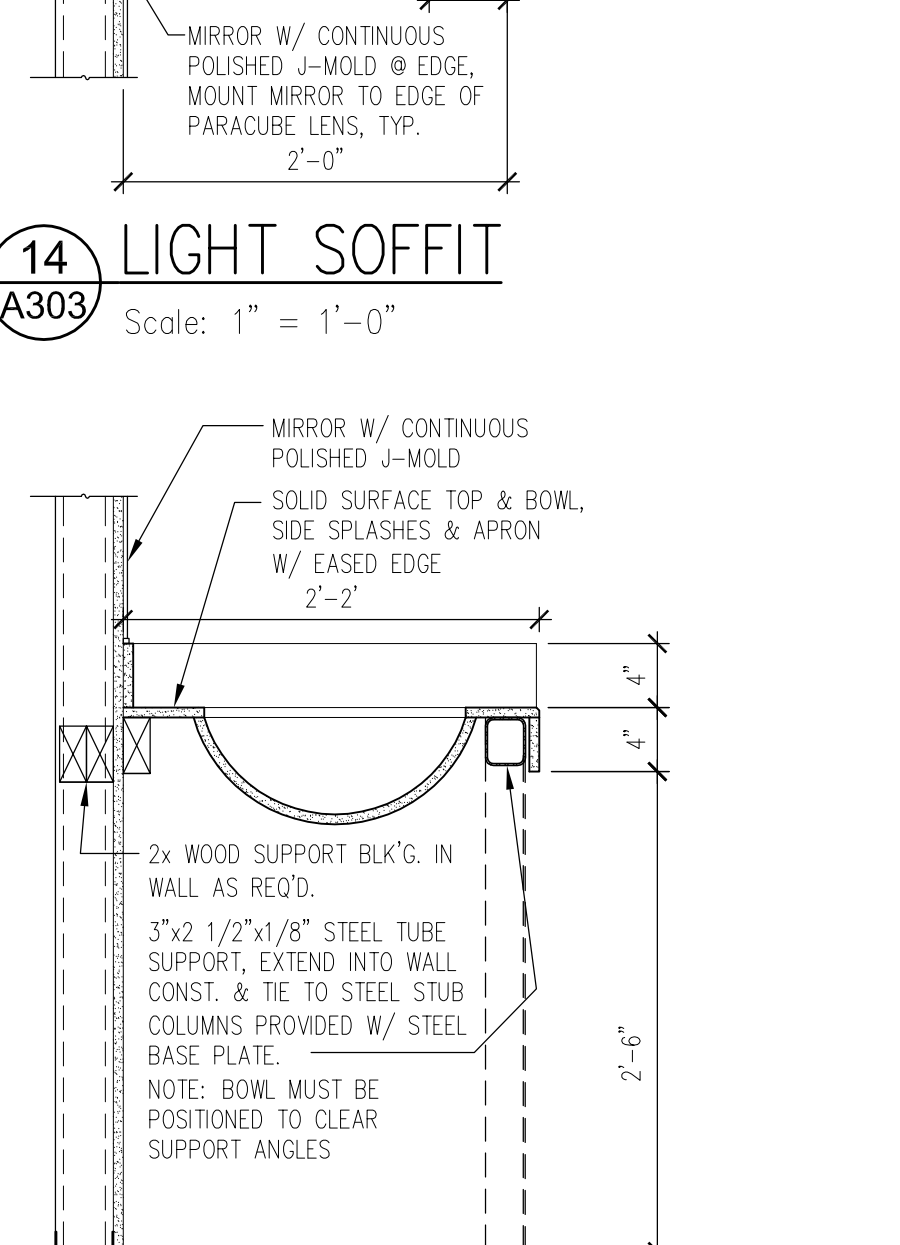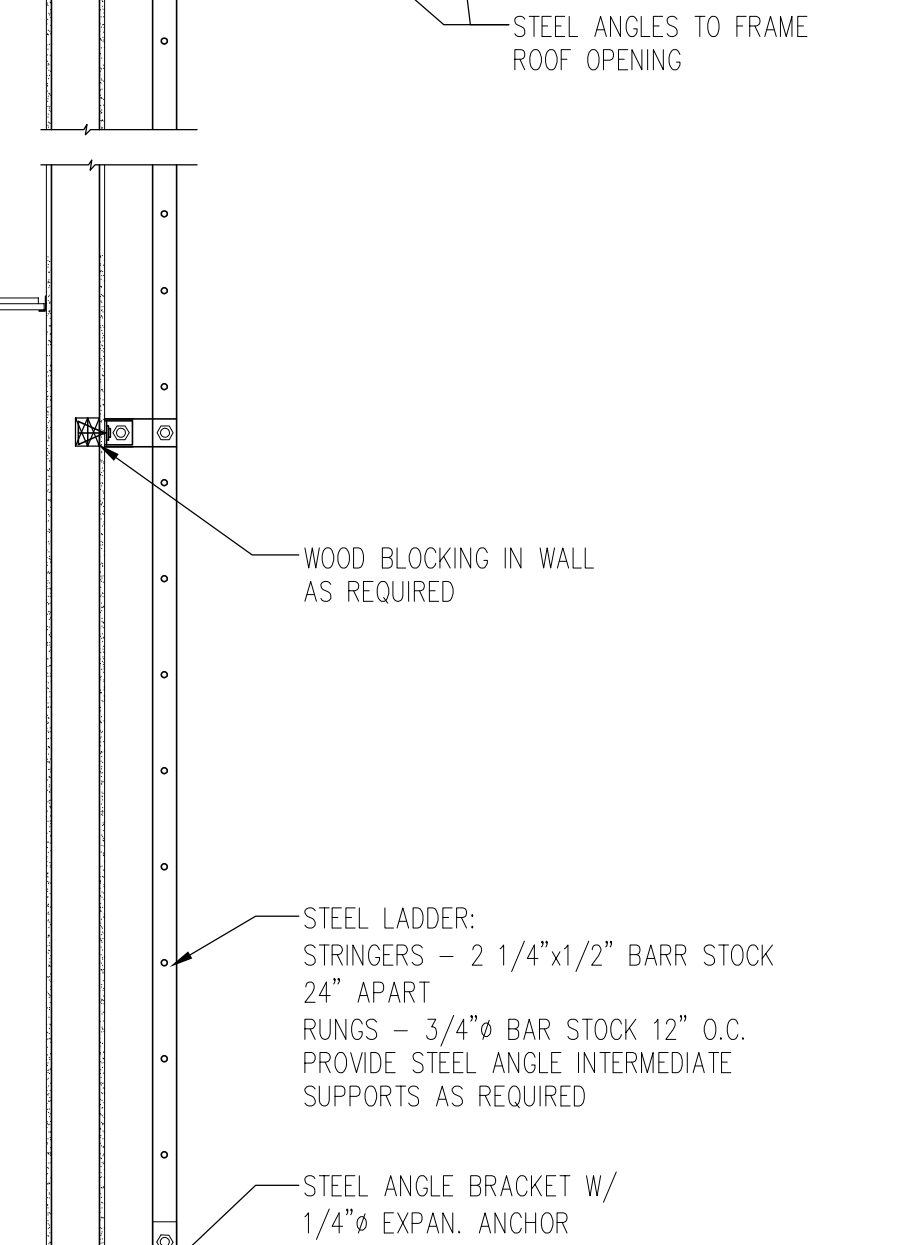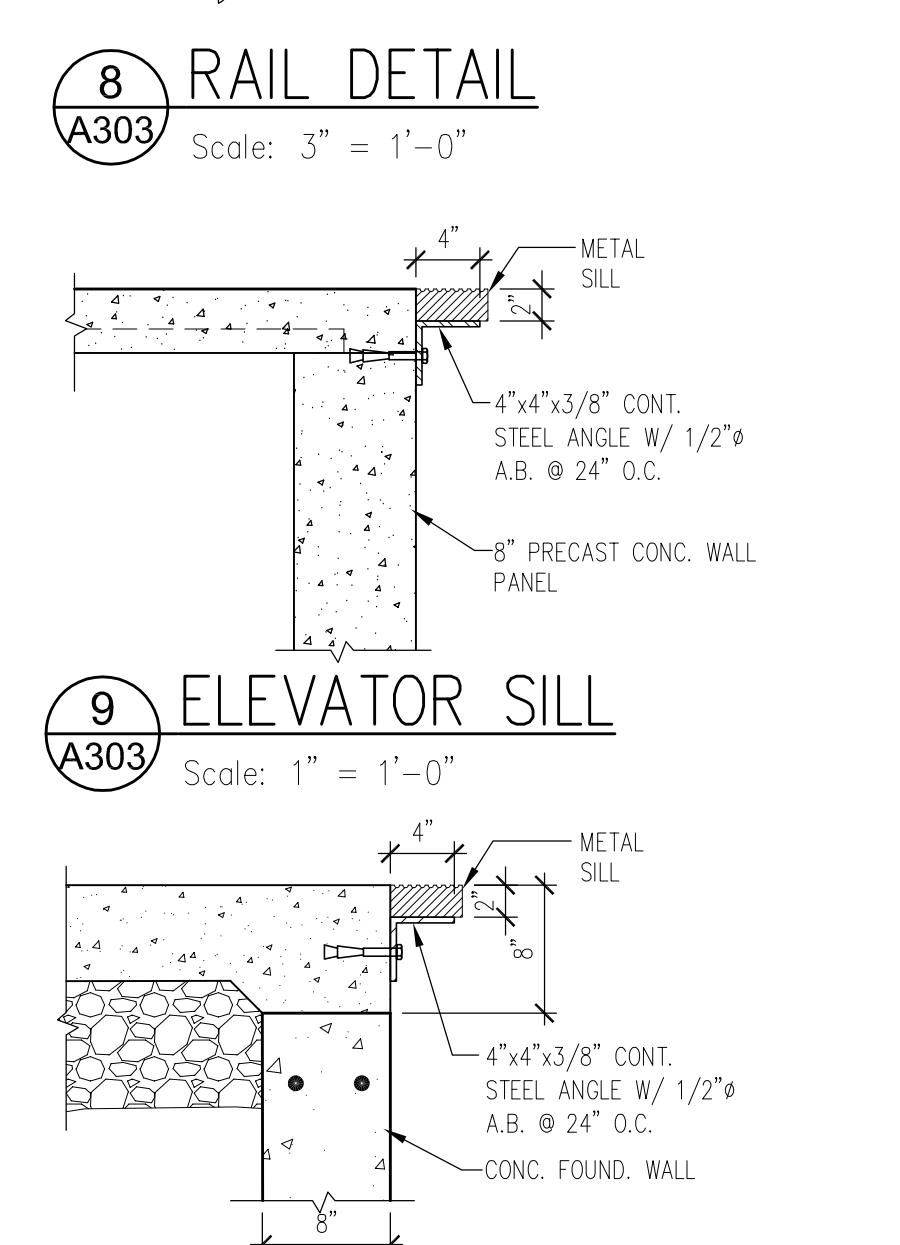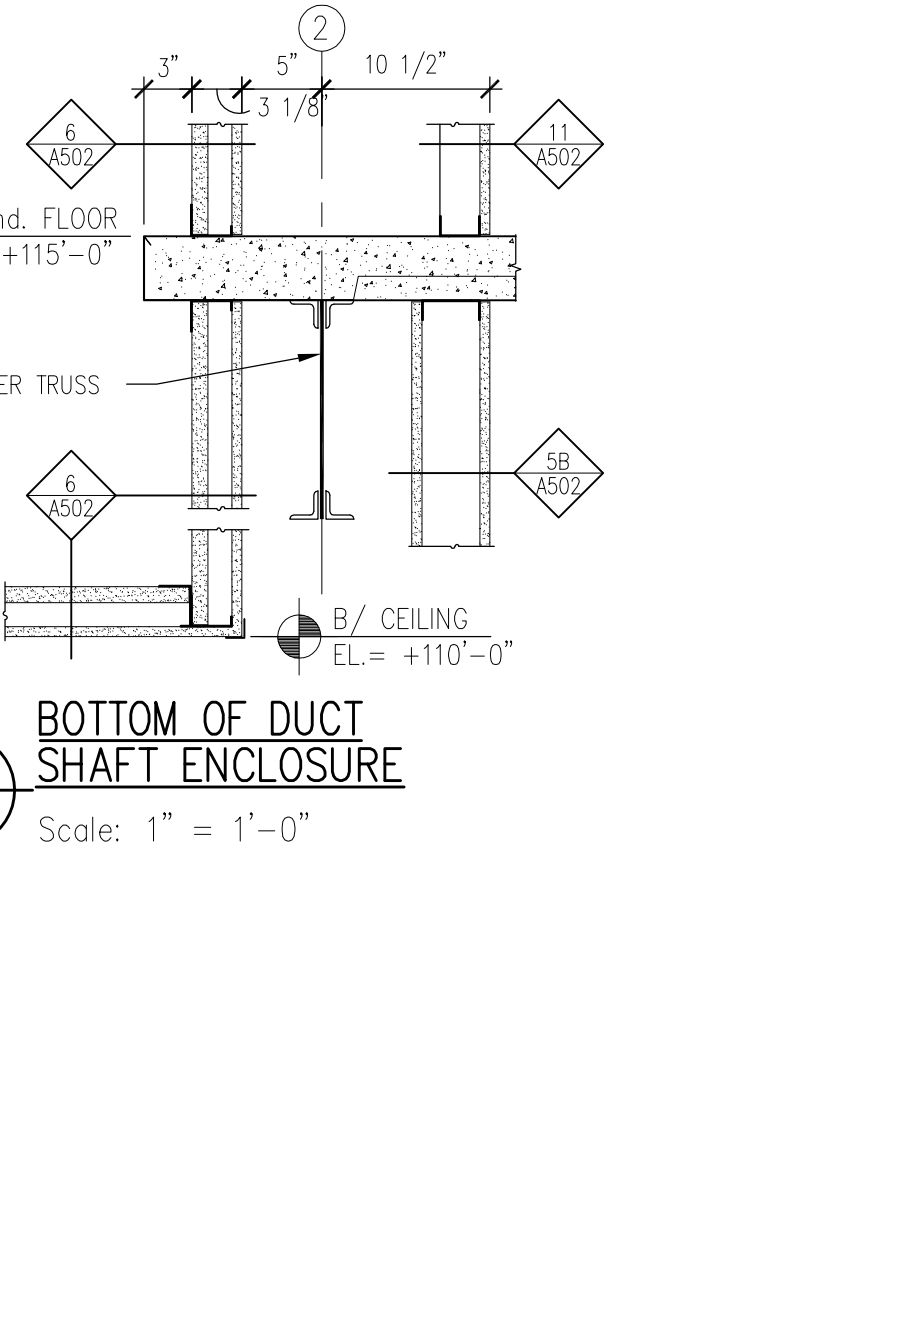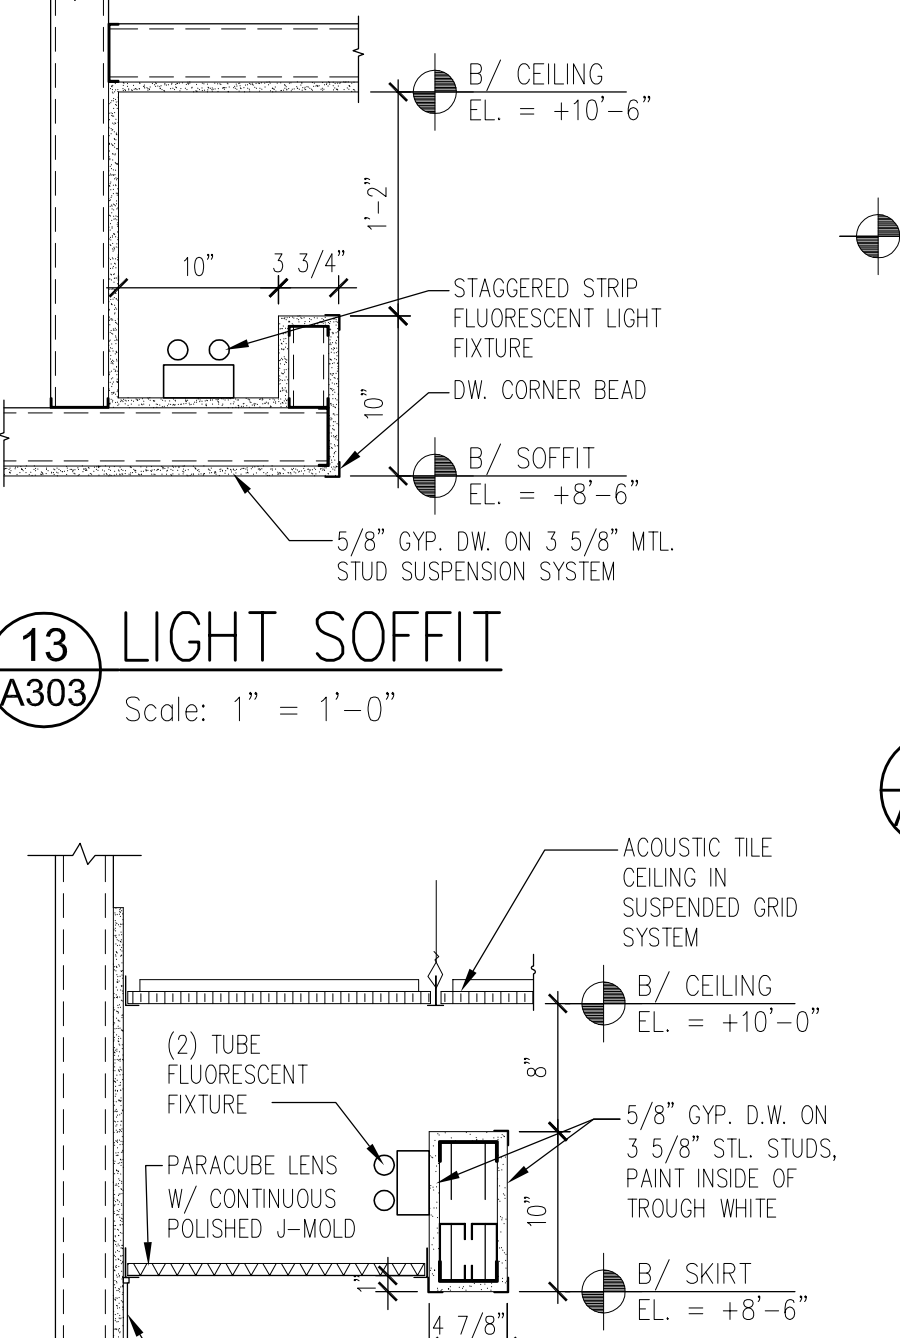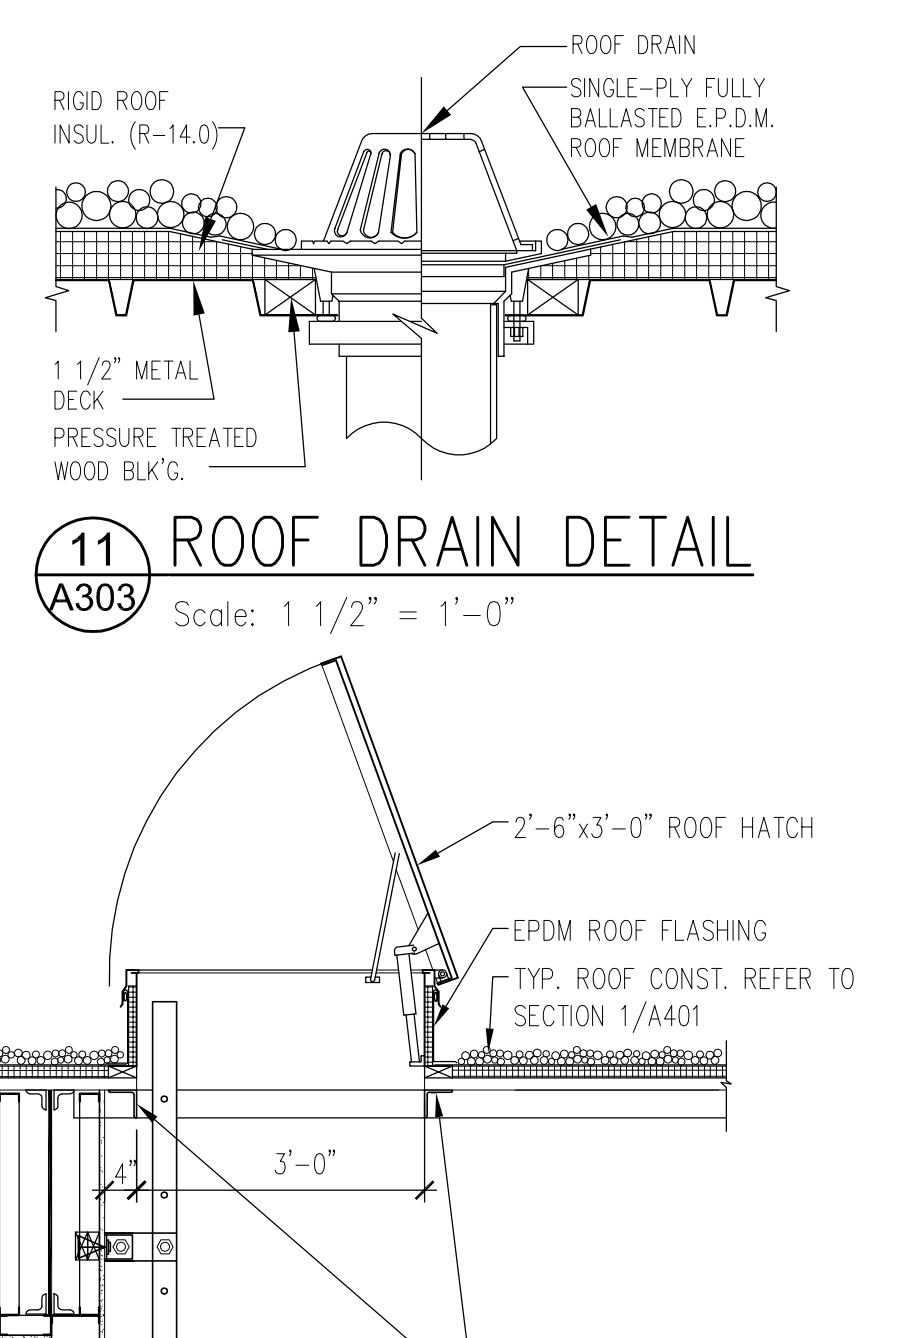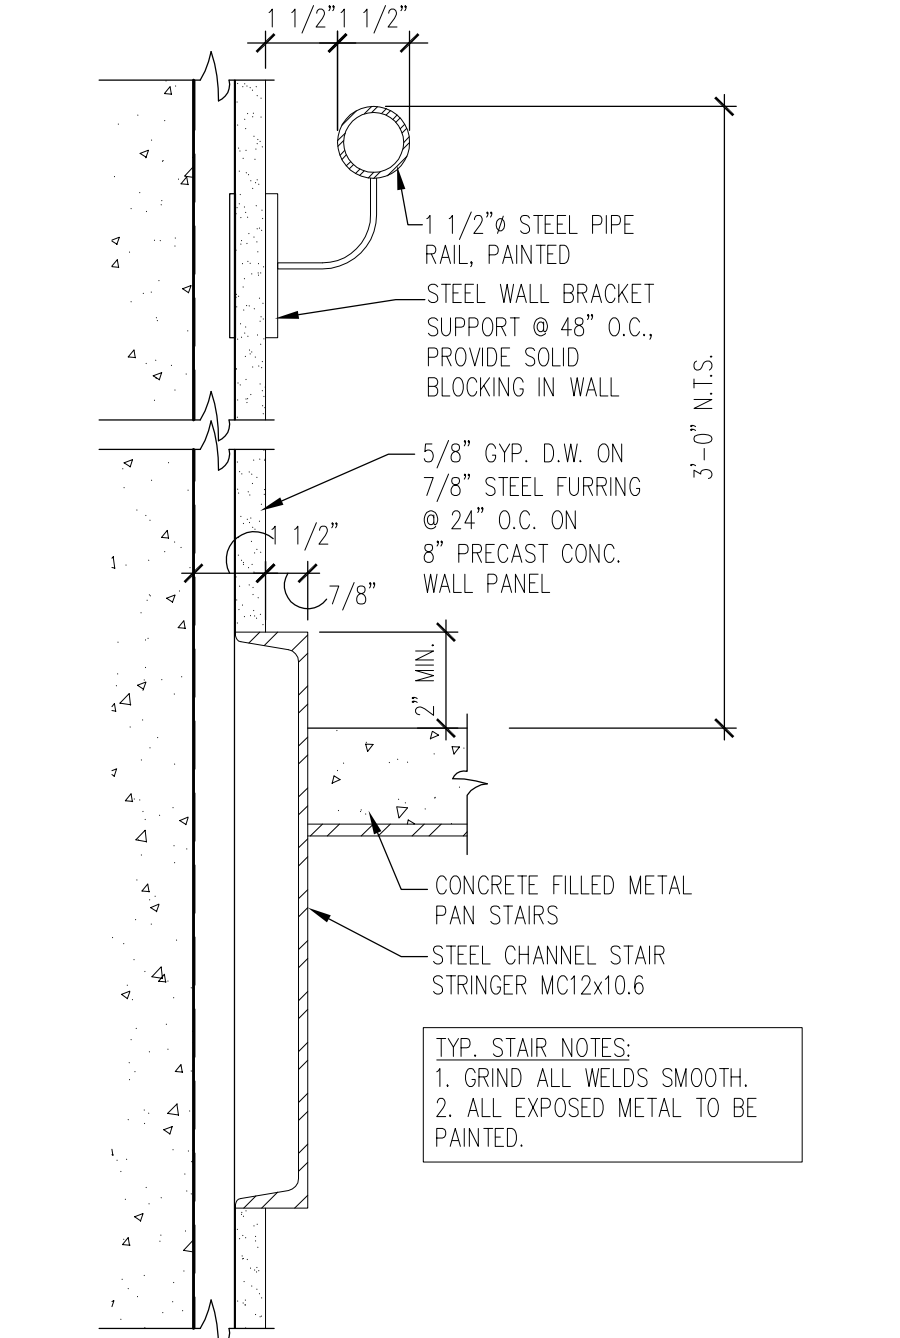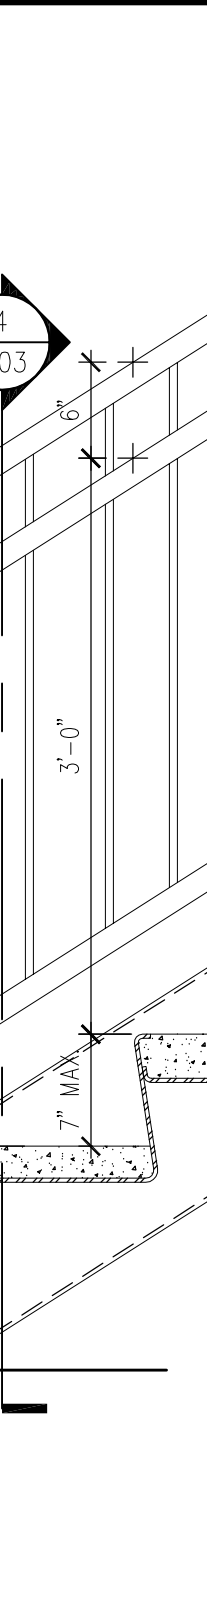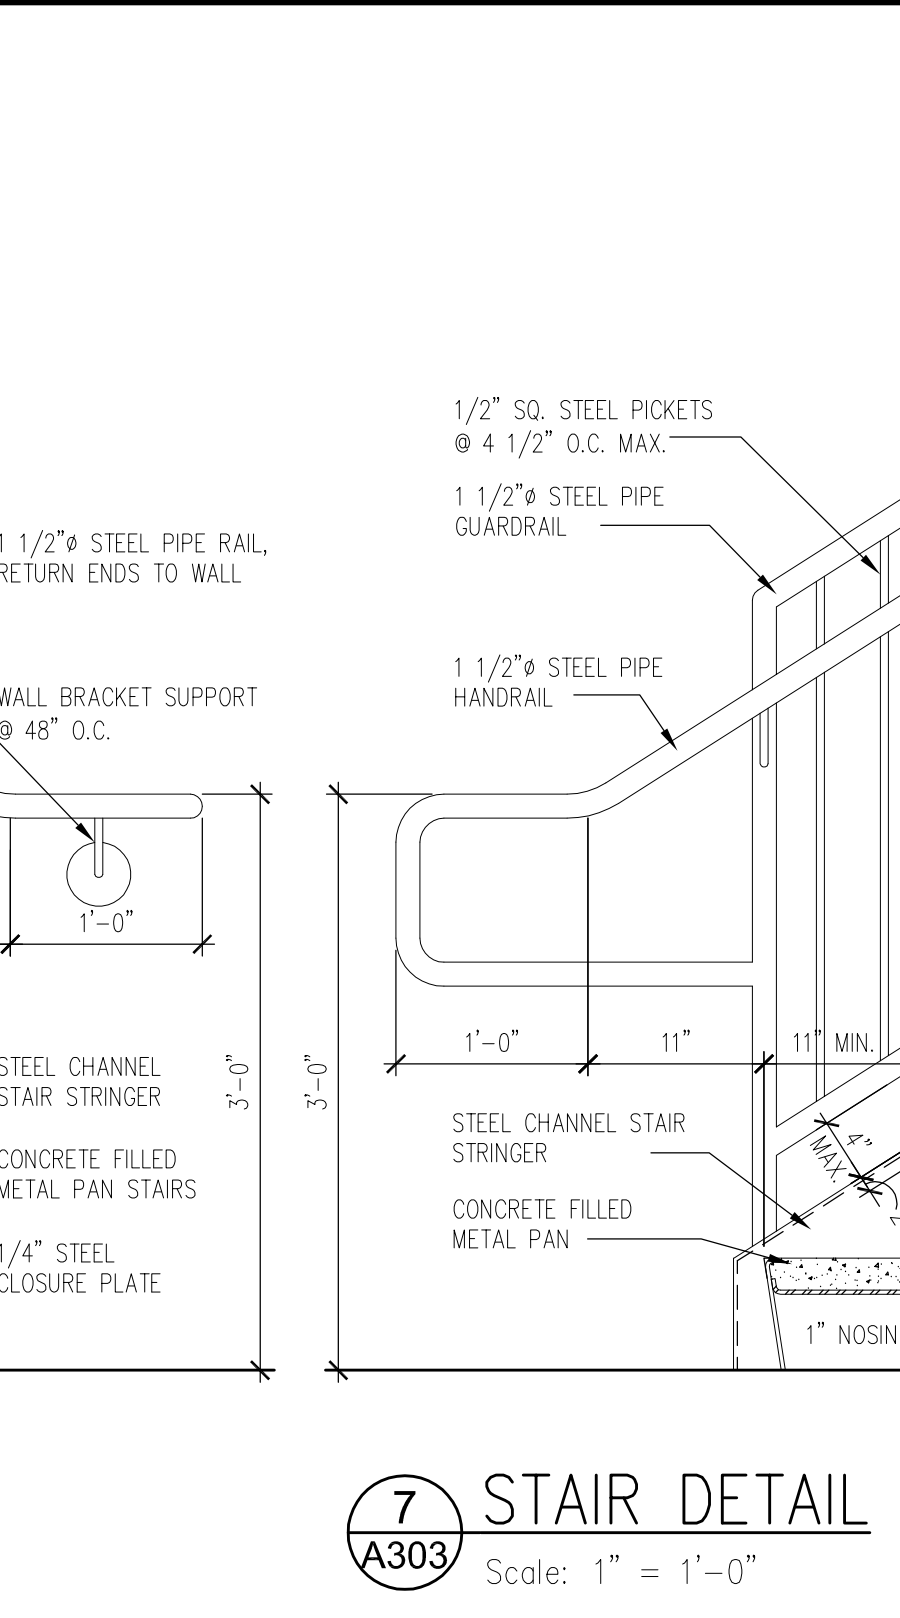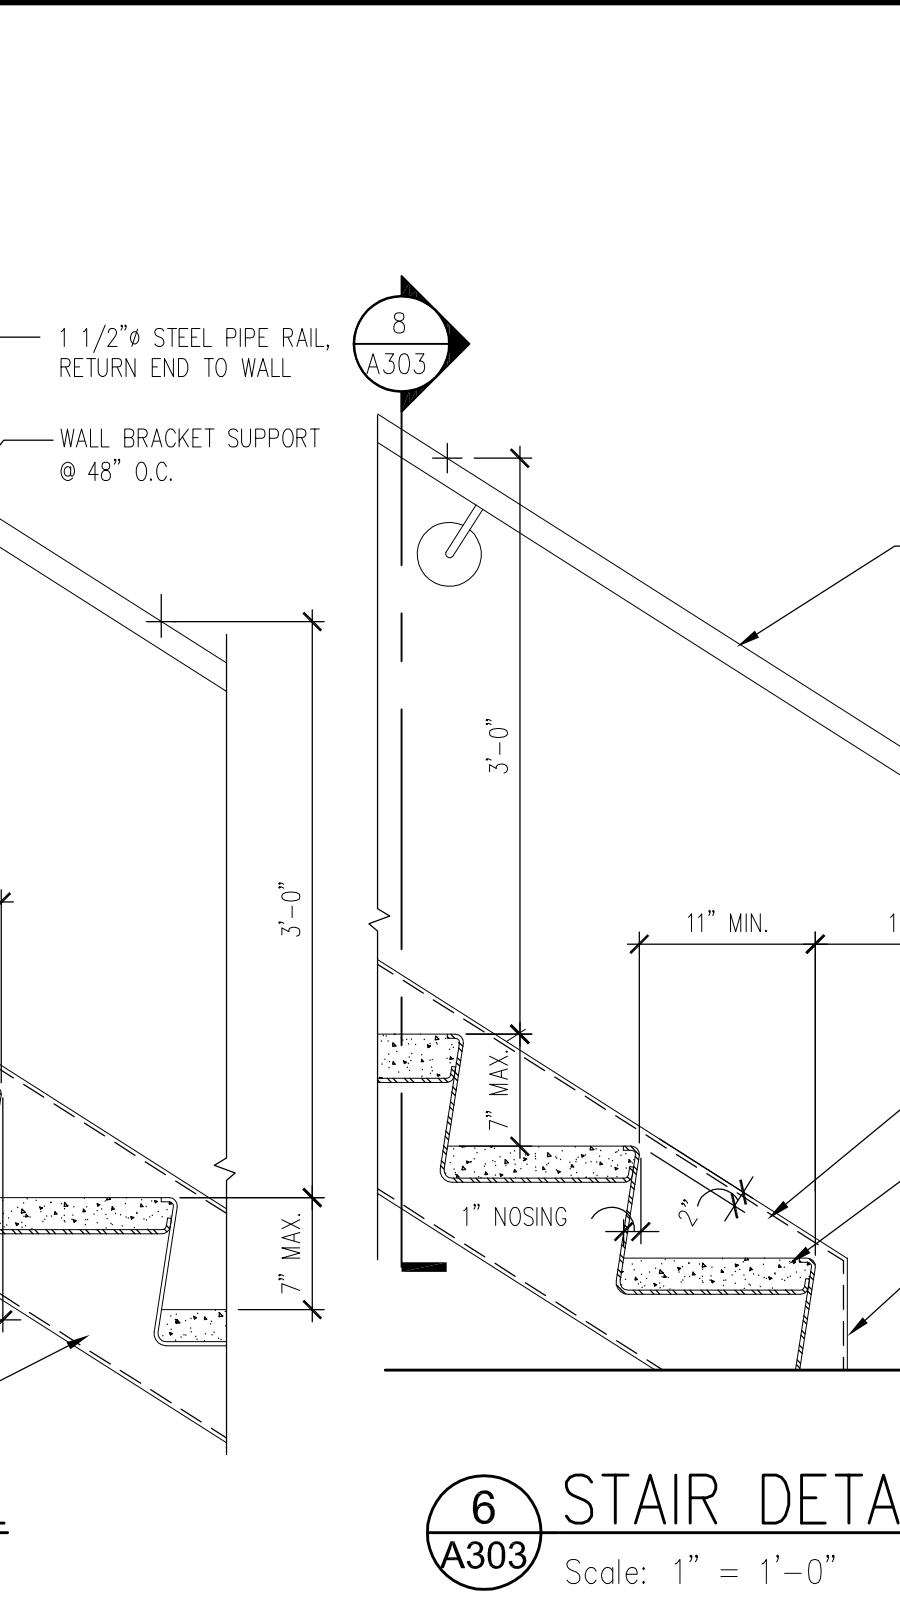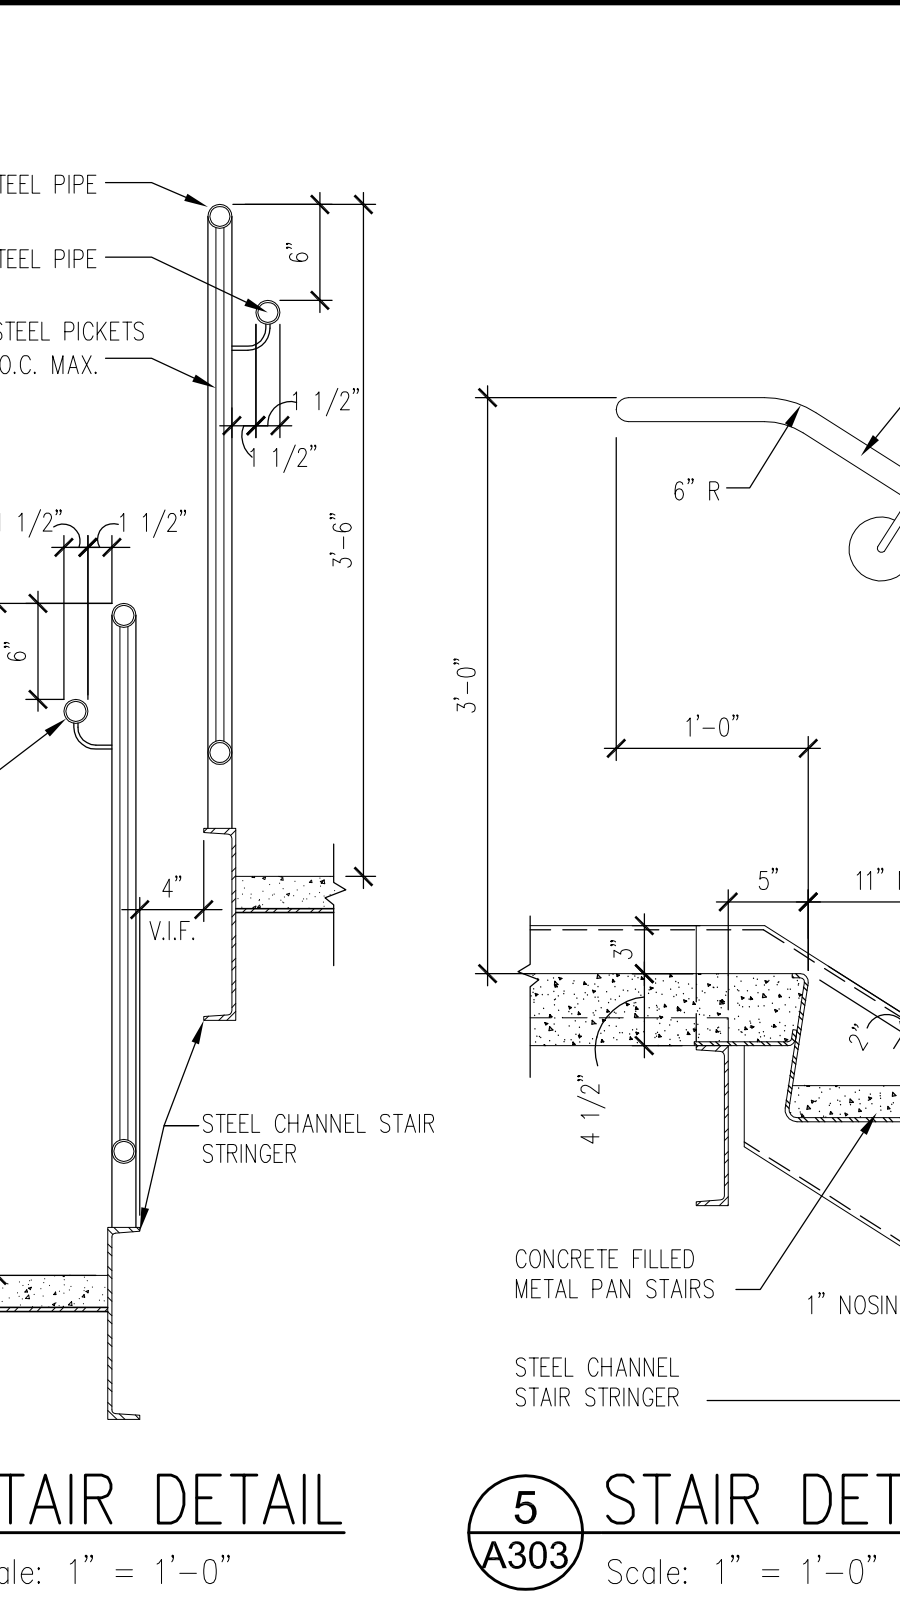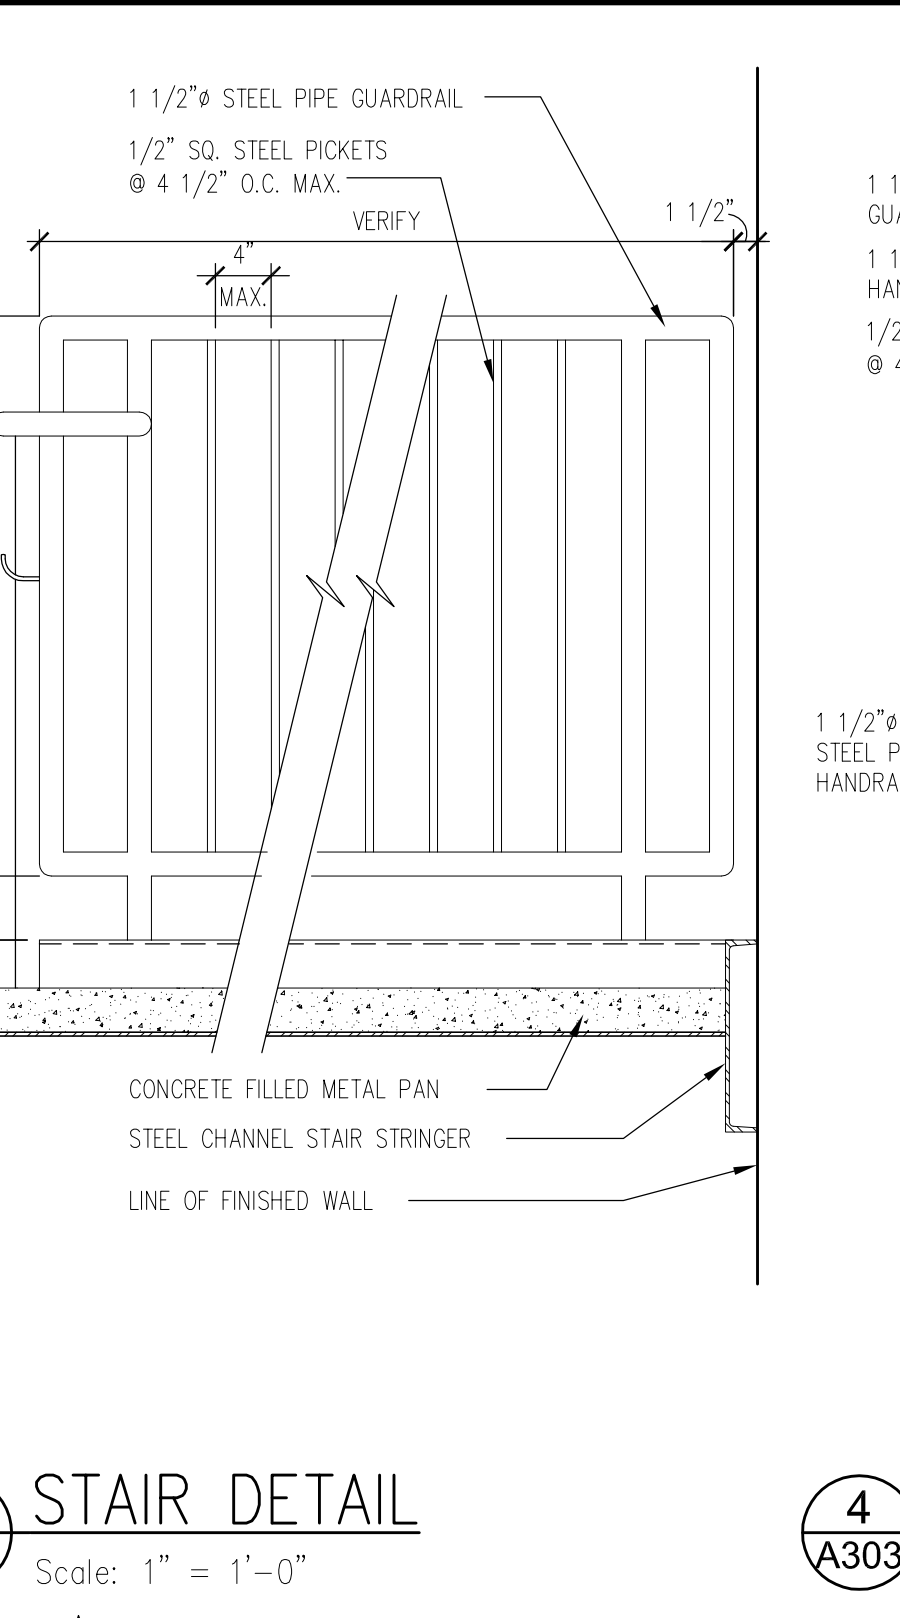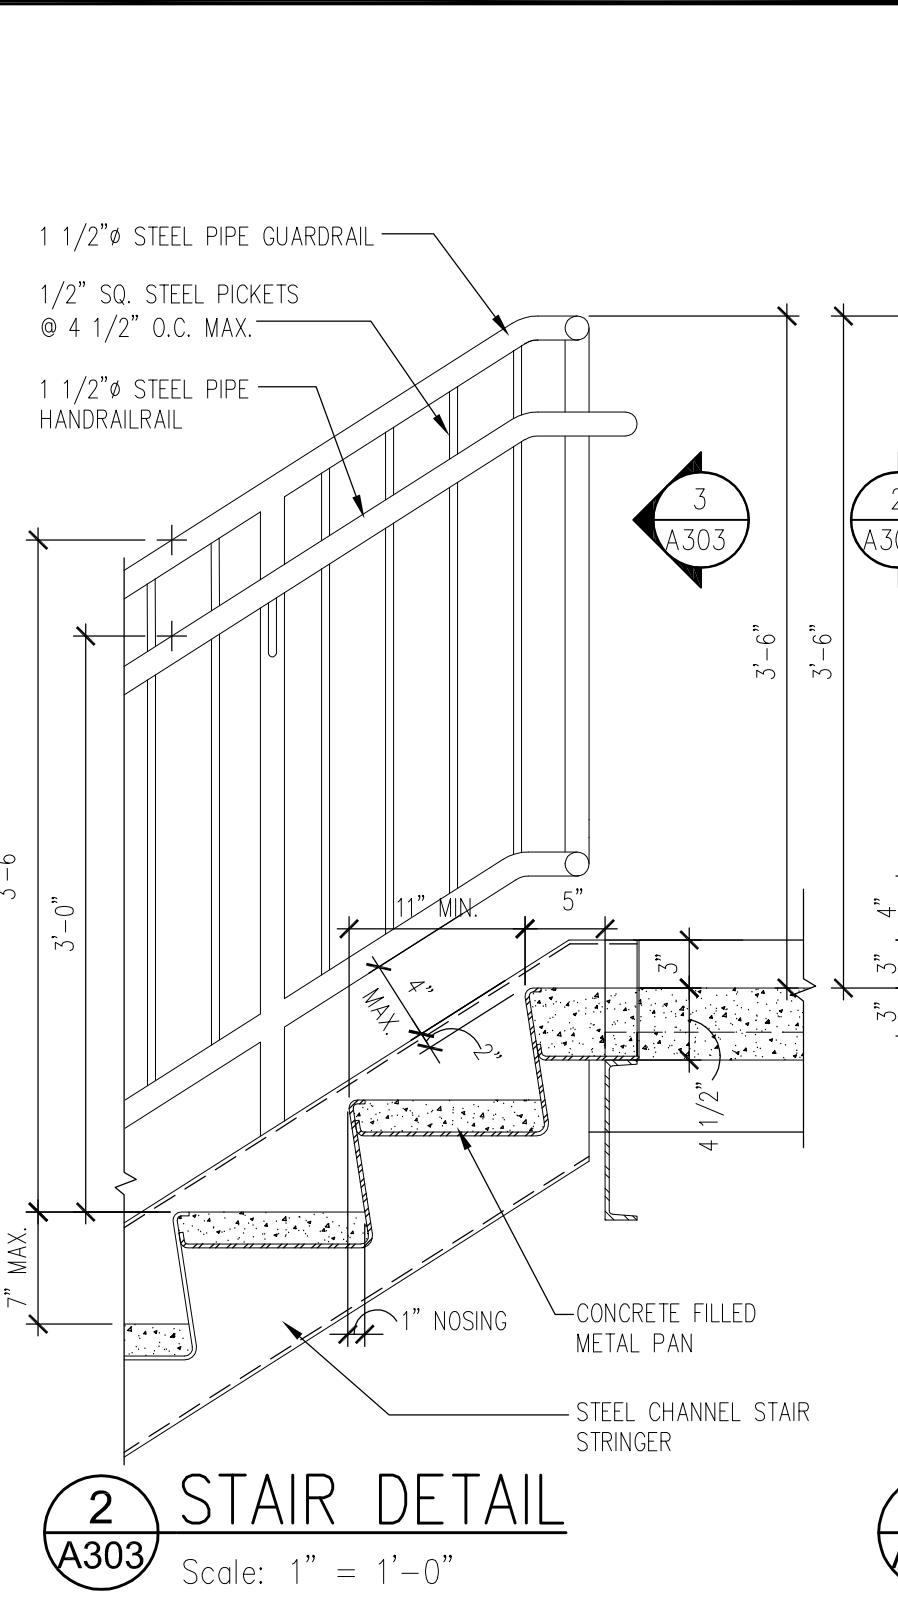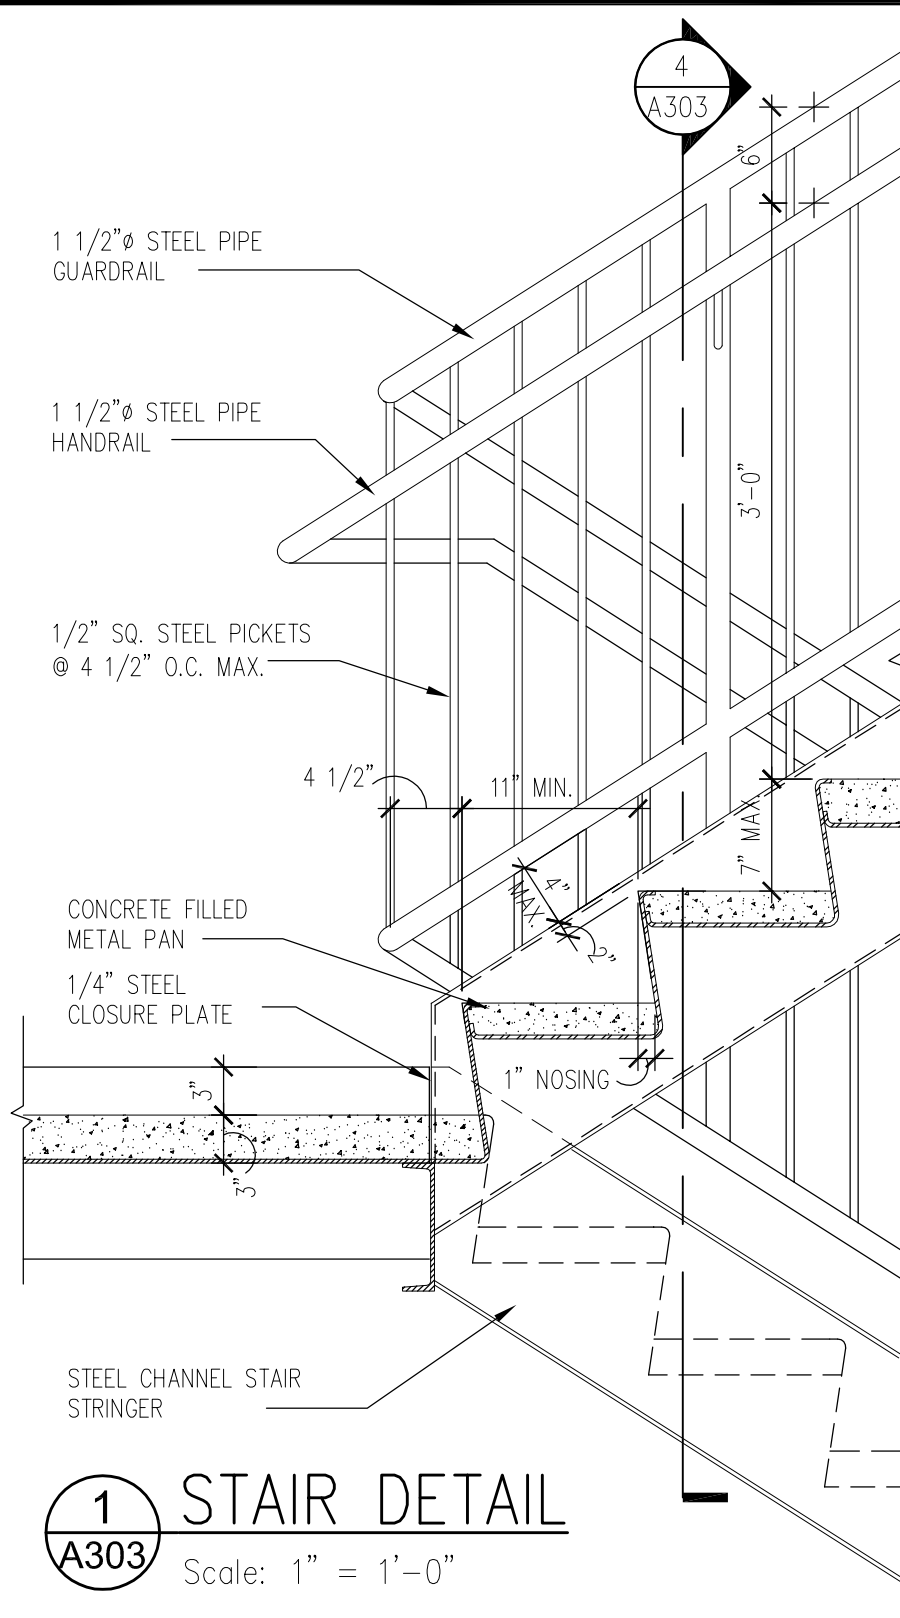

Duke
CONSTRUCTION
4225 Naperville Road
Suite 150
Lisle, IL 60532
Phone: (630) 577-7900
Fax: (630) 577-7979

TMA
Architects - Planners
Timothy Morgan Associates
200 Tri-State International Center
Suite 100
Lincolnshire, Illinois 60069
847 374-0058 phone
847 374-0057 fax

Revisions:

5/10/05 Initial Building Permit Submittal	8/23/05 Shell Construction Set	10/14/05 Rev's-Owner Finish Rev. Mtg	03/12/06 - Record Set
---	--------------------------------	--------------------------------------	-----------------------

Scale: 1/8" = 1'

Date: 03/12/06

Drawn By: SBT

Checked By:

PARAGON GLOBAL RESOURCES

CANTERA CORPORATE CENTER - LOT 1

27501 BELLA VISTA PARKWAY

WARRENVILLE, ILLINOIS

STAIR DETAILS

Certified By:

Drawing Number:

A303




Of Sheets

Duke Realty Job Number:

PARAGN-001

A/E Job Number:

04-094

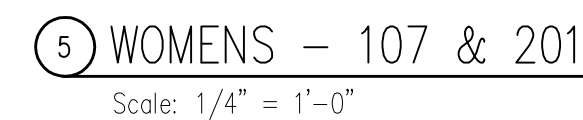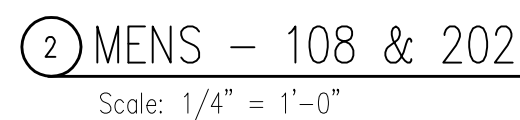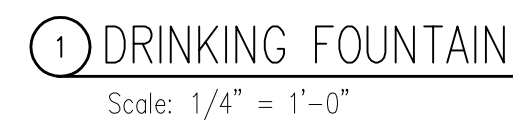


NOTES:


1. PROVIDE AND INSTALL WITH-IN WALLS WOOD BLOCKING, AS REQUIRED FOR INSTALLATION OF GRAB BARS & CABINETY.
2. INSULATE TRAP AND HOT WATER PIPES AT ALL EXPOSED SINKS.
3. LAVATORY FAUCETS SHALL BE LEVER OPERATED, PUSH-TYPE OR ELECTRONICALLY CONTROLLED SELF-CLOSING AND SHALL REMAIN OPEN FOR AT LEAST 15 SECONDS.
4. LAVATORY WATER TEMPERATURE SHALL NOT EXCEED 110 DEGREES F.
5. CONTROLS FOR FLUSH VALVES SHALL BE MOUNTED ON THE WIDE SIDE OF THE TOILET AREA NO MORE THAN 44 in. ABOVE THE FLOOR.




NOTES:
1. REFER TO STRUCTURAL DWGS. FOR FOOTING SIZES AND REINFORCING.
2. ALL CARBON STEEL BELOW GRADE SHALL RECEIVE ONE COAT OF ASPHALTIC PAINT PRIOR TO BACKFILL, TYPICAL.

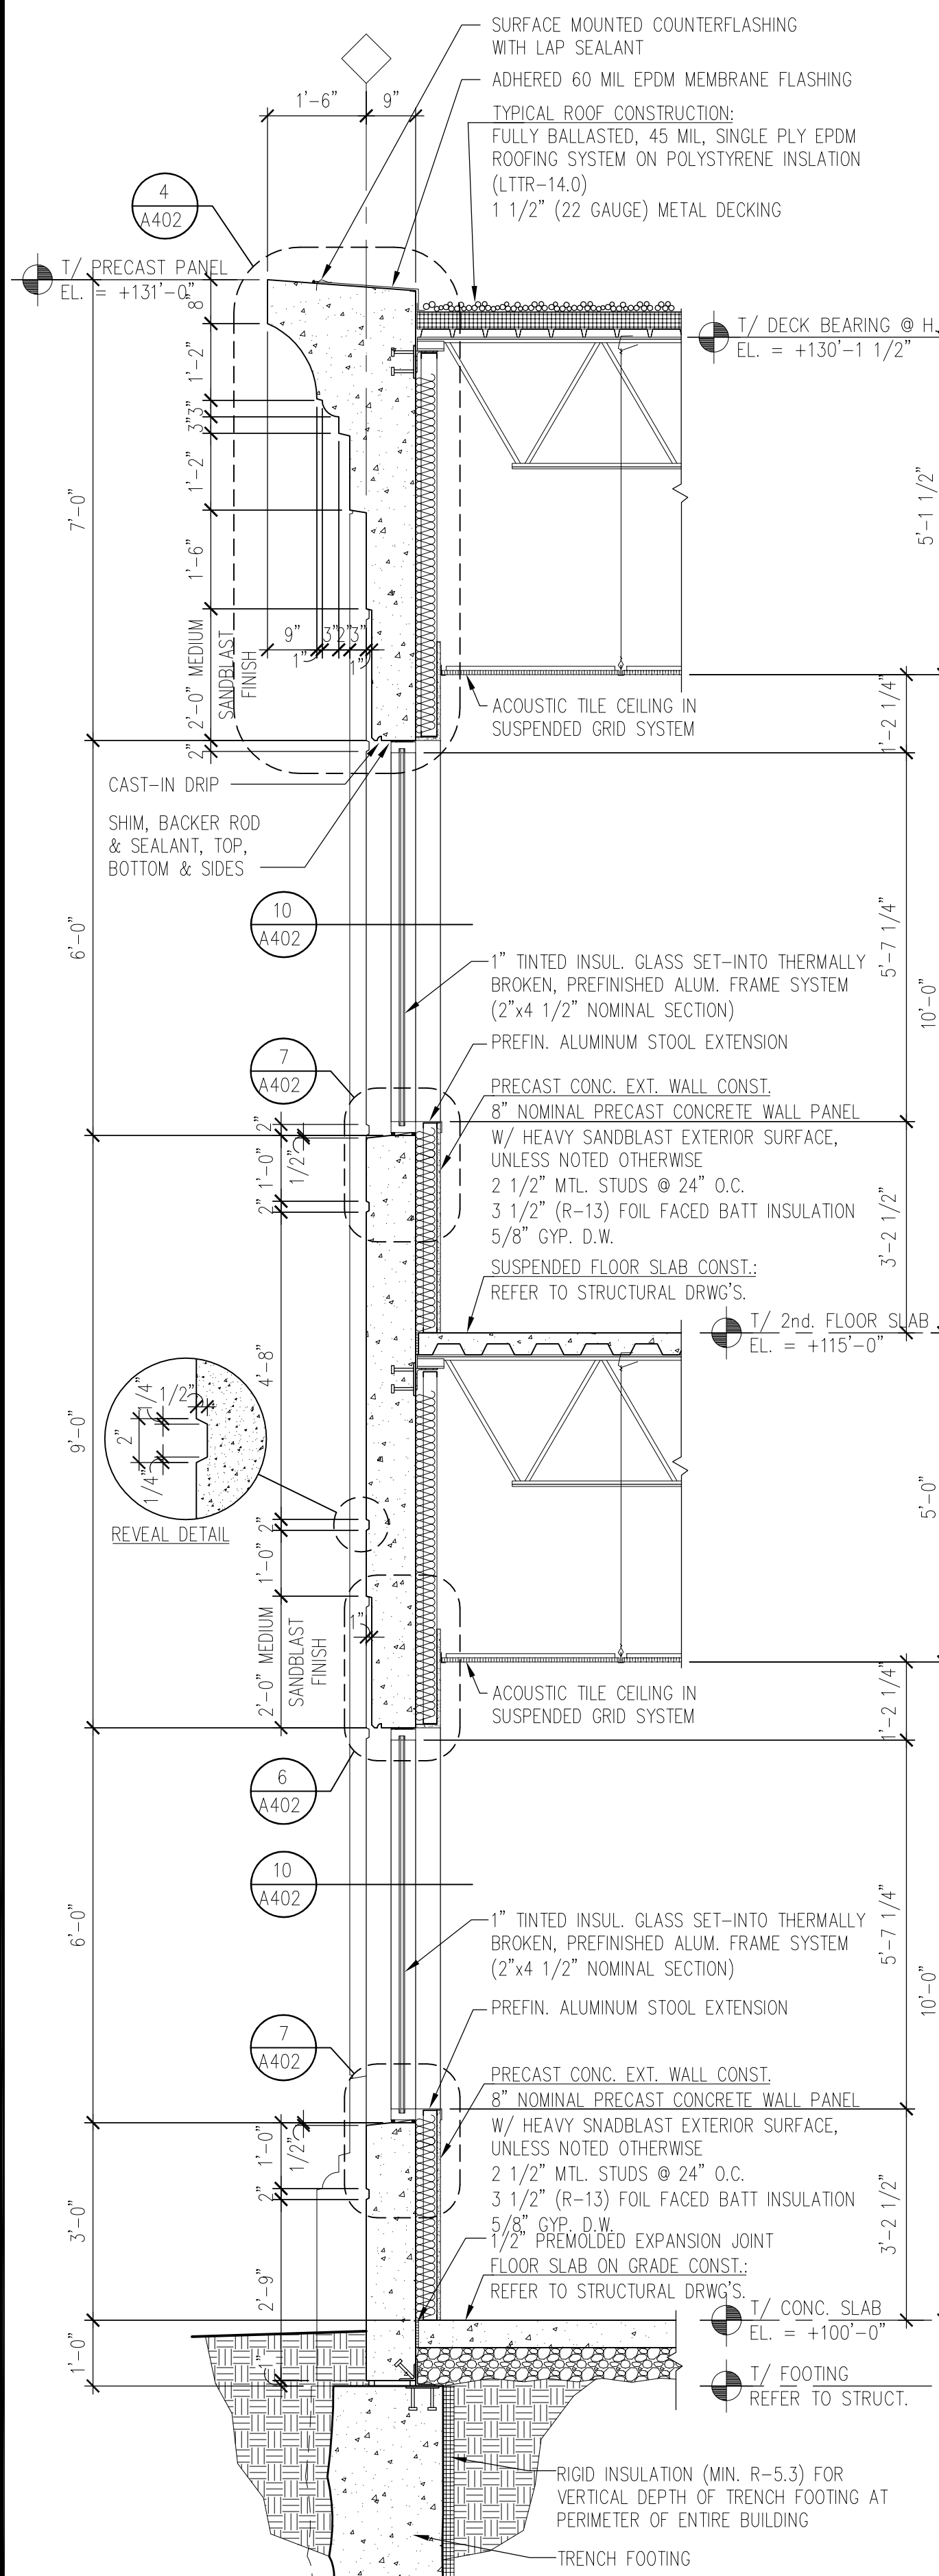


1 WALL SECTION
A401 Scale: 1/2" = 1'-0"

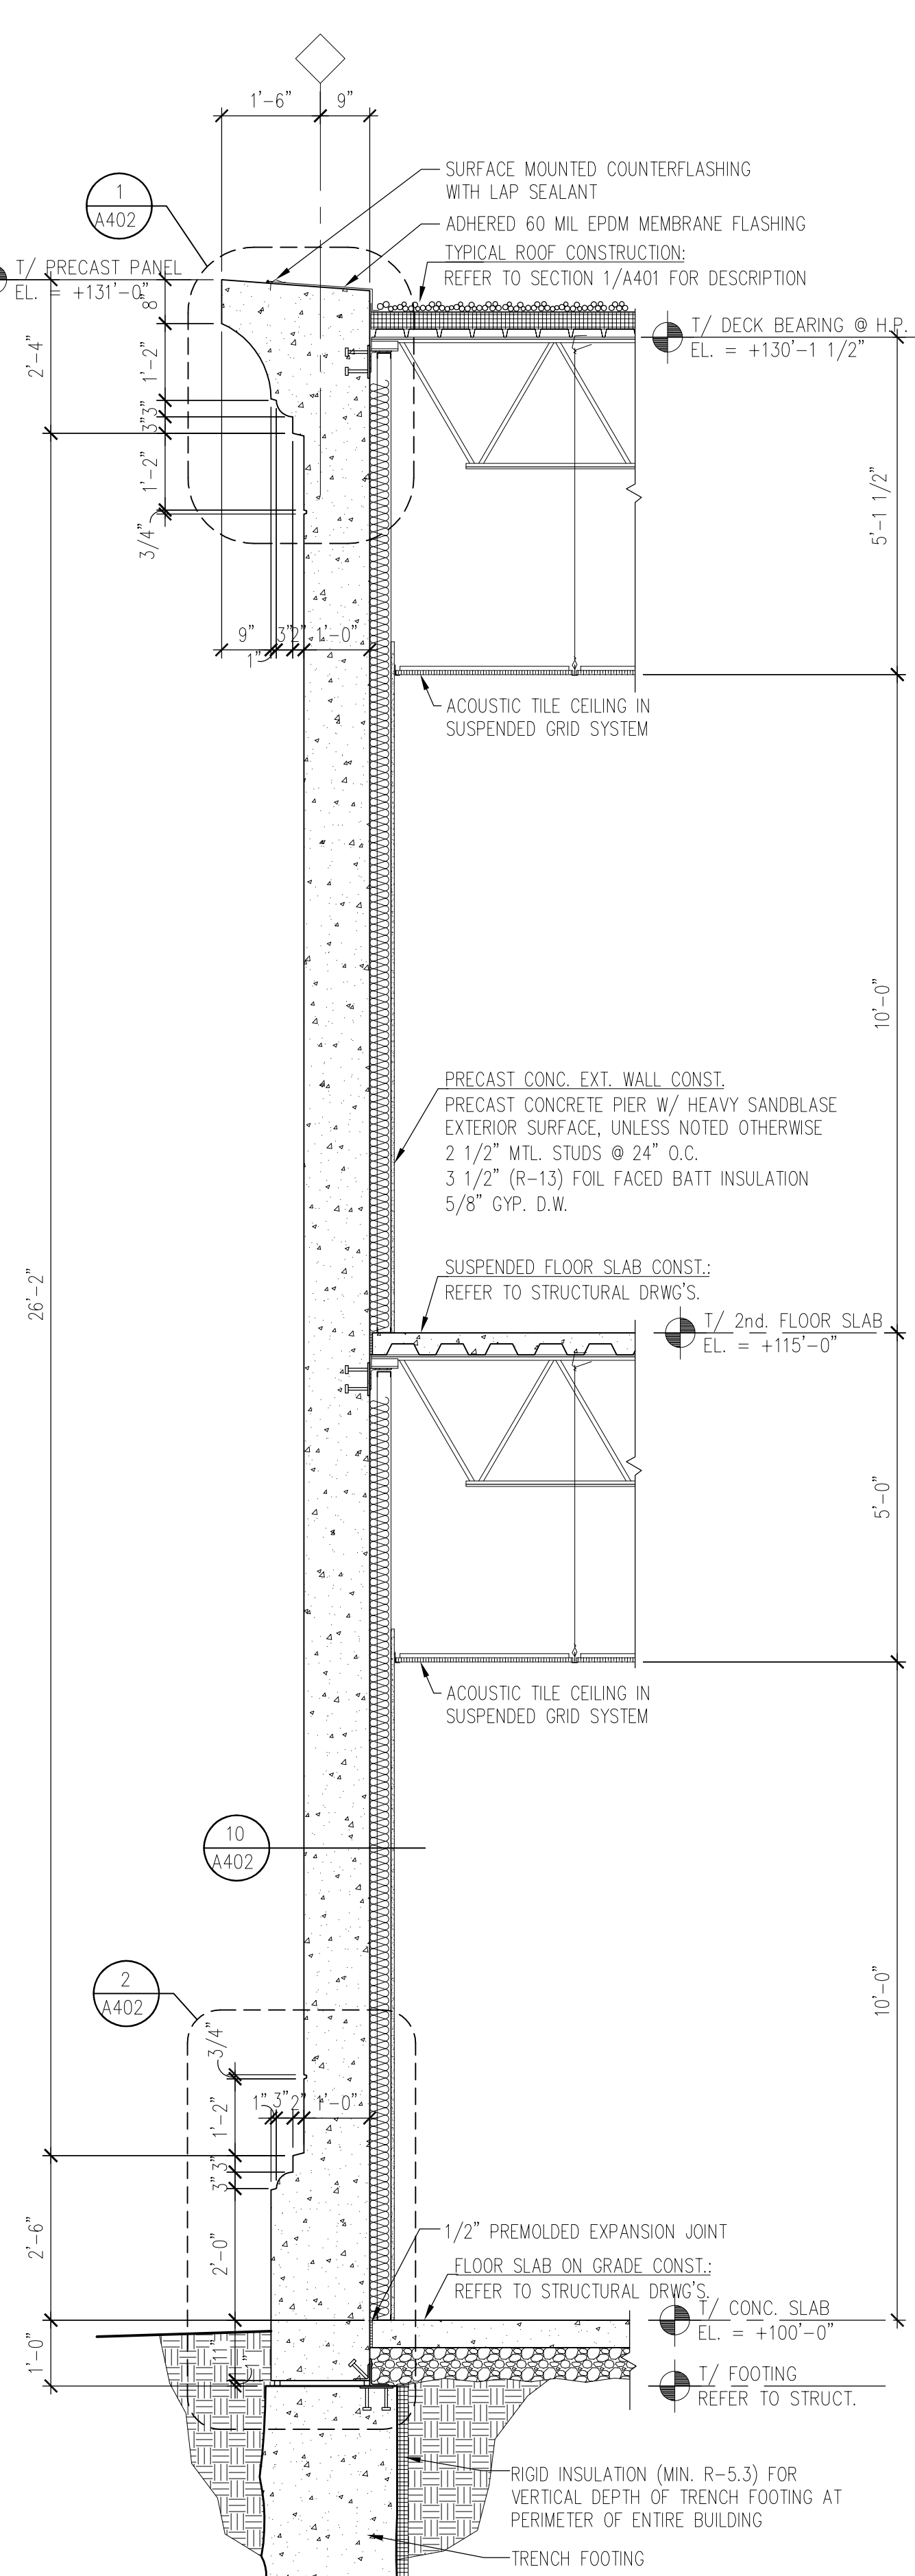

2 WALL SECTION @ PIER
A401 Scale: 1/2" = 1'-0"

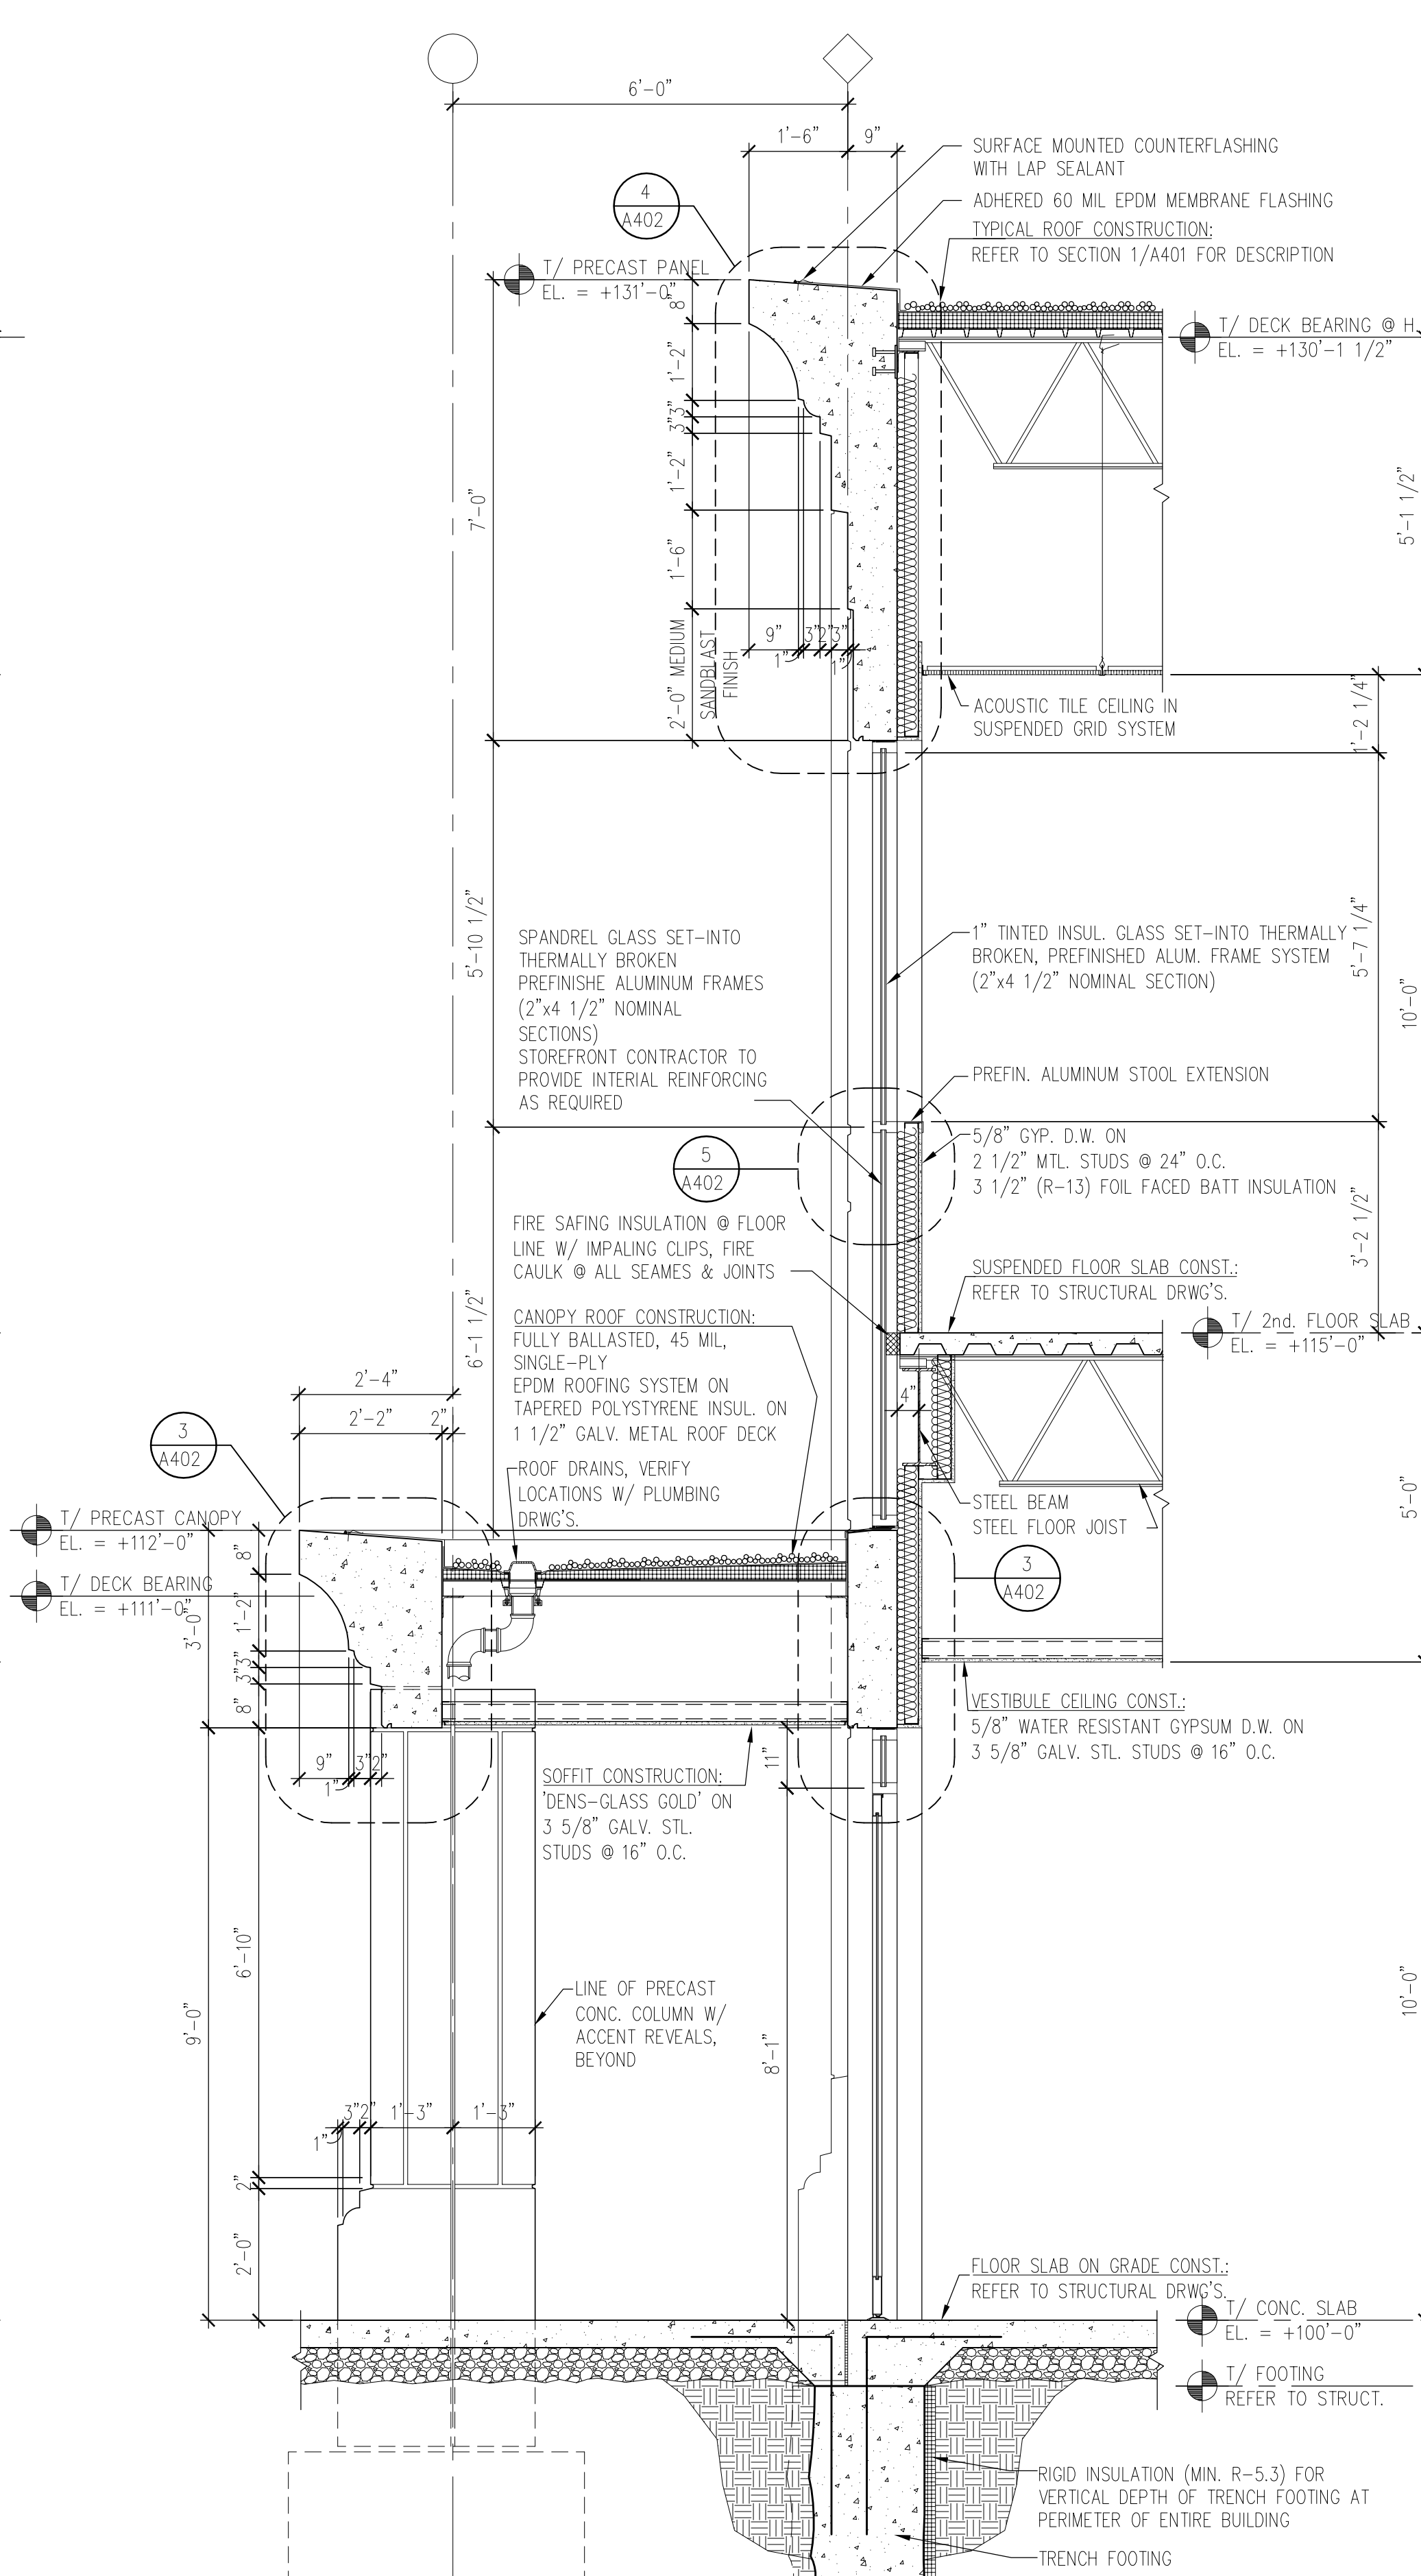


3 WALL SECTION @ ENTRY CANOPY
A401 Scale: 1/2" = 1'-0"

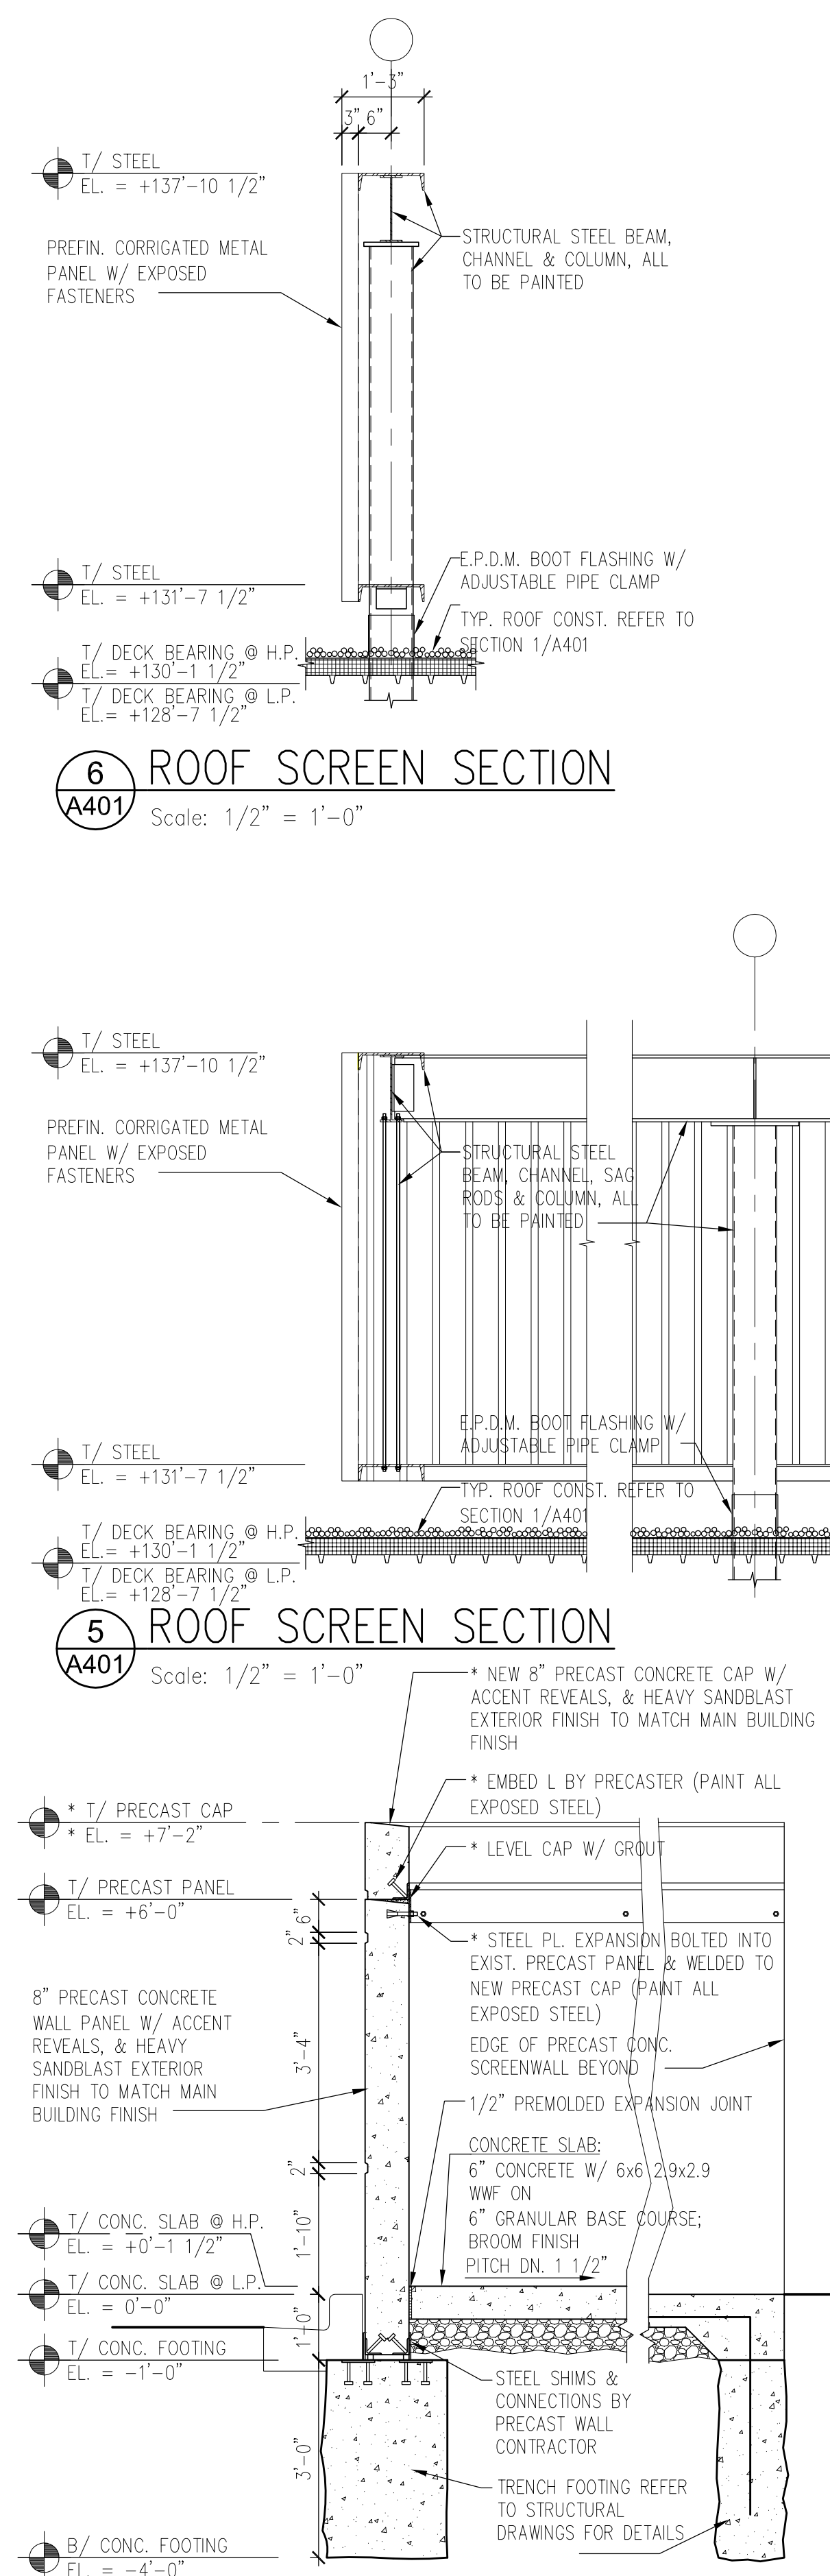


4 SCREENWALL SECTION
A401 Scale: 1/2" = 1'-0"


* TO BE INSTALLED @
GENERATOR ENCLOSURE
ONLY

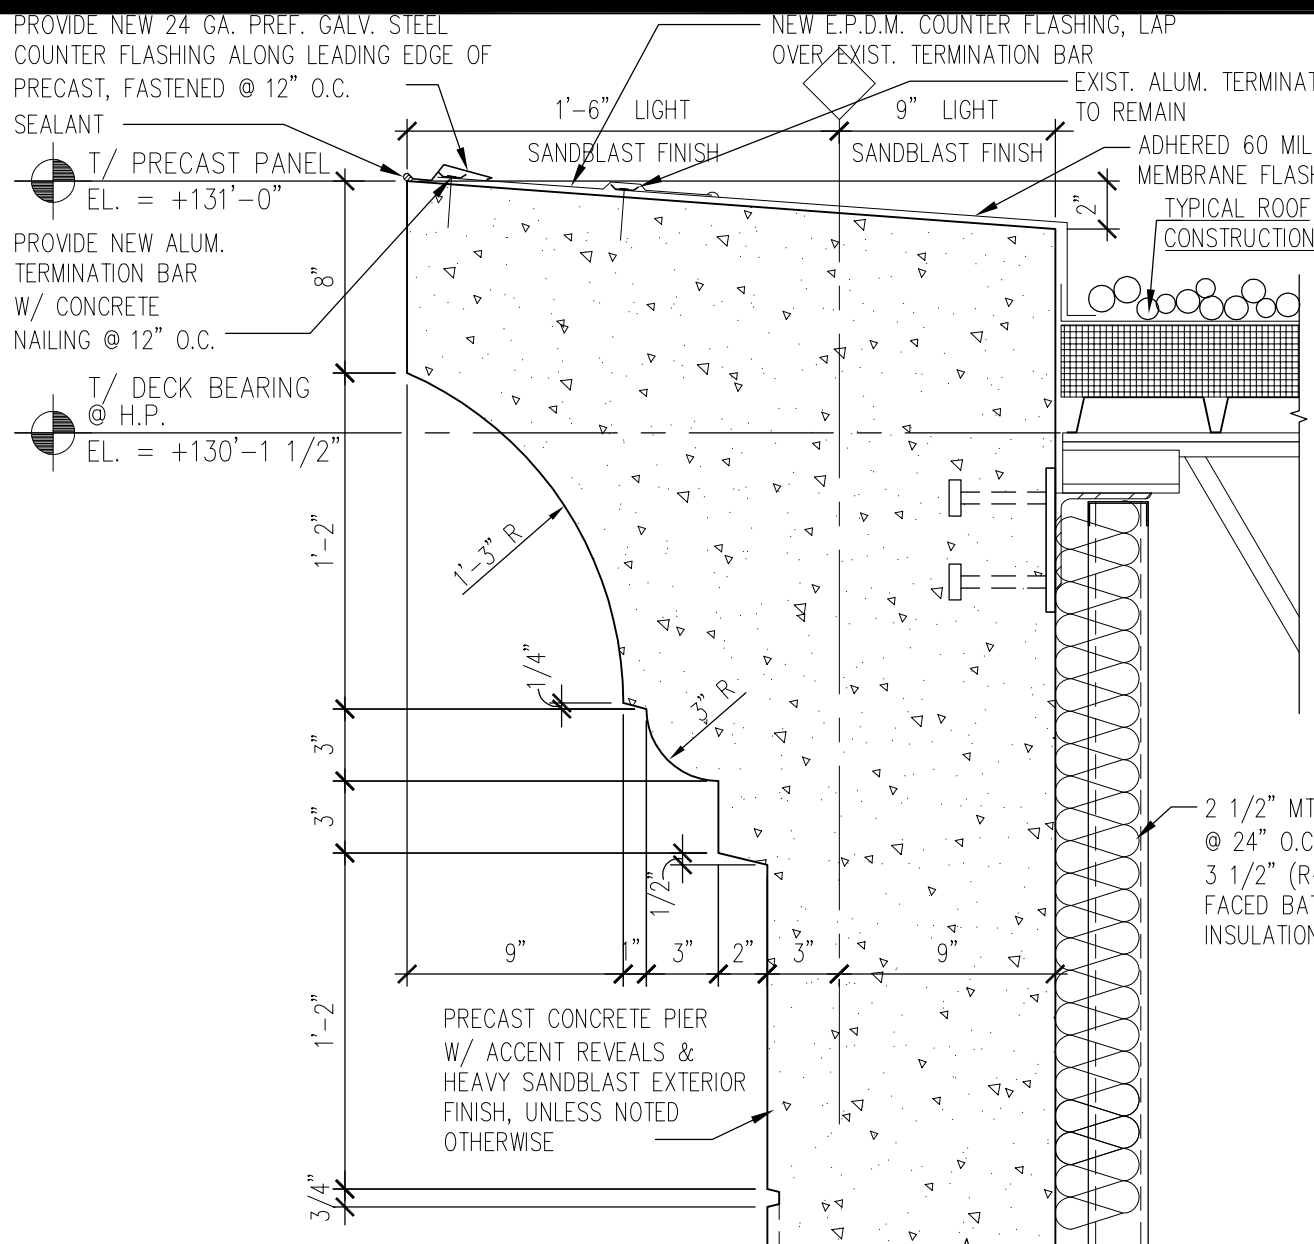



1 PARAPET DETAIL @ PIER
A402 Scale: 1 1/2" = 1'-0"

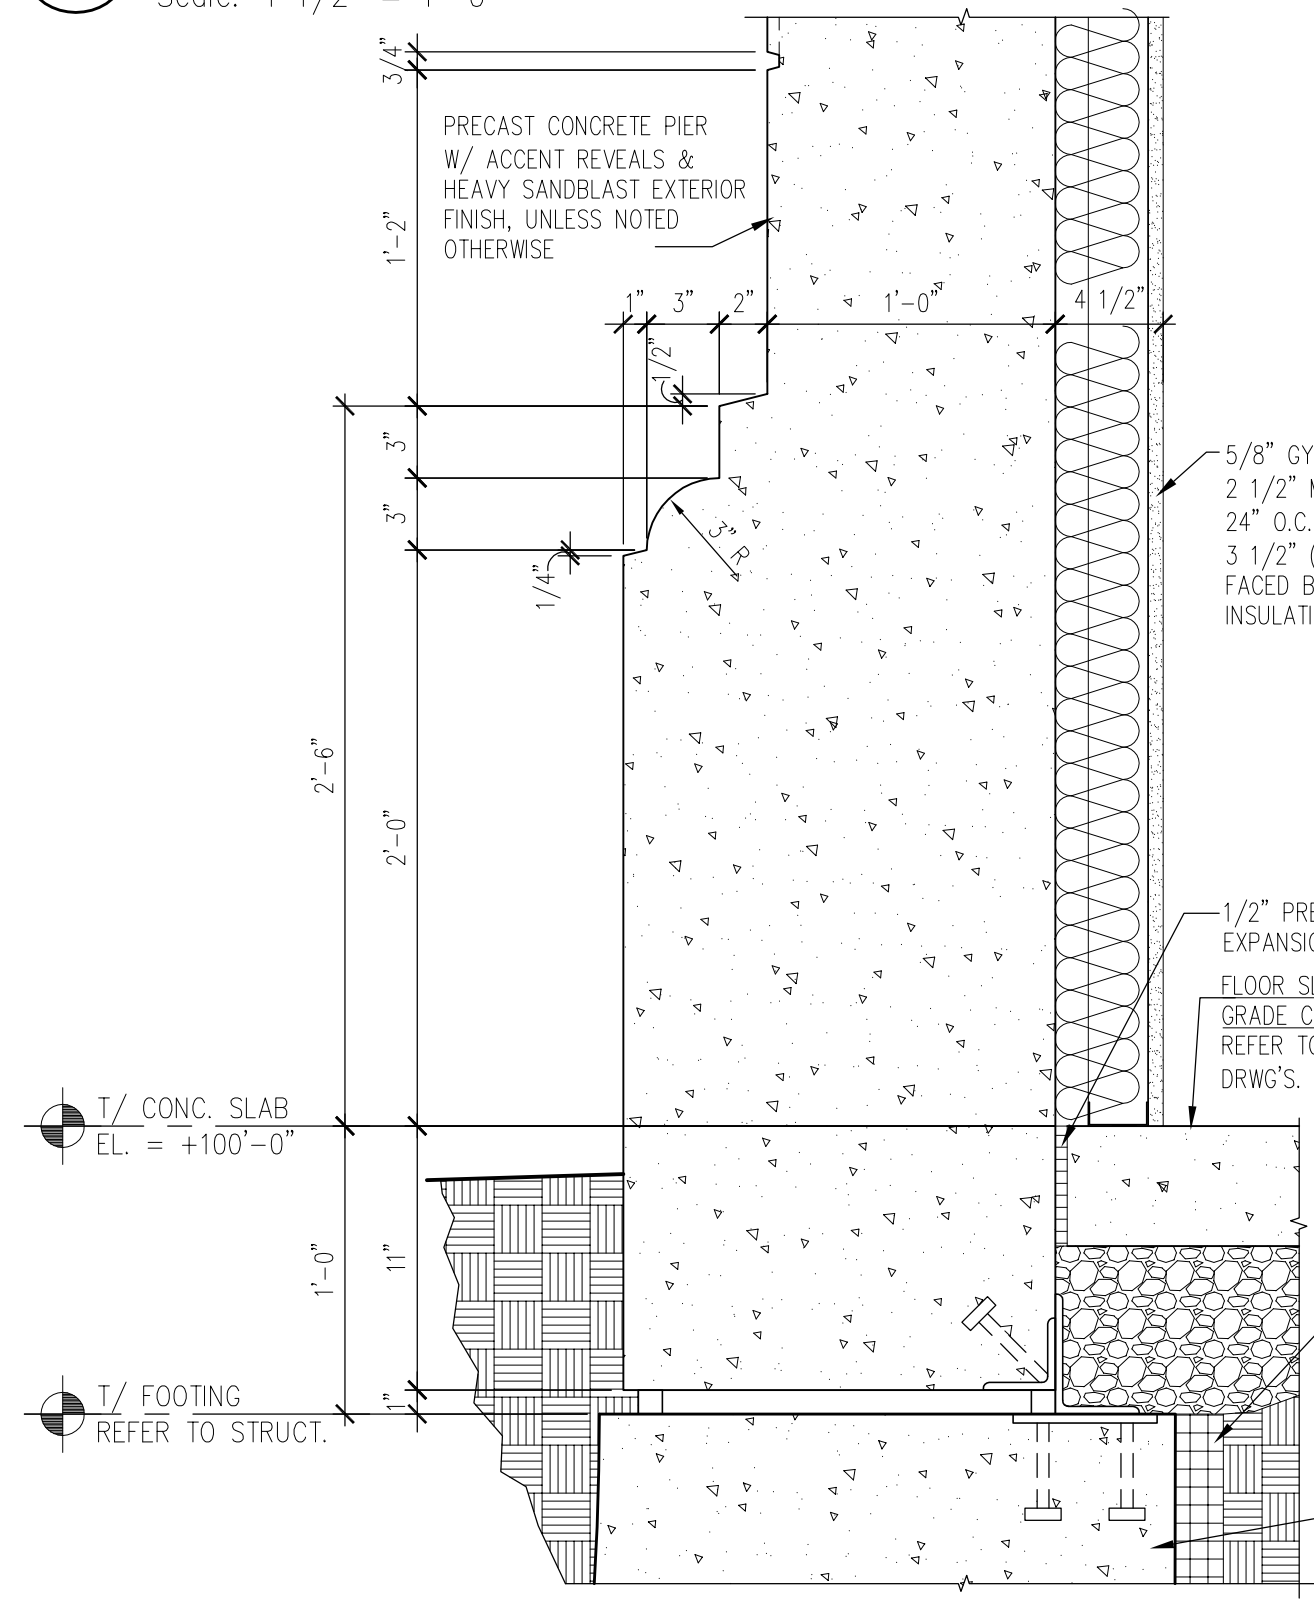


2 BASE DETAIL @ PIER
A402 Scale: 1 1/2" = 1'-0"

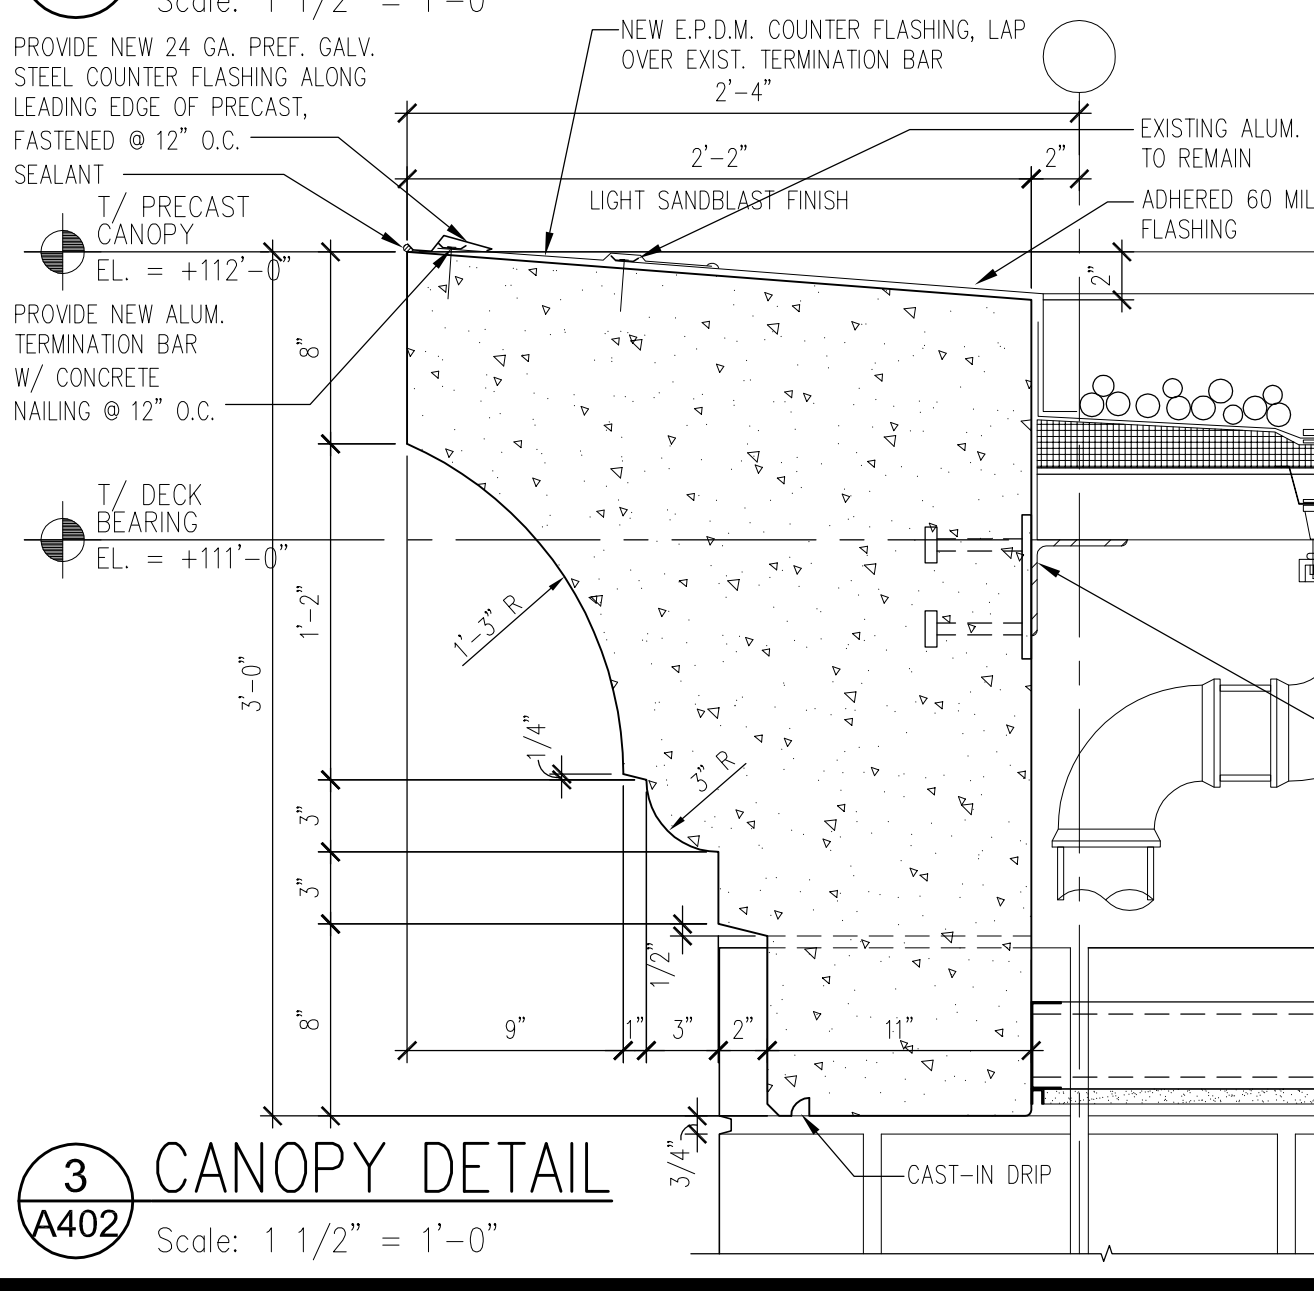


3 CANOPY DETAIL
A402 Scale: 1 1/2" = 1'-0"

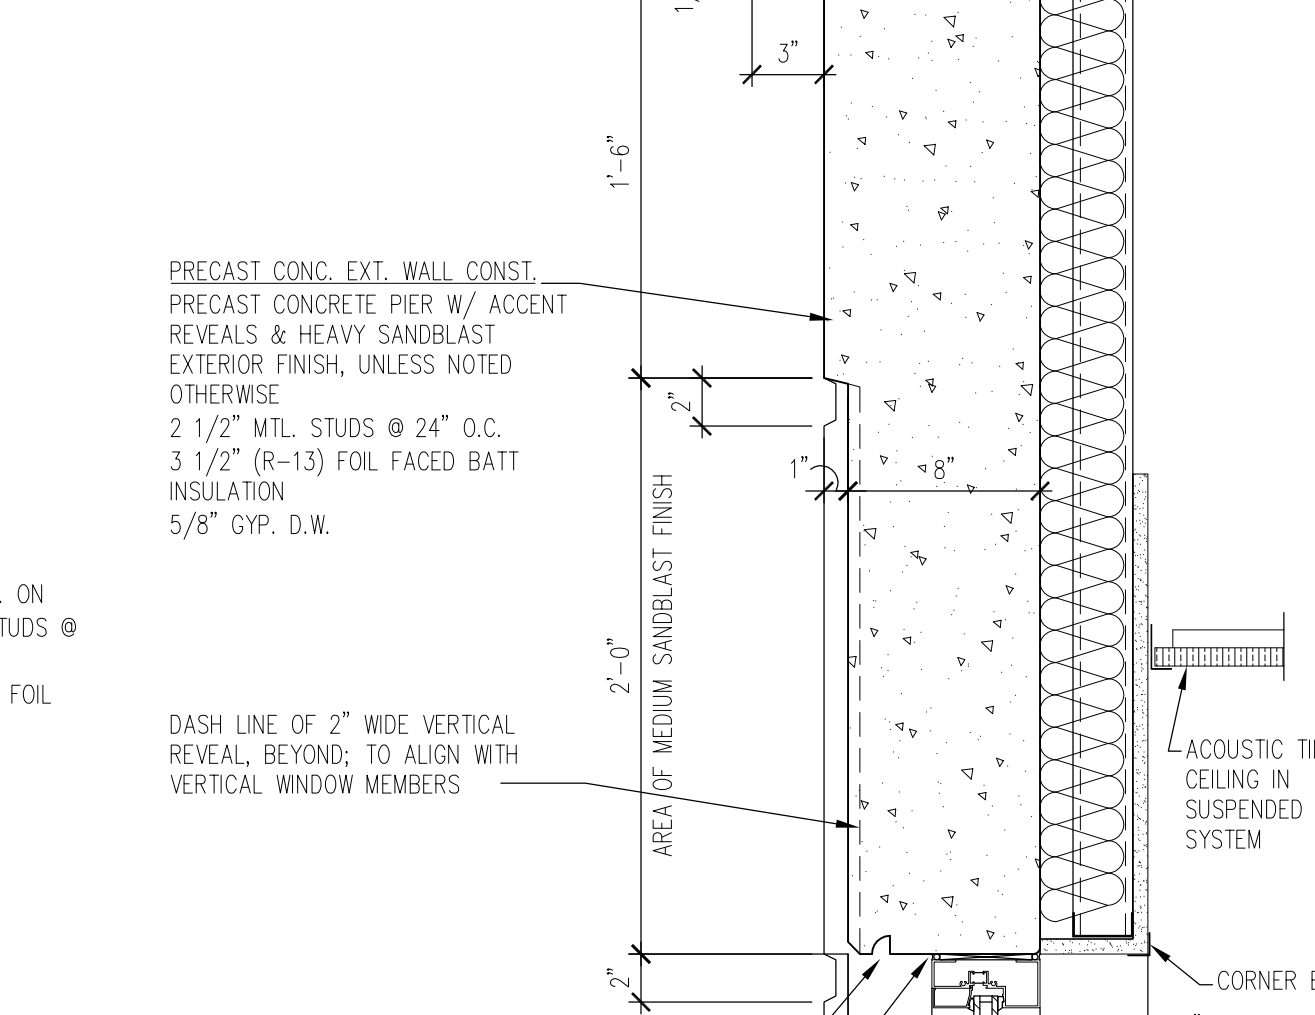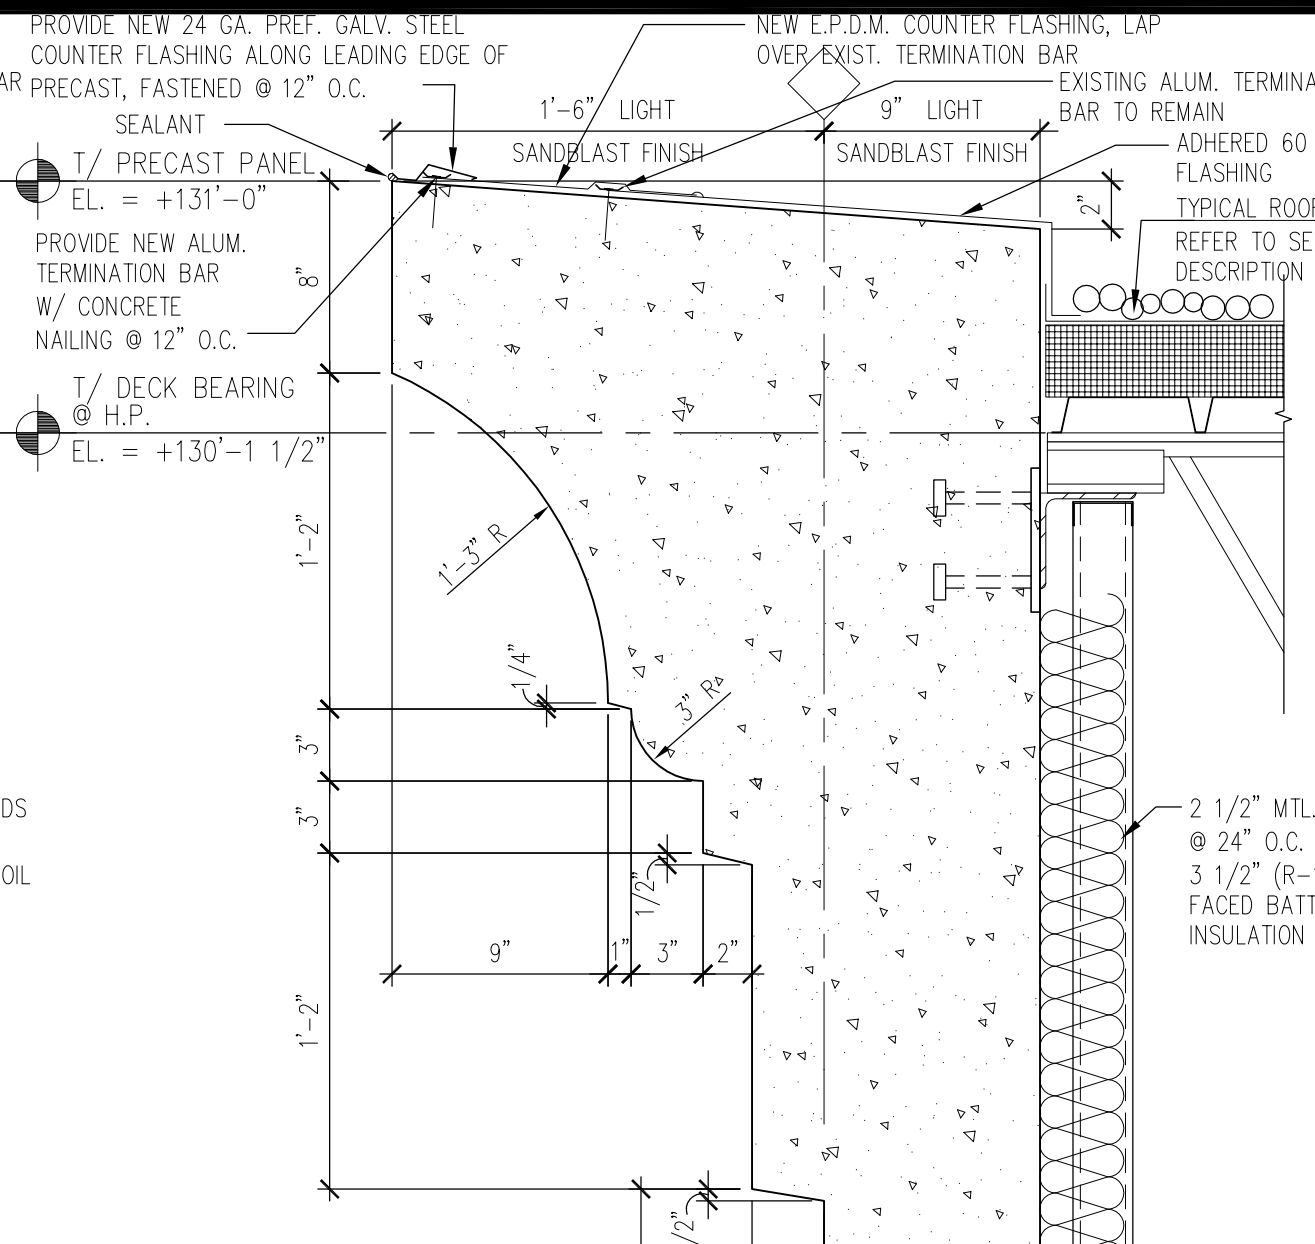


4 PARAPET DETAIL
A402 Scale: 1 1/2" = 1'-0"

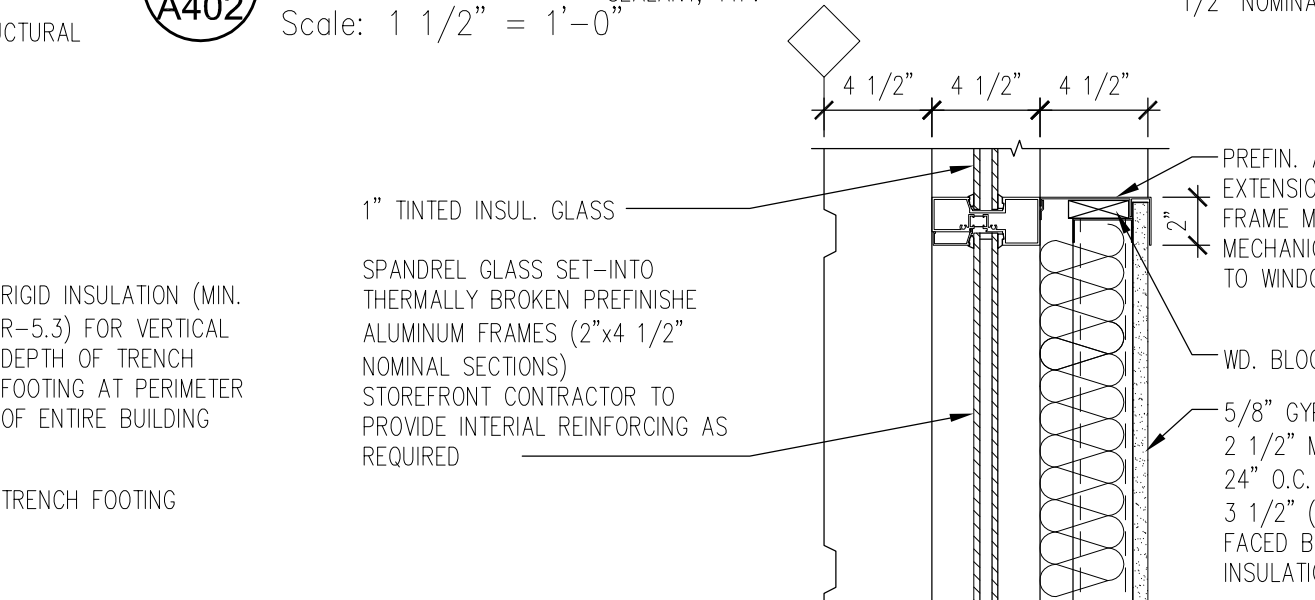


5 WINDOW SILL DETAIL
A402 Scale: 1 1/2" = 1'-0"

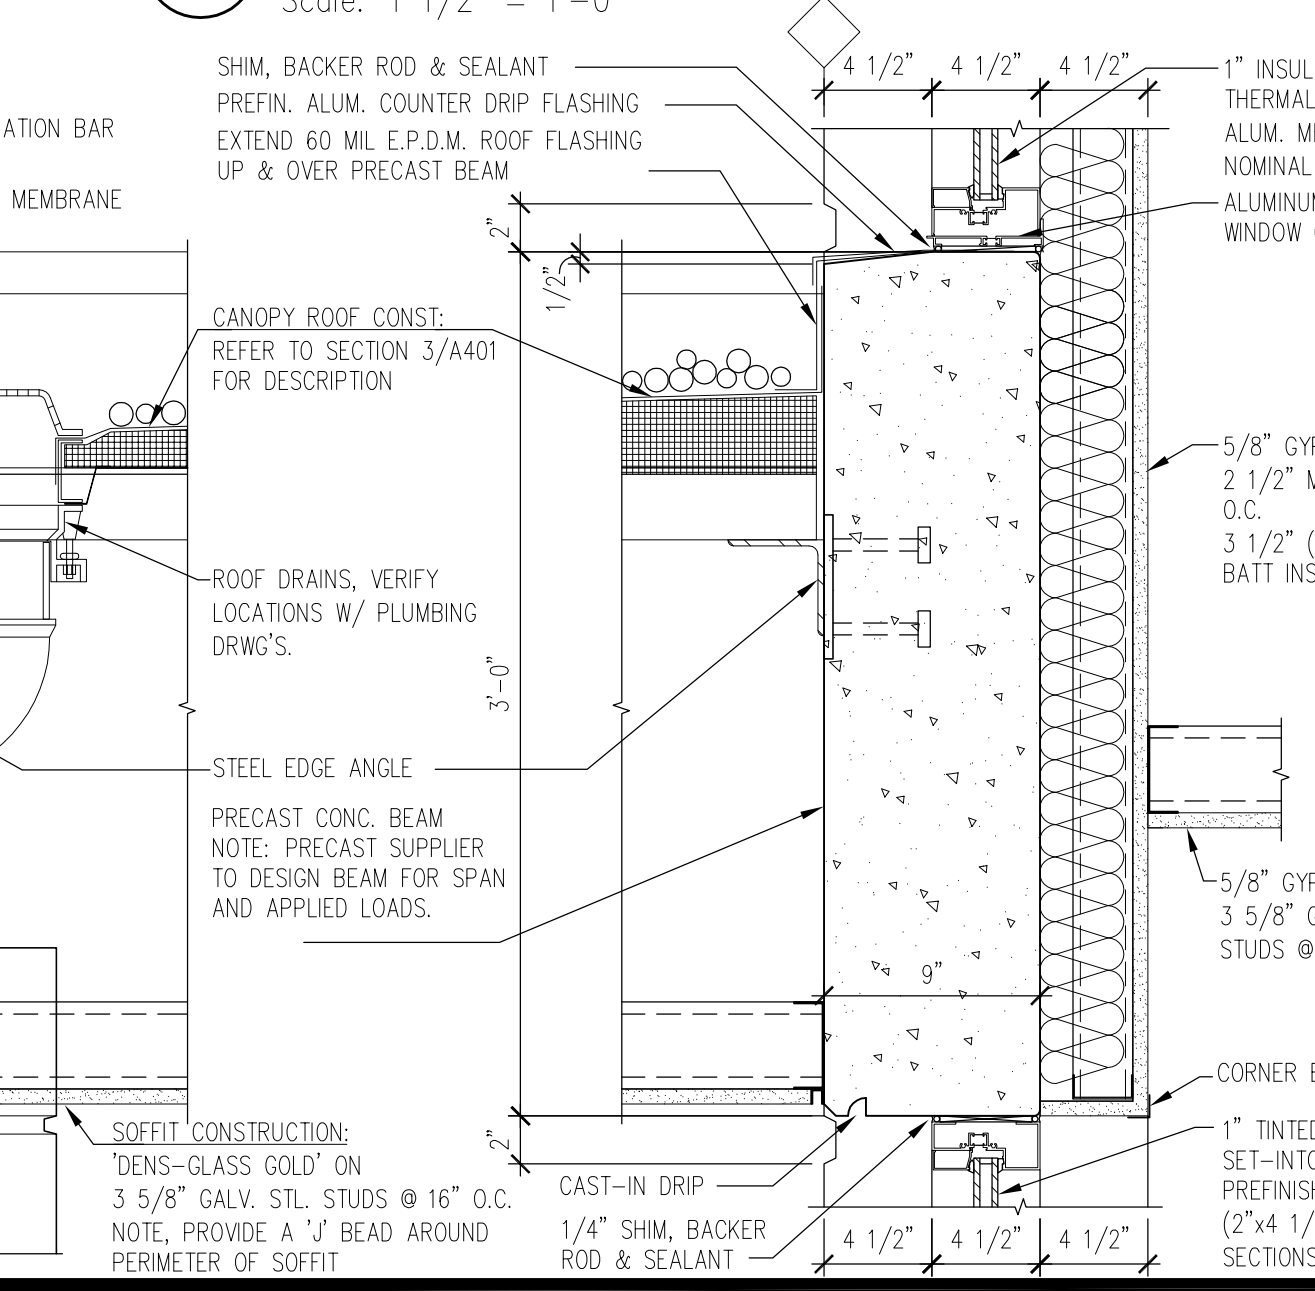


5 WINDOW SILL DETAIL
A402 Scale: 1 1/2" = 1'-0"

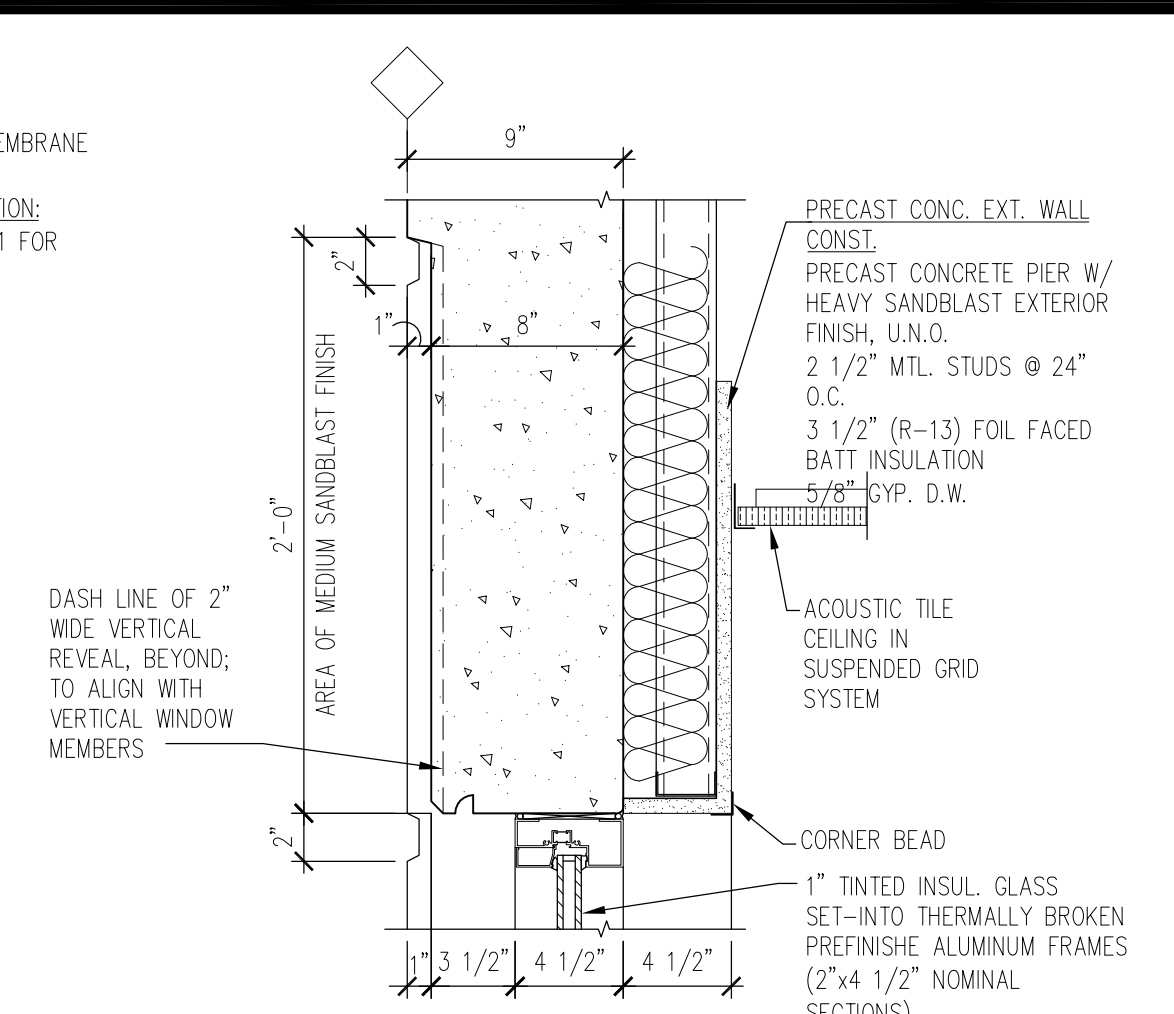


6 WINDOW HEAD DETAIL
A402 Scale: 1 1/2" = 1'-0"

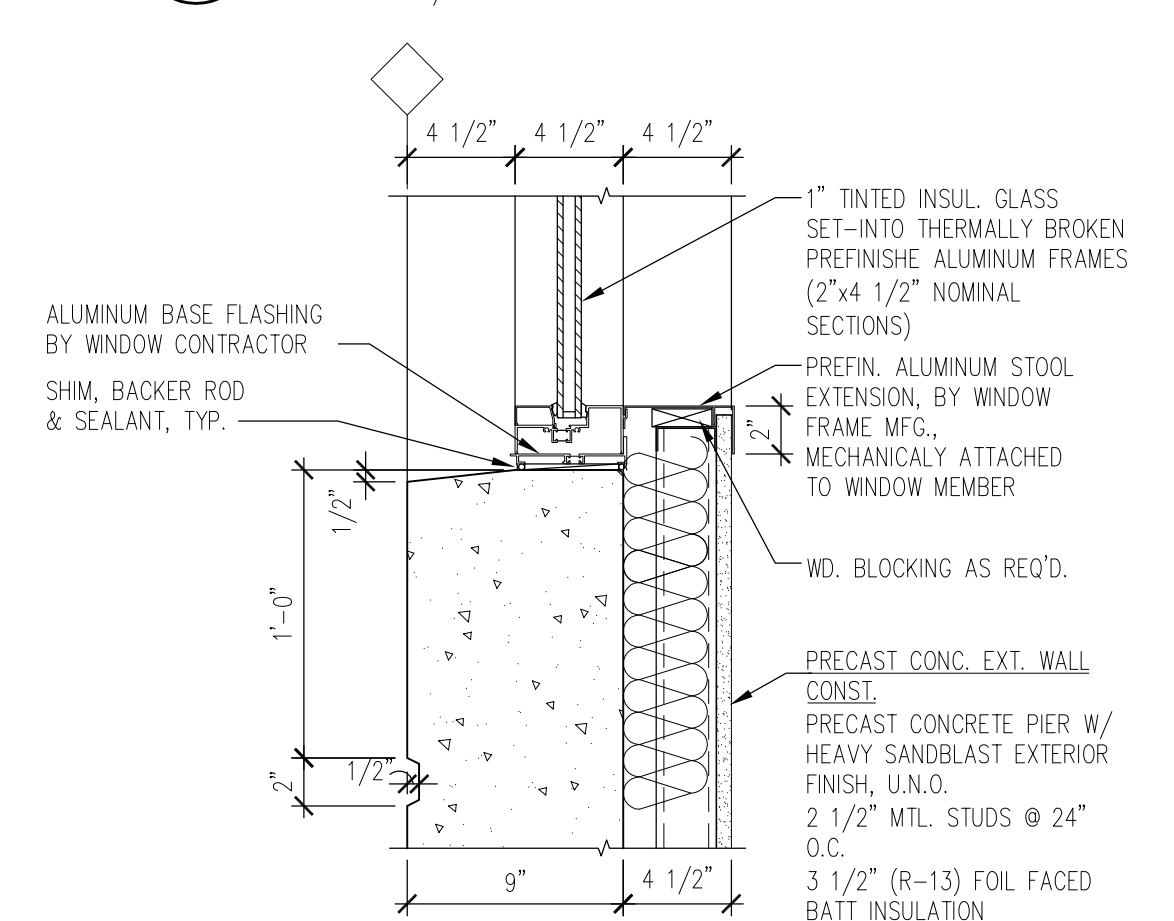


7 WINDOW SILL DETAIL
A402 Scale: 1 1/2" = 1'-0"

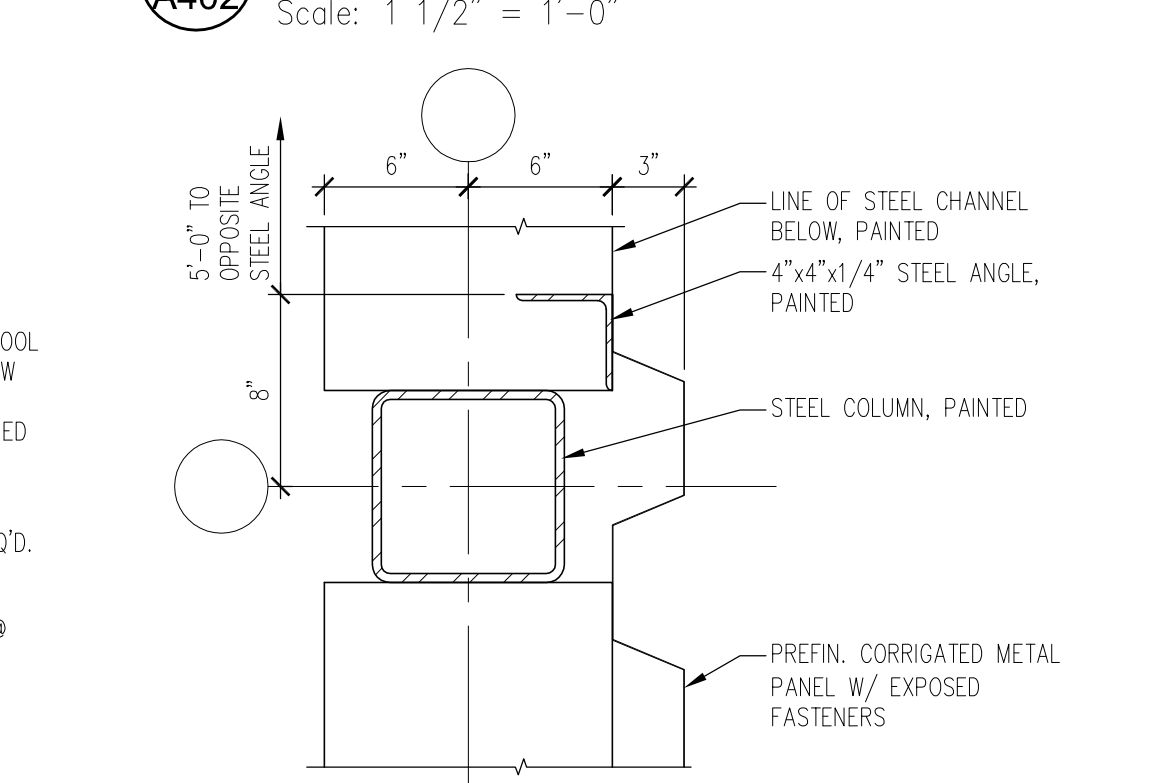


11 SCREENWALL OPN'G. DTL.
A402 Scale: 1 1/2" = 1'-0"

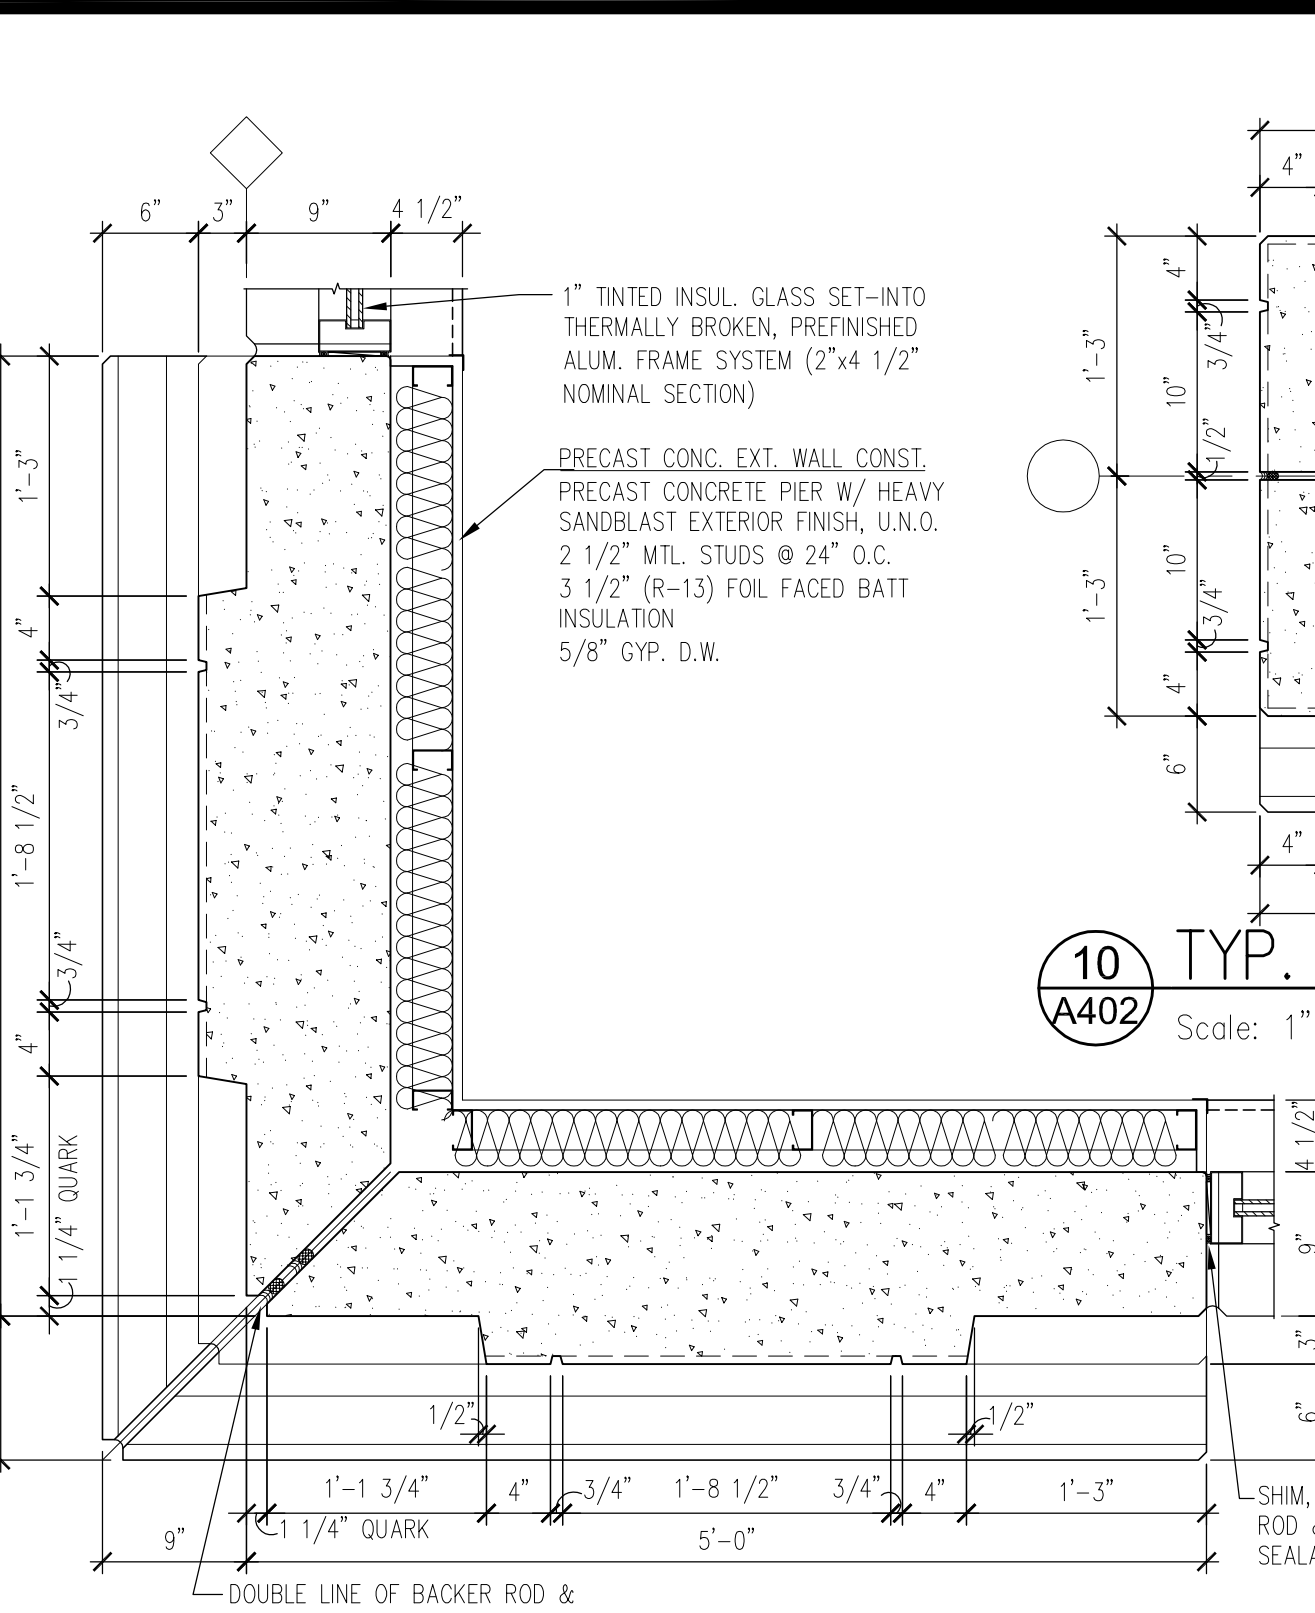

8 TYP. CORNER PIER DETAIL
A402 Scale: 1" = 1'-0"

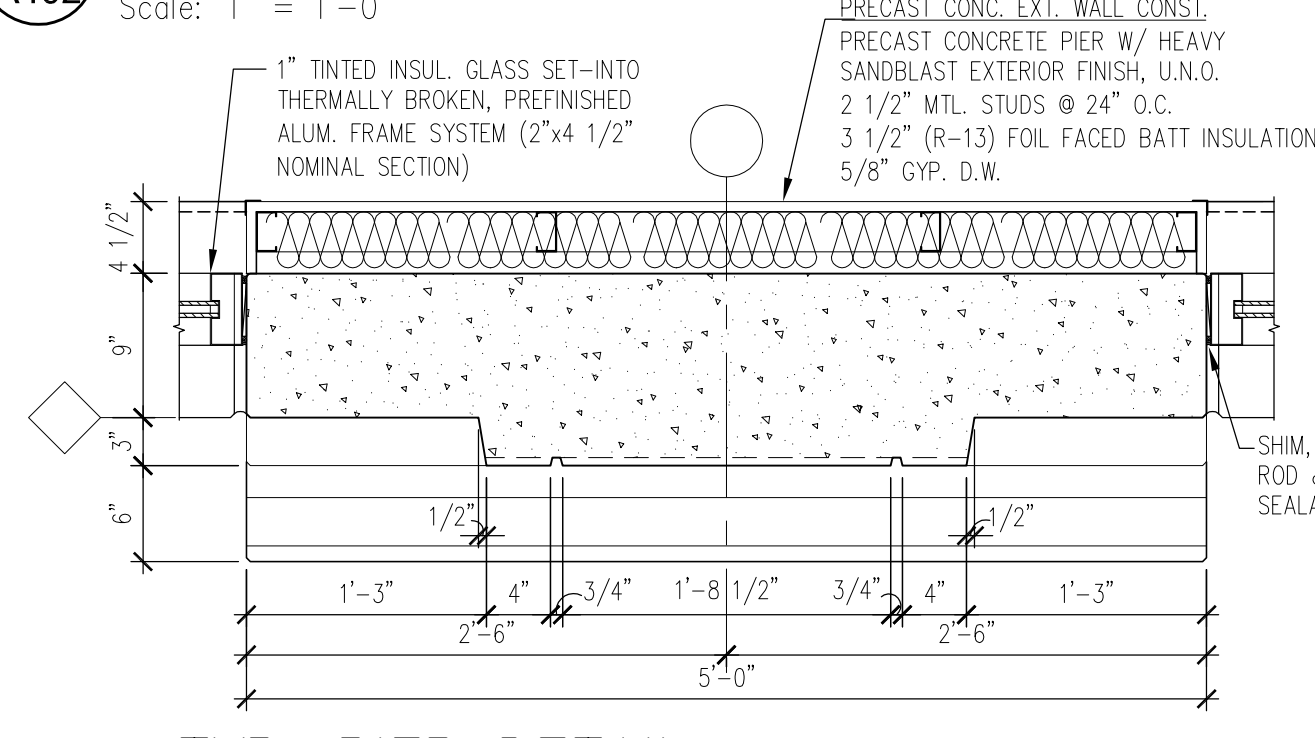

9 TYP. PIER DETAIL
A402 Scale: 1" = 1'-0"

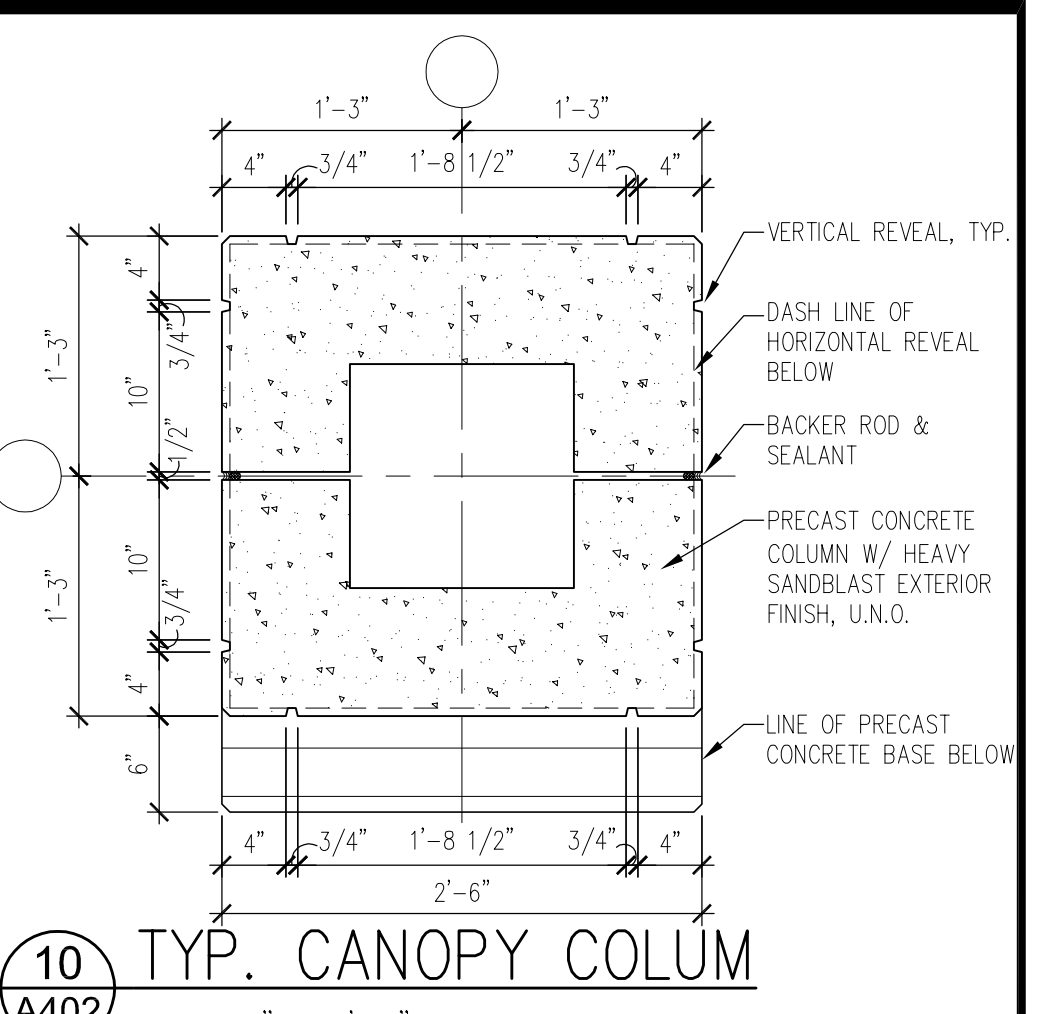

10 TYP. CANOPY COLUMN
A402 Scale: 1" = 1'-0"

Duke

CONSTRUCTION

4225 Naperville Road

Suite 150

Lincolnshire, IL 60532

Phone: (630) 577-7900

Fax: (630) 577-7979

TMA

Architects - Planners

Timothy Morgan Associates

200 Tri-State International Center

Suite 100

Lincolnshire, Illinois 60069

847 374-0058 phone

847 374-0057 fax

Revisions:

5/10/05 Initial Building Permit Submittal

7/8/05 Indication of precast finish

8/23/05 Shell Construction Set

10/14/05 Rev's-Owner Finish

03/12/06 Rev. Mtg

Scale: 1/8"=1'

Date: 03/12/06

Drawn By: SBT

Checked By:

PARAGON GLOBAL RESOURCES

CANTERA CORPORATE CENTER - LOT 1

27501 BELLA VISTA PARKWAY

WARRENVILLE, ILLINOIS

WALL SECTIONS, DETAILS

Certified By:

Drawing Number:

A402


Of Sheets

Duke Realty Job Number:

PARAGN-001

A/E Job Number:

04-094

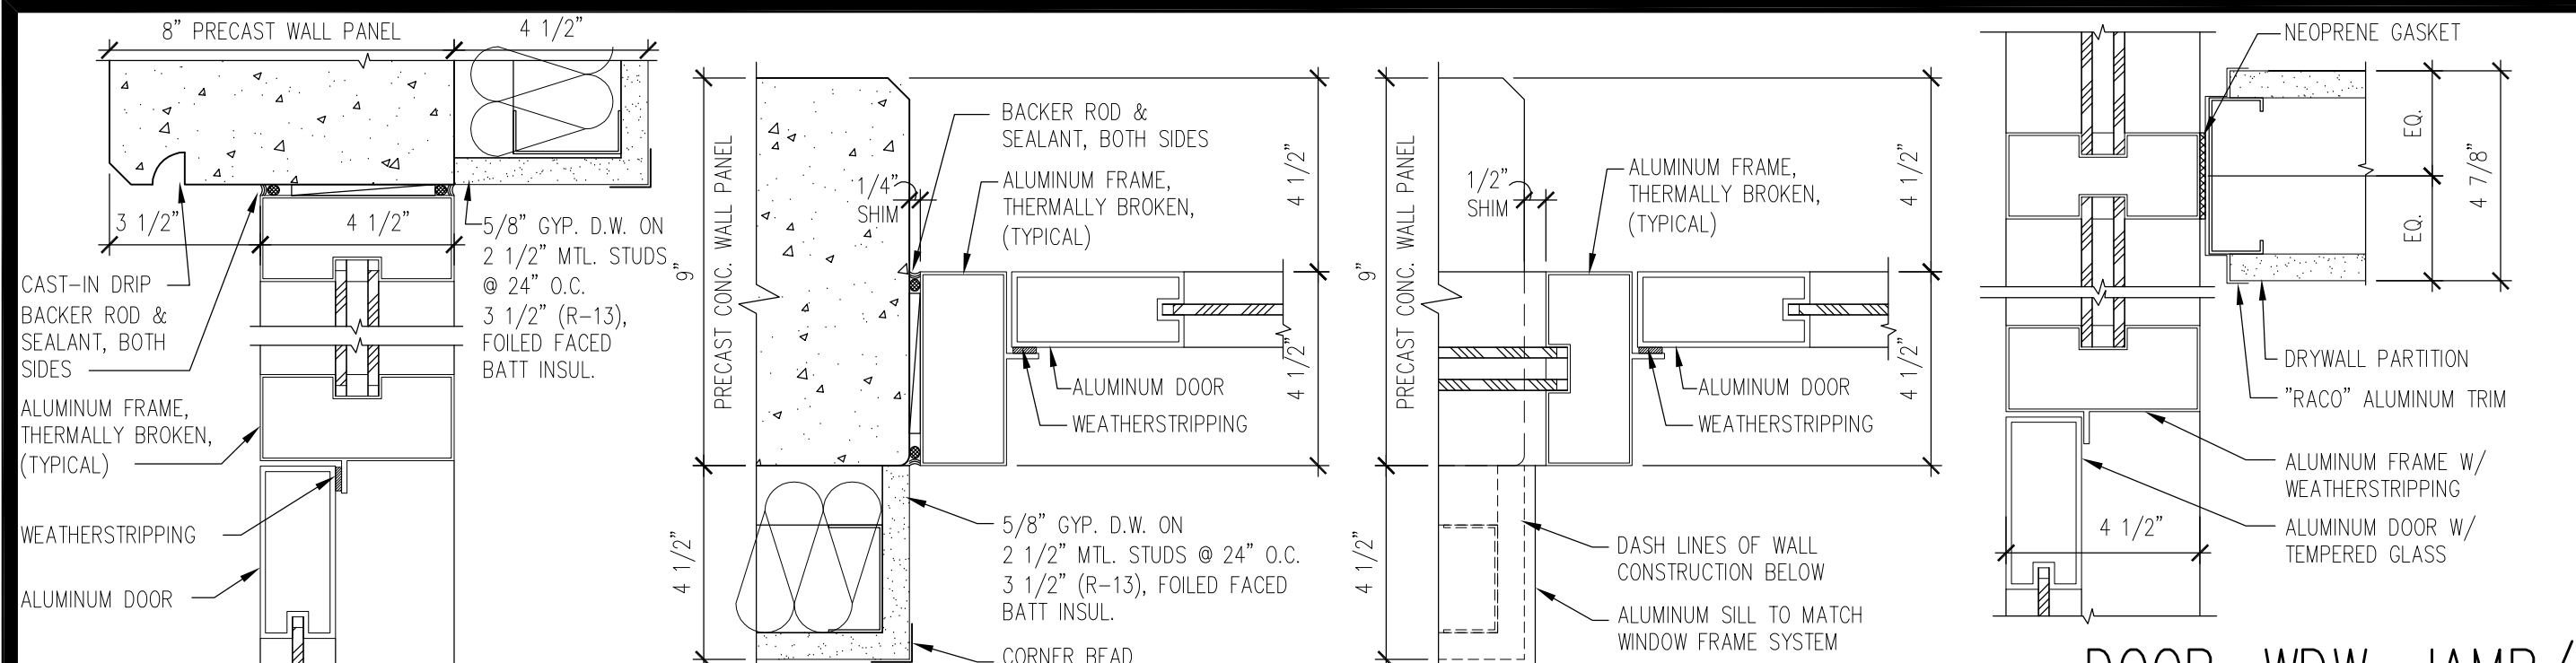


1 DOOR HEAD JAMB SIM.
A501 Scale: 3" = 1'-0"

2 DOOR JAMB
A501 Scale: 3" = 1'-0"

3 DOOR JAMB
A501 Scale: 3" = 1'-0"

4 DOOR, WDW. JAMB/DEMISING WALL
A501 Scale: 3" = 1'-0"

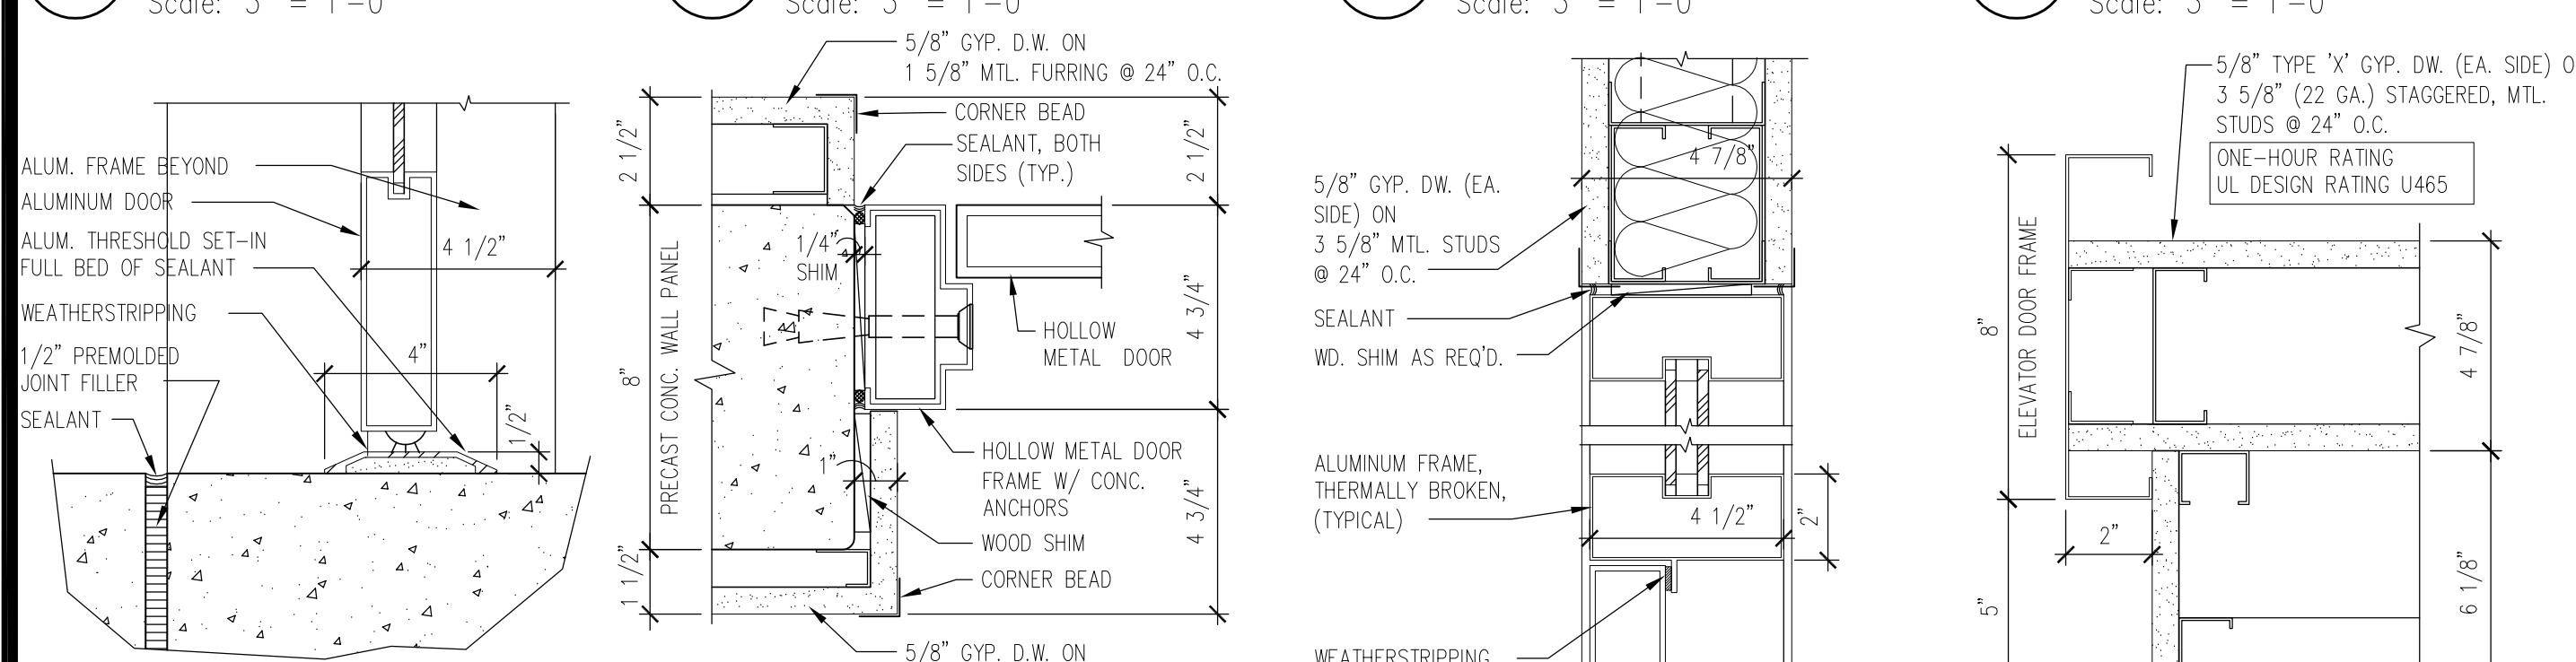


5 DOOR SILL
A501 Scale: 3" = 1'-0"

6 DOOR JAMB HEAD SIMILAR
A501 Scale: 3" = 1'-0"

7 DOOR HEAD
A501 Scale: 3" = 1'-0"


8 ELEV. DOOR JAMB
A501 Scale: 3" = 1'-0"

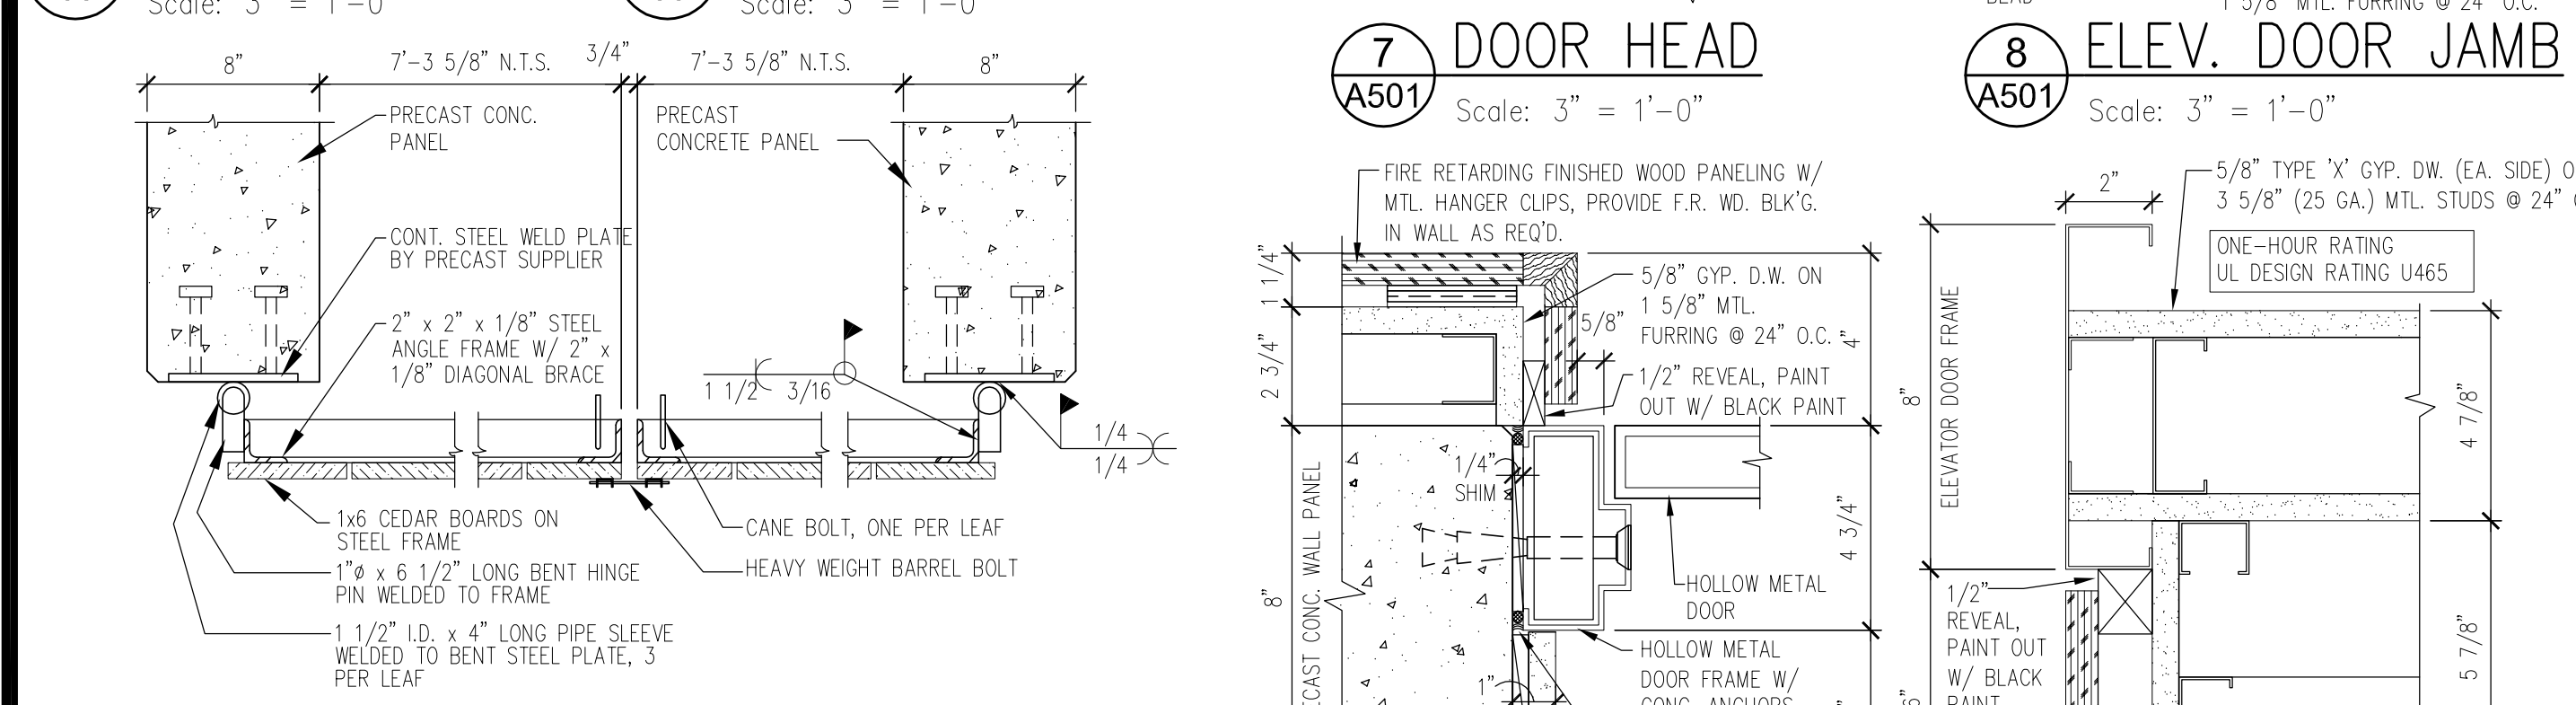

9 TRASH GATE DETAIL
A501 Scale: 1 1/2" = 1'-0"


10 DOOR JAMB HEAD SIMILAR
A501 Scale: 3" = 1'-0"

11 ELEV. DOOR JAMB
A501 Scale: 3" = 1'-0"

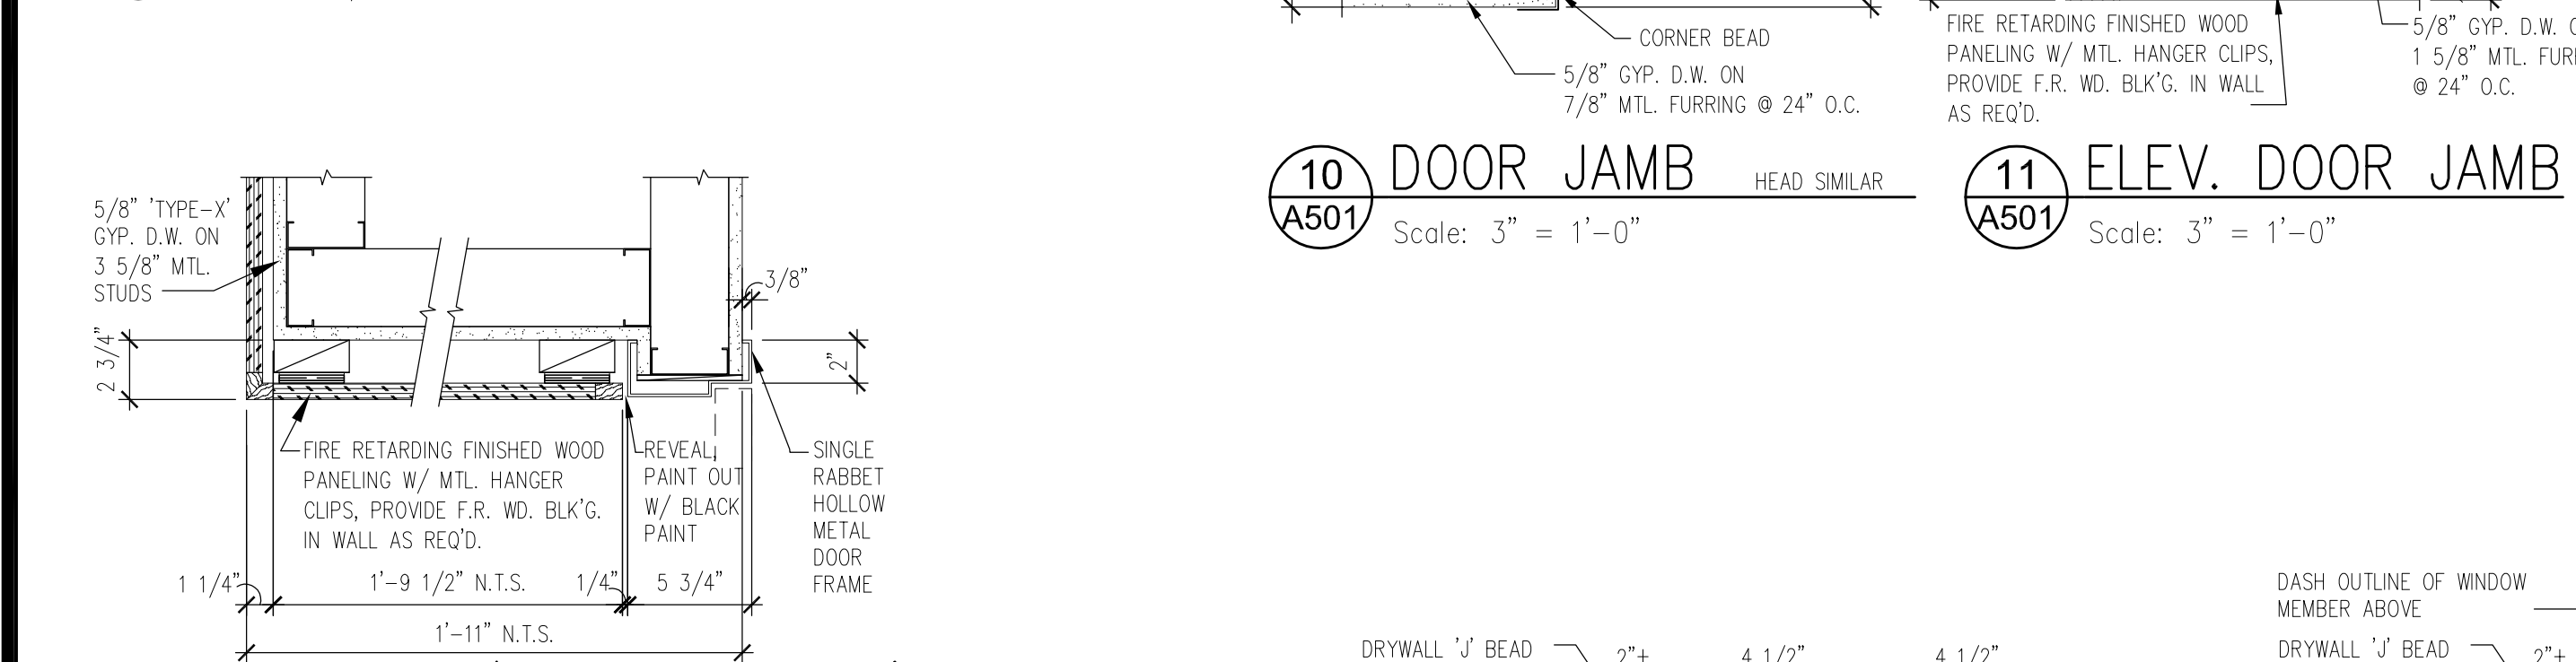

12 WD. PANEL/DR. JAMB OPN'G.
A501 Scale: 1 1/2" = 1'-0"

13 DOOR JAMB HEAD SIMILAR
A501 Scale: 3" = 1'-0"

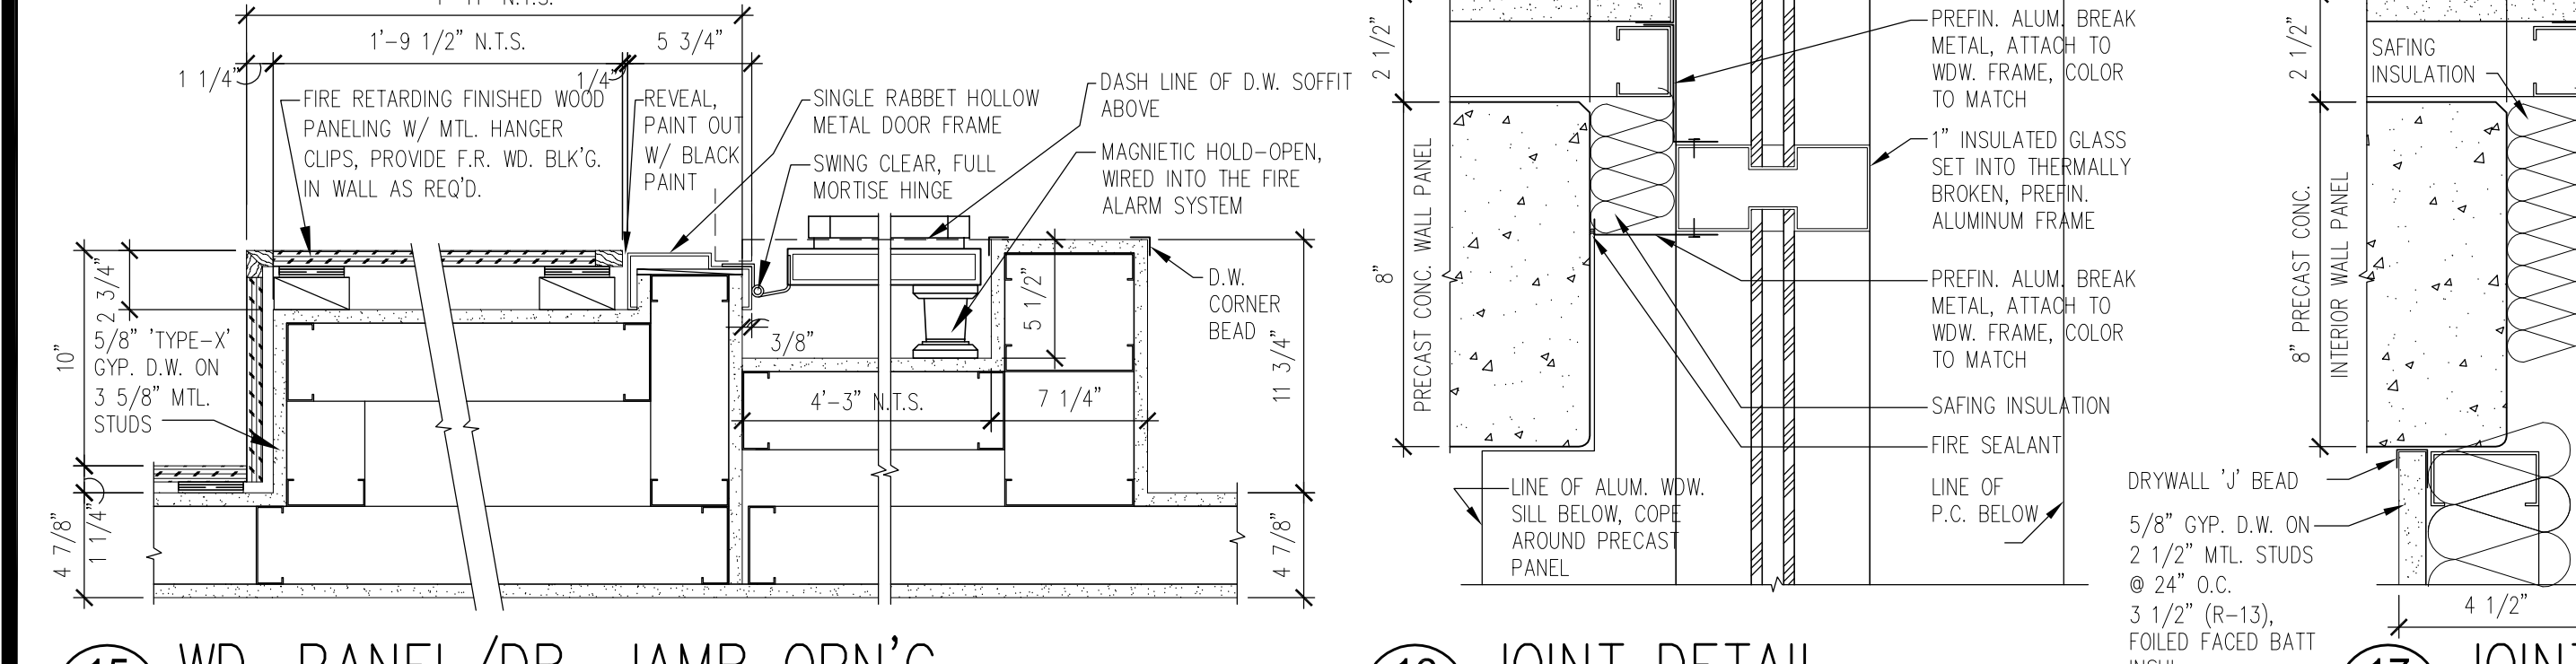



15 WD. PANEL/DR. JAMB OPN'G.
A501 Scale: 1 1/2" = 1'-0"

16 JOINT DETAIL
A501 Scale: 3" = 1'-0"

17 JOINT DETAIL
A501 Scale: 3" = 1'-0"

18 DOOR JAMB HEAD SIMILAR
A501 Scale: 3" = 1'-0"

DOOR NUMBER		DOOR				FRAME				HARDWARE													DOOR REMARKS:							
		SIZE			MATERIAL	TYPE	LOUVER		MATERIAL	TYPE	DETAILS				FIRE RATING IN HOURS	CLOSER	PANIC	LOCK SET	LATCH SET	PRIVATE LOCK	PUSH/PULL	KICK PLATE	WALL STOP	THRESHOLD	180° REEPPHOLE	SIGNAGE	FLUSH BOLTS	No. PAIR BUTTS	SEE LISTING NEXT TO SCHEDULE	
		WIDTH	HEIGHT	THICK.	WIDTH	HEIGHT	JAMB	HEAD	SILL	1	2	3	4	5	6	7	8	9	10	11	12	13								
100	3'-0"	8'-0"	1 3/4"	ALUM./GLASS	1				ALUM.	A	2&3	1	5		1		3											2		5, PUSH PADDLE LOCK SET
101A	(2)3'-0"	8'-0"	1 3/4"	ALUM./GLASS	1				ALUM.	A	4	1	5		1		3				6		9	10				4	5 & 10	
101B	(2)3'-0"	8'-0"	1 3/4"	ALUM./GLASS	1				ALUM.	B	1 SIM.	7	5 SIM.		1						6		9	10				4		
102A	(2)3'-0"	8'-0"	1 3/4"	ALUM./GLASS	1				ALUM.	A	4	1	5		1		3				6		9	10				4	5 & 10	
102B	(2)3'-0"	8'-0"	1 3/4"	ALUM./GLASS	1				ALUM.	B	1 SIM.	7	5 SIM.		1						6		9	10				4		
103A	4'-0"	8'-0"	1 3/4"	WOOD	2				H.M.	A	12&13	12 SIM.		1	1	2		4										2	12, 13	
103B	4'-0"	8'-0"	1 3/4"	WOOD	2				H.M.	A	12&13	12 SIM.		1	1	2		4										2	12, 13	
104	3'-0"	8'-0"	1 3/4"	WOOD	2				H.M.	A	13	13 SIM.		1	1		3											2		
105	3'-0"	8'-0"	1 3/4"	WOOD	2				H.M.	A	13	13 SIM.					3											2		
107	3'-0"	8'-0"	1 3/4"	WOOD	2	24"	12"		H.M.	A	13	13 SIM.									6	7	8			11		2	6, PROGRAMMABLE / KEYPAD LOCKING SYSTEM	
108	3'-0"	8'-0"	1 3/4"	WOOD	2	24"	12"		H.M.	A	13	13 SIM.									6	7	8			11		2	6, PROGRAMMABLE / KEYPAD LOCKING SYSTEM	
109	3'-0"	8'-0"	1 3/4"	WOOD	2				H.M.	A	13	13 SIM.		1	1		3									11		2	9	
110A	3'-0"	8'-0"	1 3/4"	WOOD	2				H.M.	A	13	13 SIM.					3											2		
110B	(2)3'-0"	8'-0"	1 3/4"	WOOD	2				H.M.	A	13	13 SIM.		1	1		3										13	4		
111A	(2)3'-0"	8'-0"	1 3/4"	WOOD	2				H.M.	A	13	13 SIM.		1	1		3											13	4	
111B	3'-0"	8'-0"	1 3/4"	WOOD	2				H.M.	A	13	13 SIM.		1	1		3											2		
112A	3'-0"	8'-0"	1 3/4"	ALUM./GLASS	1				ALUM.	A	2&3	1	5		1		3											2		
112B	(2)3'-0"	8'-0"	1 3/4"	WOOD	2				H.M.	A	13	13 SIM.					3											13	4	
112C	3'-0"	8'-0"	1 3/4"	WOOD	2				H.M.	A	13	13 SIM.					3											2		
112D	3'-0"	8'-0"	1 3/4"	WOOD	2				H.M.	A	13	13 SIM.		1	1		3											2		
201	3'-0"	8'-0"	1 3/4"	WOOD	2	24"	12"		H.M.	A	13	13 SIM.									6	7	8			11		2	6	
202	3'-0"	8'-0"	1 3/4"	WOOD	2	24"	12"		H.M.	A	13	13 SIM.									6	7	8			11		2	6	
203	3'-0"	8'-0"	1 3/4"	WOOD	2				H.M.	A	13	13 SIM.					3										11		2	
ST1-A	3'-0"	8'-0"	1 3/4"	WOOD	2				H.M.	A	10	10 SIM.		1	1			4										2		
ST1-B	3'-0"	8'-0"	1 3/4"	WOOD	2				H.M.	A	6	6 SIM.		1	1			4										2		
ST2-A	3'-0"	8'-0"	1 3/4"	ALUM./GLASS	1				ALUM.	A	2&3	1	5		1		3											2		
ST2-B	3'-0"	8'-0"	1 3/4"	WOOD	2				H.M.	A	6 SIM.	6 SIM.		1	1			4										2		
ST2-C	3'-0"	8'-0"	1 3/4"	WOOD	2				H.M.	A	6 SIM.	6 SIM.		1	1			4										2		

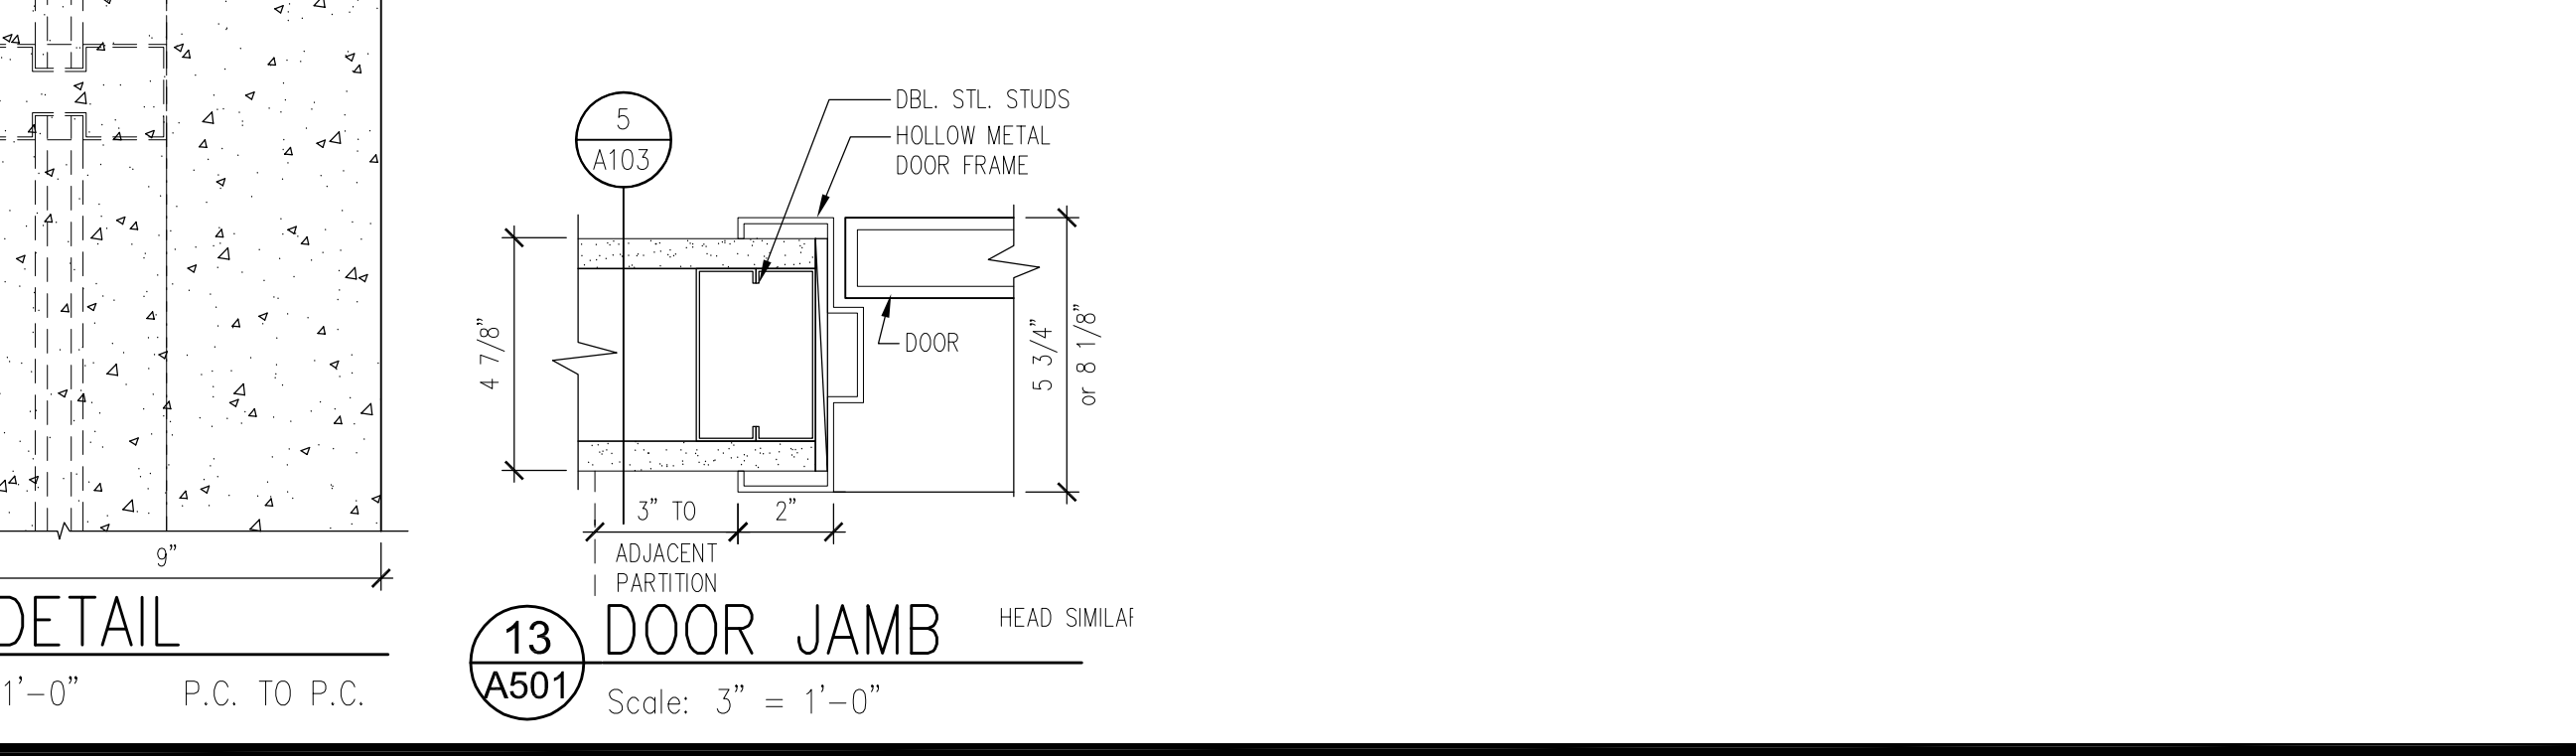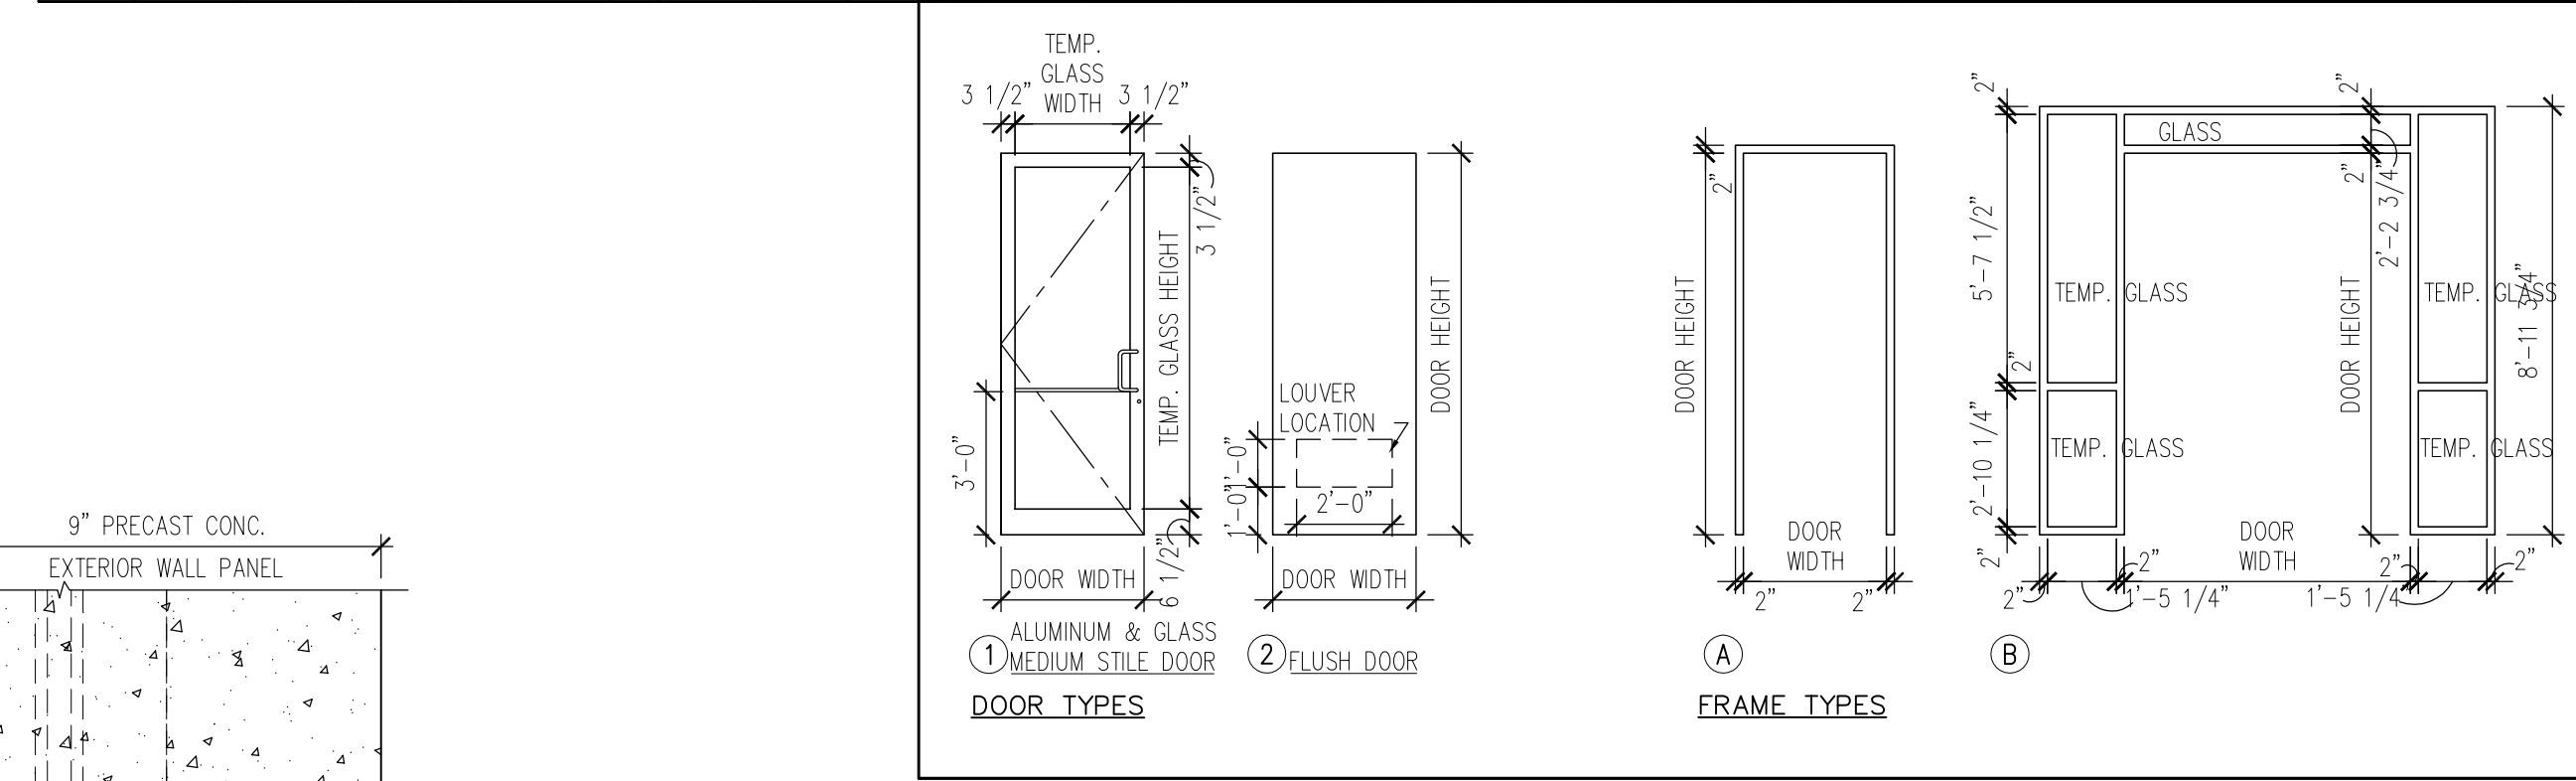

14 DOOR JAMB HEAD SIMILAR
A501 Scale: 3" = 1'-0"

15 DOOR JAMB HEAD SIMILAR
A501 Scale: 3" = 1'-0"

16 DOOR JAMB HEAD SIMILAR
A501 Scale: 3" = 1'-0"

17 DOOR JAMB HEAD SIMILAR
A501 Scale: 3" = 1'-0"

18 DOOR JAMB HEAD SIMILAR
A501 Scale: 3" = 1'-0"

DOOR REMARK NOTES:

- ALL DOOR HANDLES TO BE LEVER TYPE, WITH NO TIGHT GRASPING OR PINCHING OR TWISTING OF THE WRIST TO OPERATE ON THE EGRESS SIDE.
- ALL EGRESS SIDE OF EXIT DOORS TO OPERATE WITH-OUT THE USE OF A KEY.
- ALL HOLLOW METAL DOOR & FRAMES TO BE PAINTED. ALL WOOD DOORS TO BE PREFINISHED.
- ALL DOOR FRAMES TO HAVE SILENCERS.
- ALL HINGES TO EXTERIOR SWING DOORS SHALL BE PROVIDED WITH NON-REMOVABLE PINS (N.R.P.).
- RESTROOM SIGNAGE: LETTERS SHALL BE RAISED 1/32 in. UPPER CASE AND SHALL BE ACCOMPANIED WITH GRADE 2 BRILLE. PICTOGRAMS SHALL BE ACCOMPANIED BY THE EQUIVALENT VERBAL DESCRIPTION PLACED DIRECTLY BELOW THE PICTOGRAM. SIGN SHALL BE INSTALLED ON THE WALL ADJACENT TO THE LATCH SIDE OF THE DOOR, MOUNTED 60 in. ABOVE THE FINISHED FLOOR SURFACE TO THE CENTERLINE OF THE SIGN.
- SWEEP PERIOD FOR DOOR CLOSERS SHALL BE ADJUSTED SO THAT FROM AN OPEN POSITION OF 70 DEGREES, THE DOOR WILL TAKE AT LEAST 3 SECONDS TO MOVE TO A POINT 3 INCHES FROM THE LATCH.
- DOOR OPENING FORCE: THE MAXIMUM FORCE FOR PUSHING OR PULLING OPEN A DOOR SHALL BE AS FOLLOWS: INTERIOR HINGED DOORS: 8.5 lbf (37.8N). INTERIOR HINGED DOORS: 5 lbf (22.2N). SLIDING OR FOLDING DOORS: 5 lbf (22.2N)
- TEXTURED OR KNURLD SURFACE SHALL BE PROVIDED ON DOOR HANDLE TO ROOM 104 AND 109.
- LOCK/LATCH SET W/ CYLINDER ON ACTIVE LEAF; FLUSH BOLT ON INACTIVE LEAF. PUSH/PADDLE ON INTERIOR.
- PROVIDE 12" CLEAR SPACE BETWEEN THE EDGE OF THE DOOR OPENING AND ADJACENT WALL AT THE PUSH SIDE OF THE DOOR; AND 18" CLEAR SPACE BETWEEN THE DOOR AND ADJACENT WALL ON THE PULL SIDE OF THE DOOR.
- DOOR WITH MAGNETIC HOLD-OPEN TO BE TIED INTO THE BUILDINGS EMERGENCY ALARM SYSTEM. PANIC DEVICE WITH MORTISE LATCH AND SWING CLEAR, FULL MORTISE HINGES.
- PAINT GRADE WOOD DOOR.

Duke
CONSTRUCTION
4225 Naperville Road
Suite 150
Lisle, IL 60532
Phone: (630) 577-7900
Fax: (630) 577-7979

TMA
Architects - Planners
Timothy Morgan Associates
200 Tri-State International Center
Suite 100
Lincolnshire, Illinois 60069
847 374-0058 phone
847 374-0057 fax





Revisions:
5/10/05 Initial Building Permit Submittal
6/29/05 Building Permit Resubmittal
8/23/05 Shell Construction Set
10/14/05 Rev's-Owner Finish Rev. Mtg
---/---/--- Joint details
03/12/06 - Record Set

Scale: 1/8"=1'
Date: 03/12/06
Drawn By: SBT
Checked By:


PARAGON GLOBAL RESOURCES
CANTERA CORPORATE CENTER - LOT 1
27501 BELLA VISTA PARKWAY
WARRENVILLE, ILLINOIS

Certified By:

Drawing Number:
A501
Of Sheets
Duke Realty Job Number:
PARAGN-001
A/E Job Number:
04-094

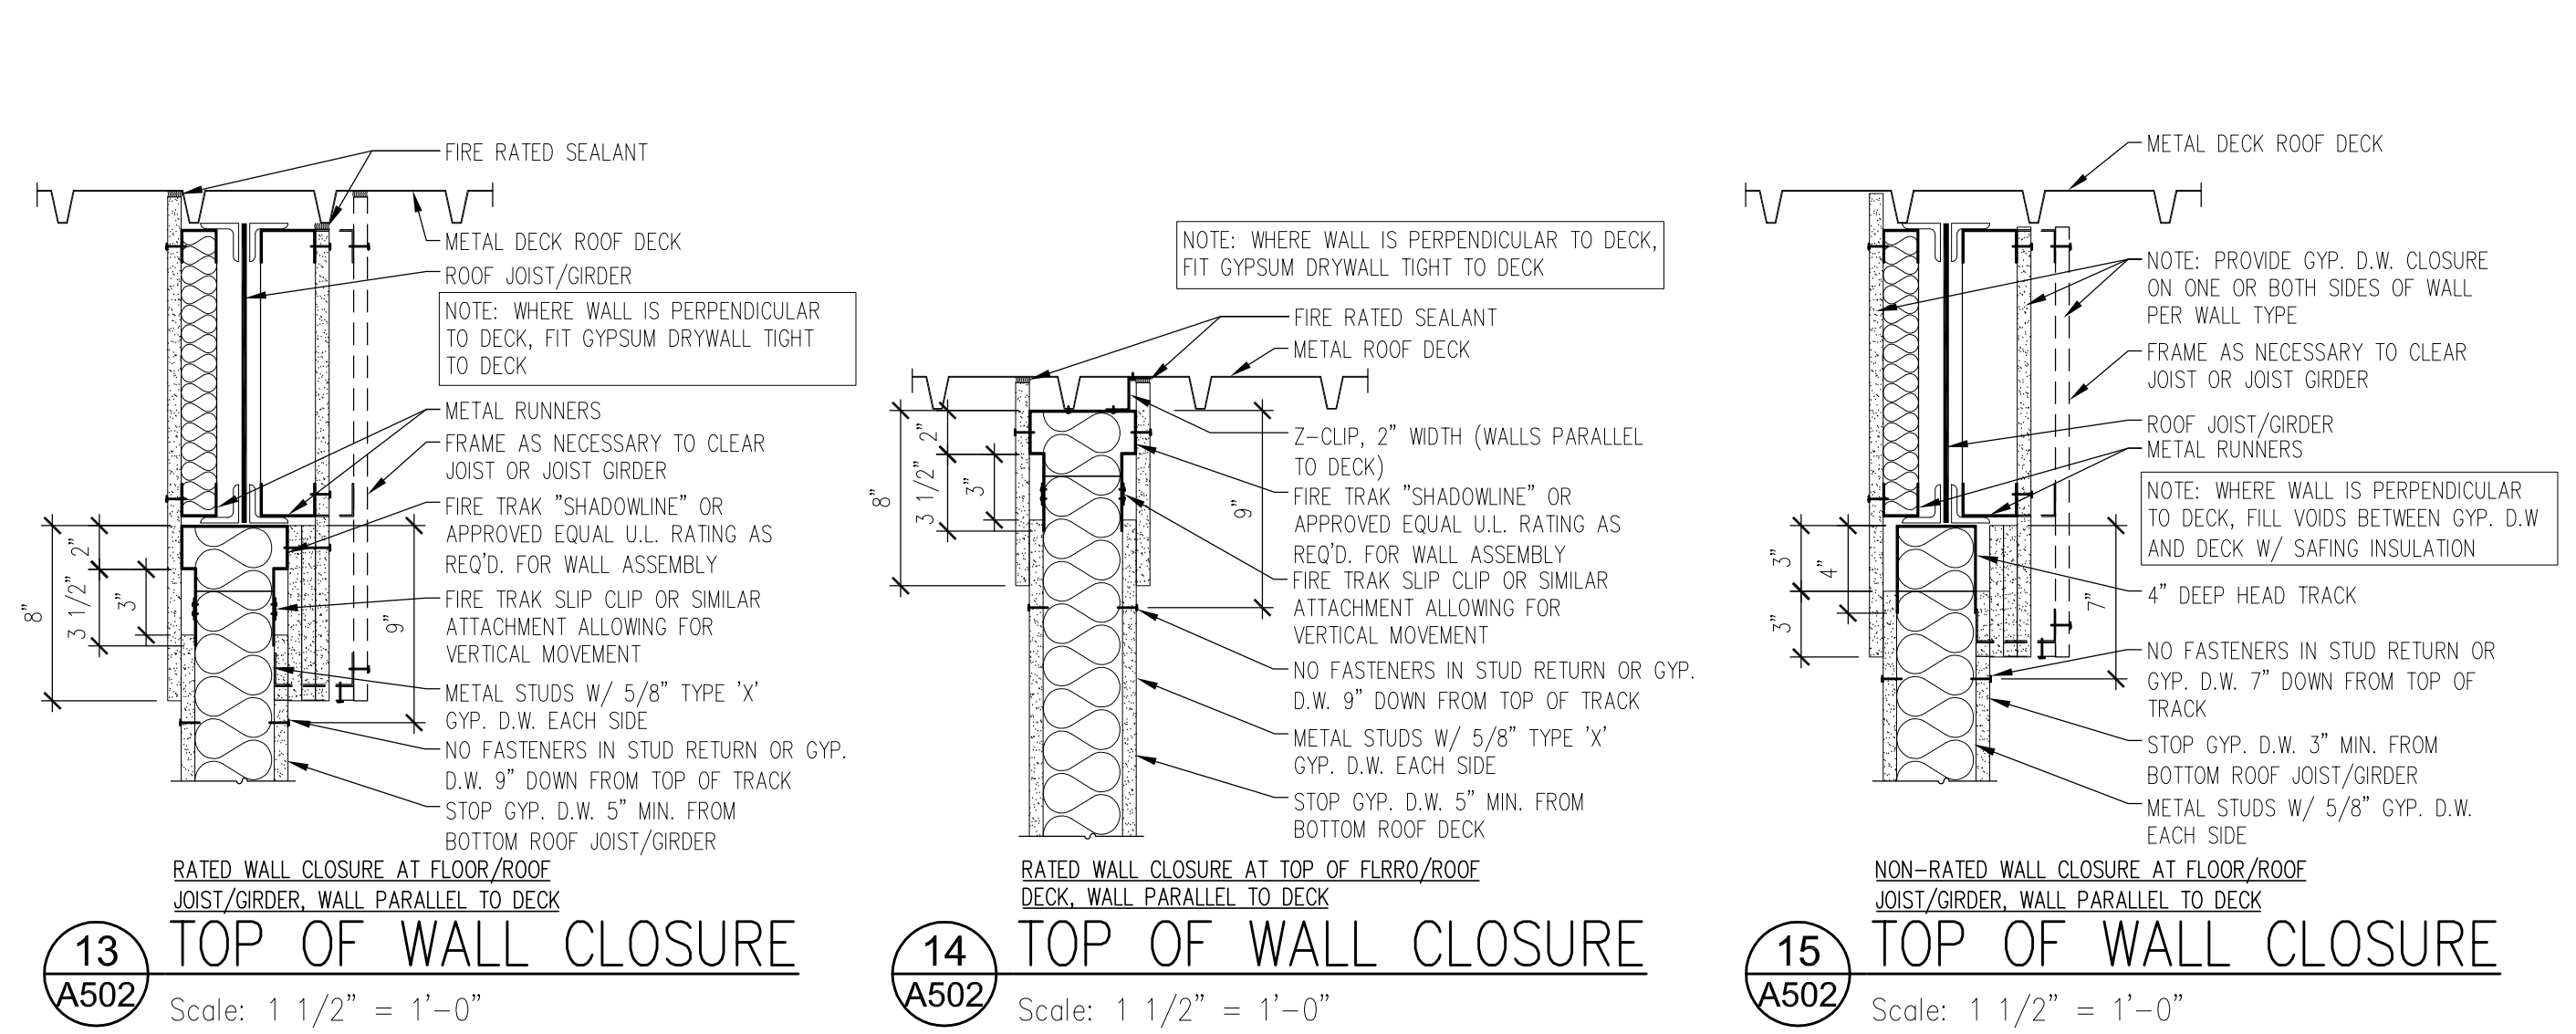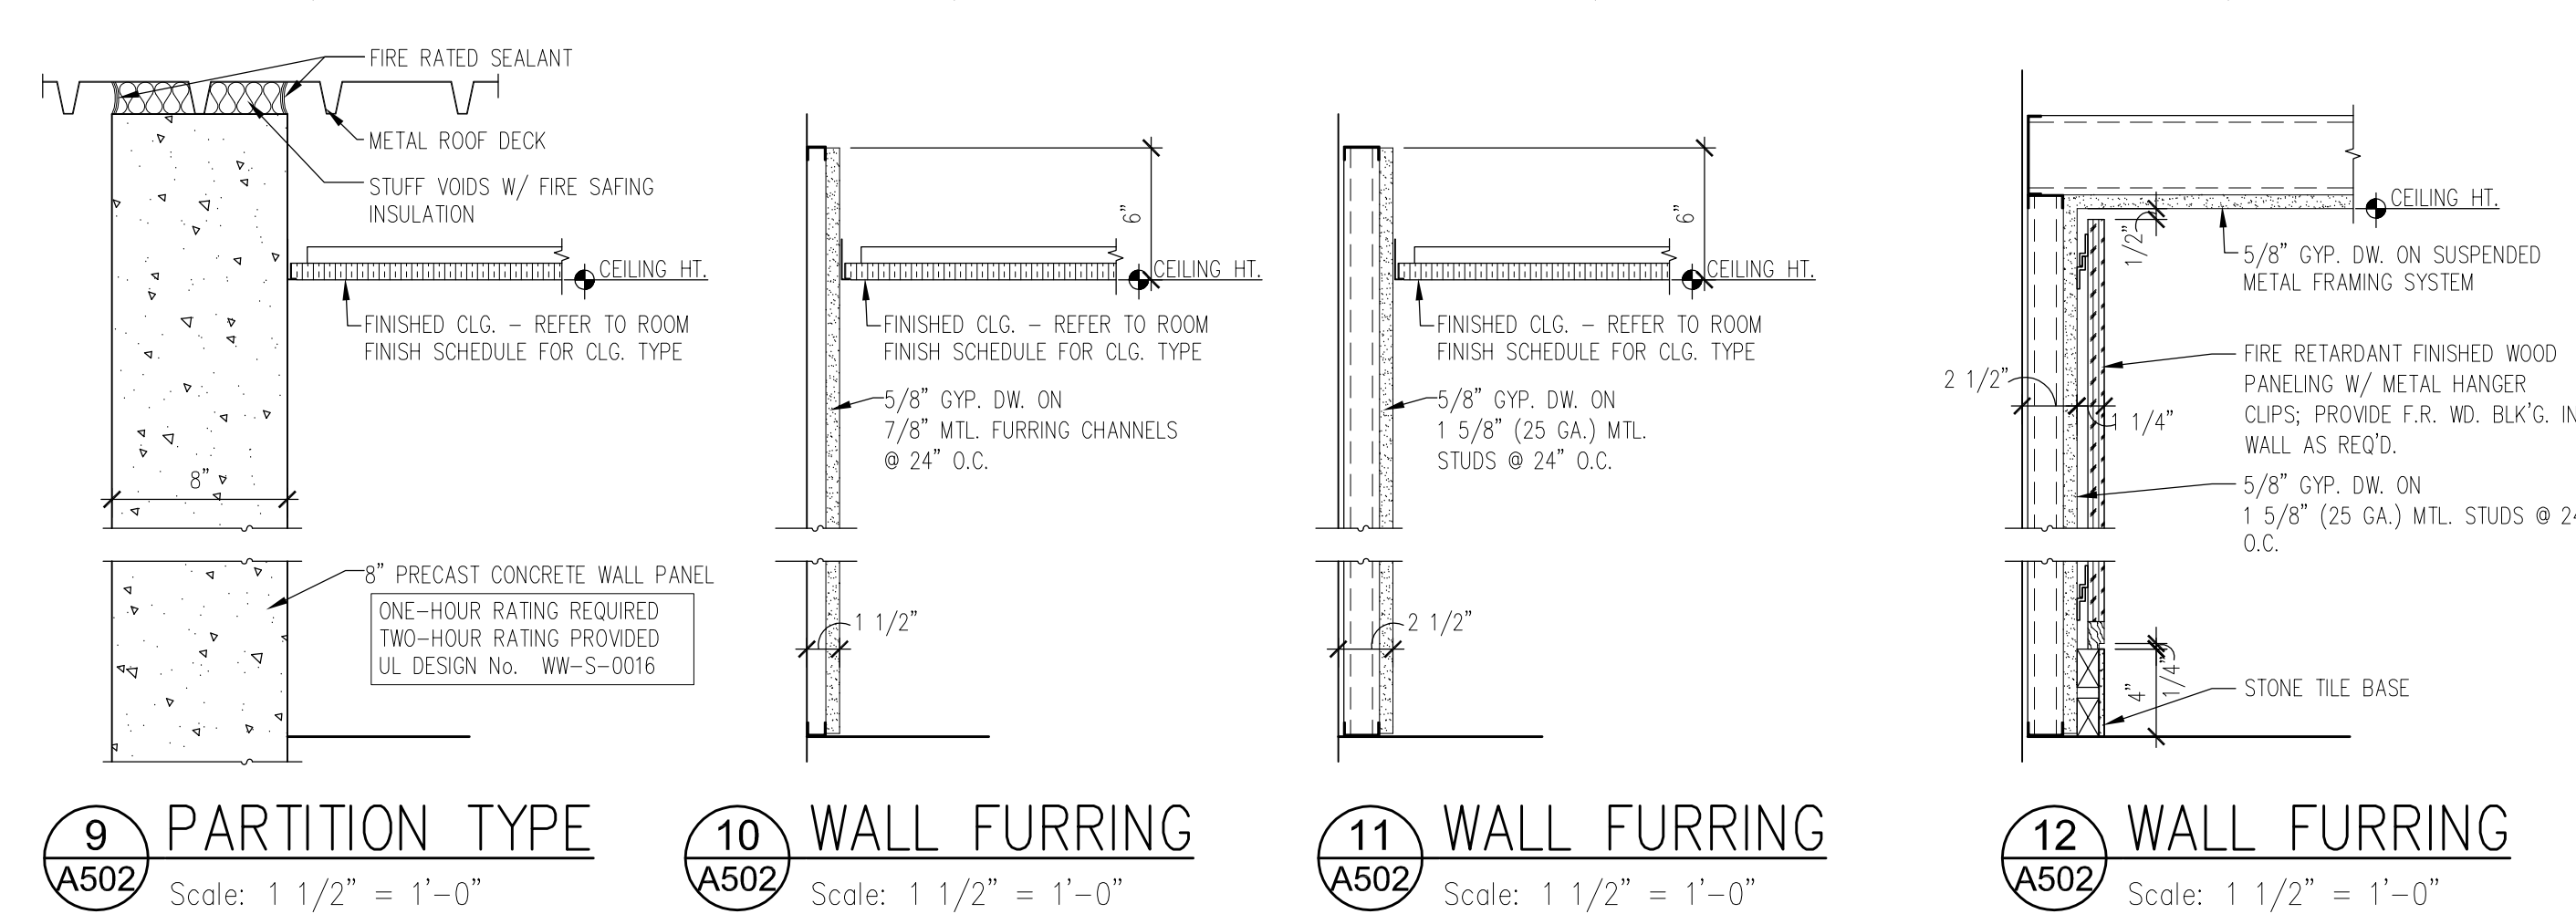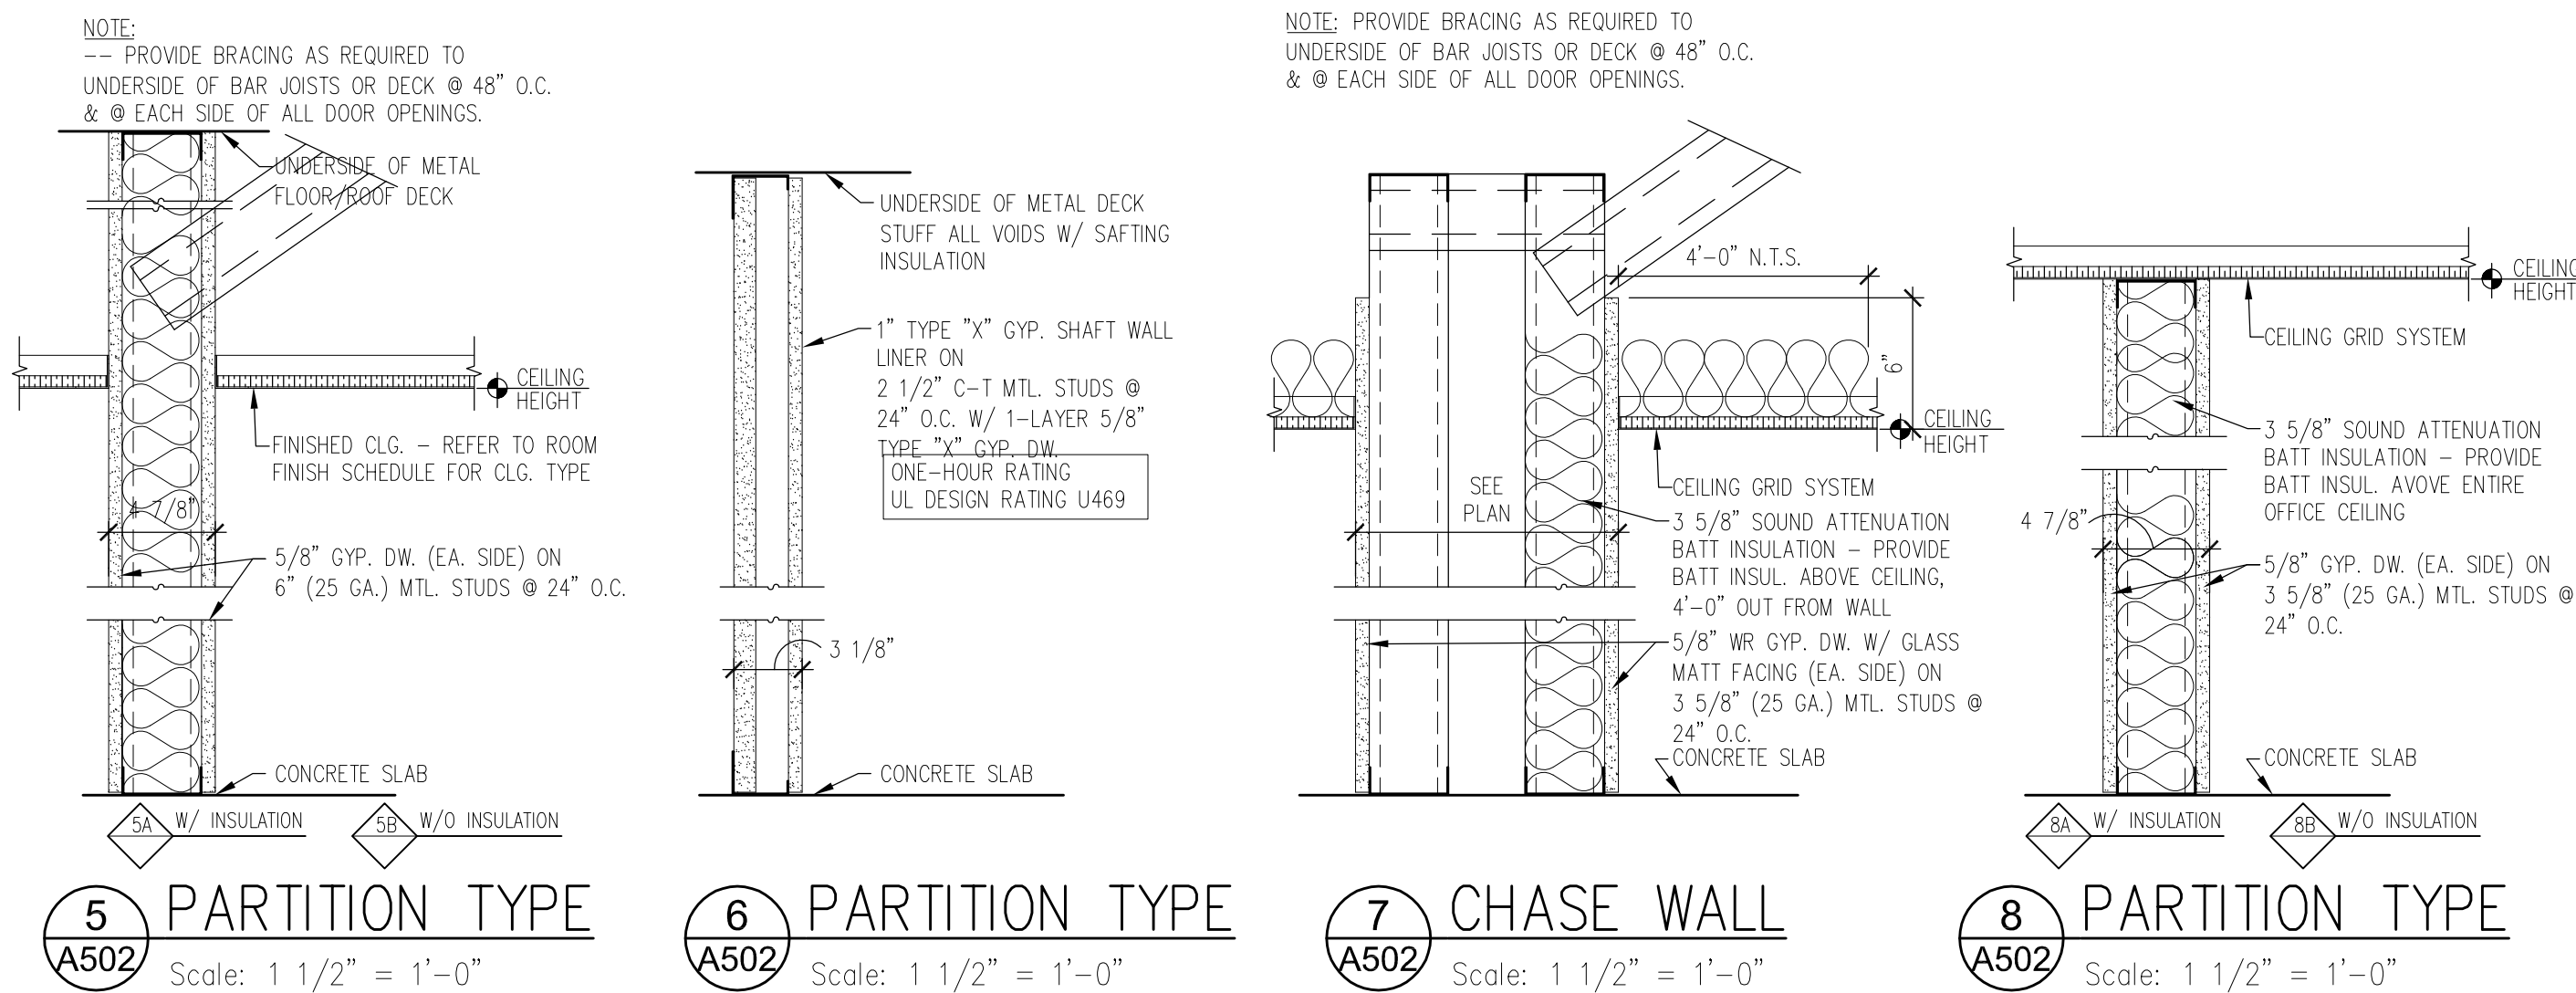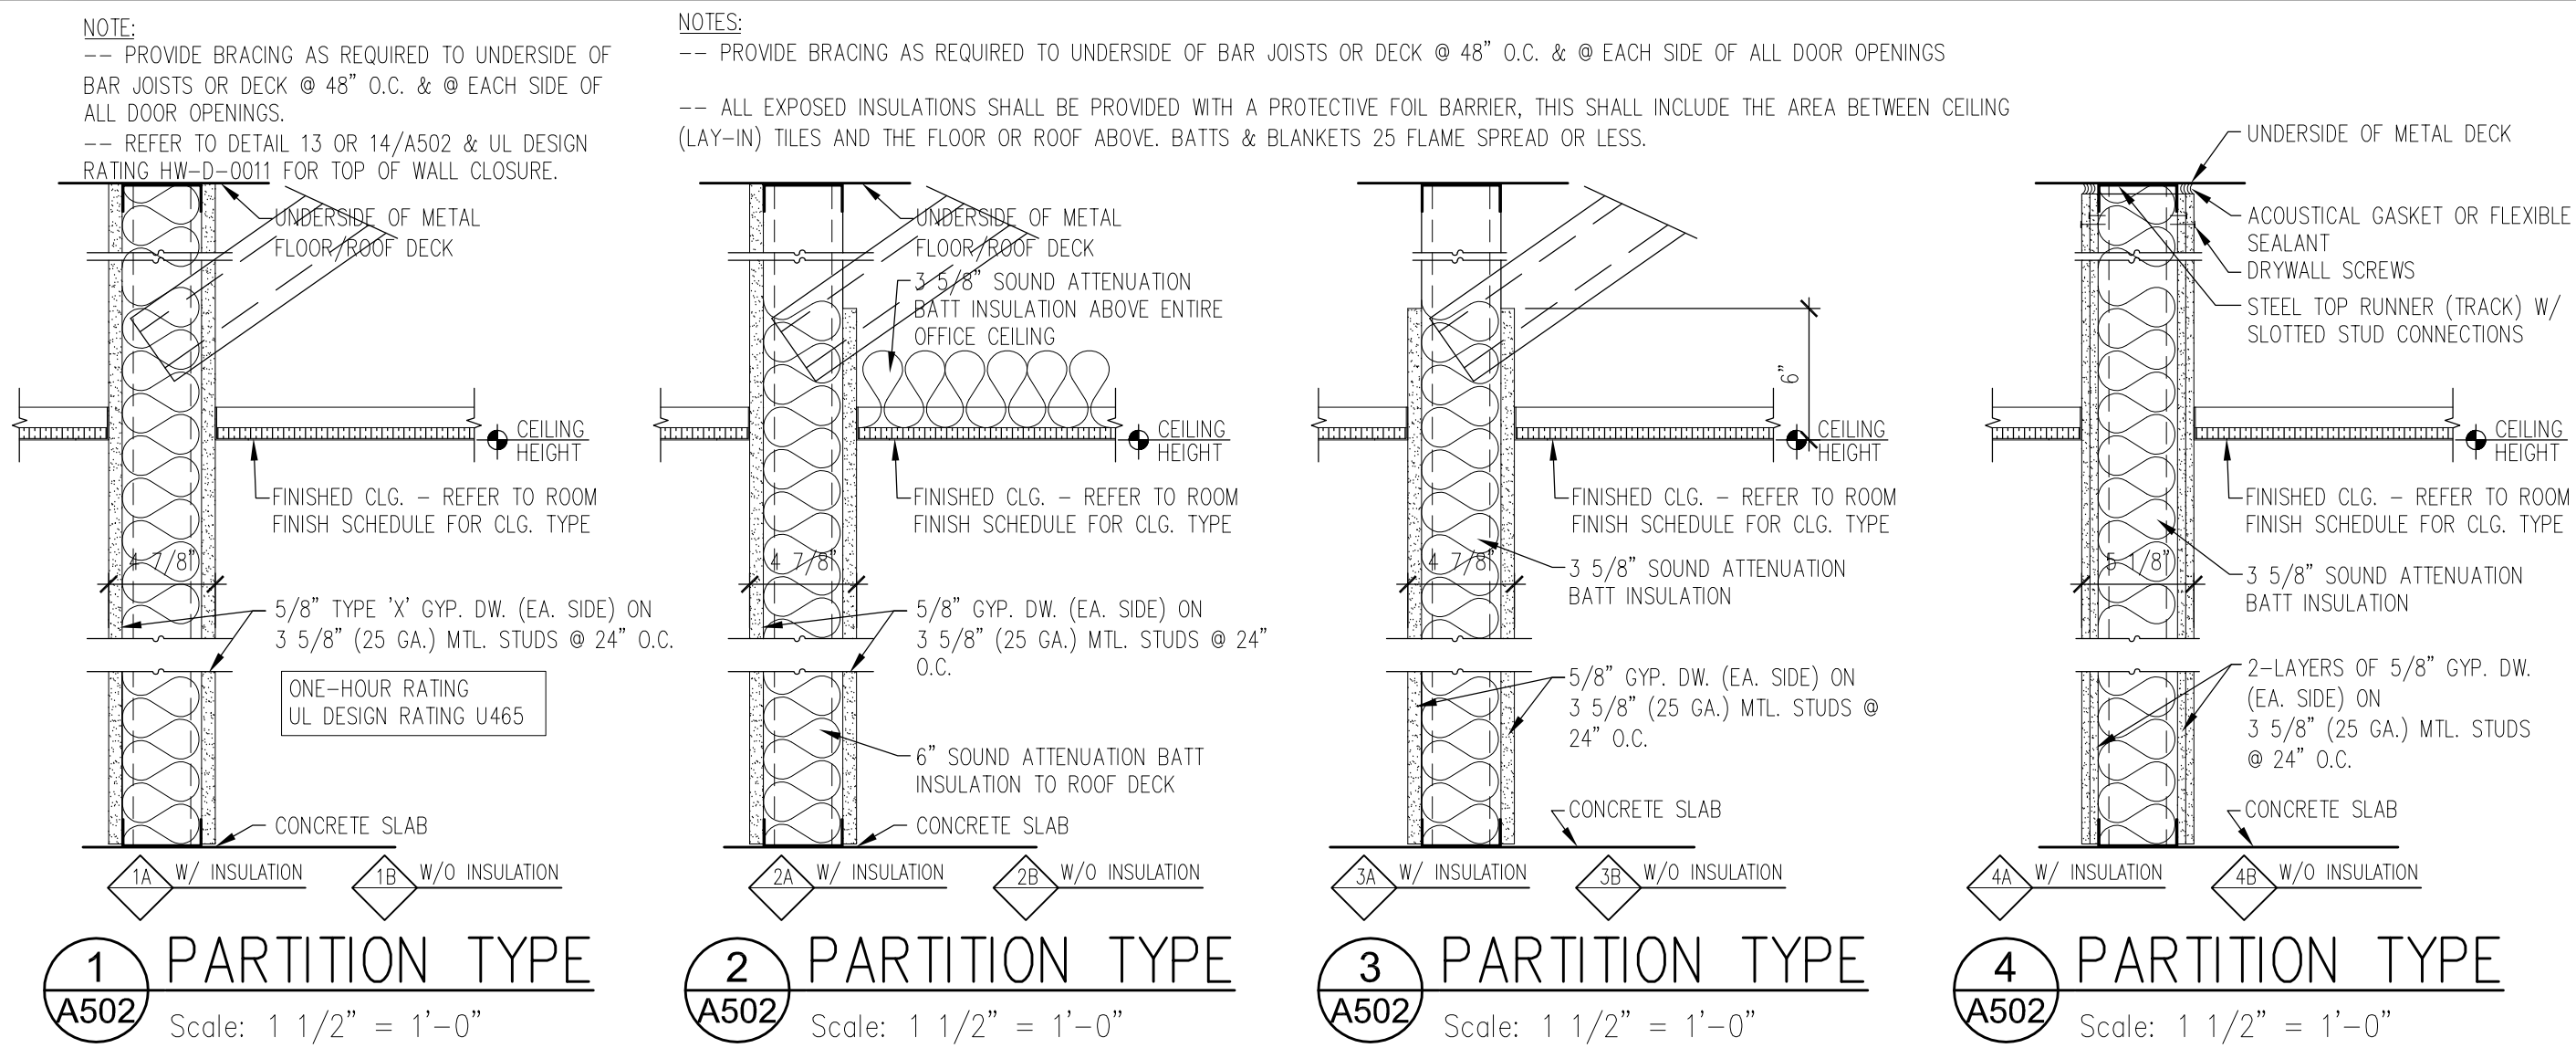

ROOM NUMBER	ROOM NAME	FLOOR	ROOM FINISH		WALLS				CEILING		REMARKS
			MATERIAL	HT.	NORTH NORTHWEST	EAST NORTHEAST	SOUTH SOUTHEAST	WEST SOUTHWEST	MATERIAL	HEIGHT	
100	SPRINKLER ROOM	SEALED CONC.	VINYL	4" COVE	D.W./PAINT	D.W./PAINT	D.W./PAINT	D.W./PAINT	EXPOSED CONST.	----	
101	VESTIBULE	STONE TILE	PED. MAT/ST	4" STRT.	GLASS/WC	WC.	GLASS/WC.	WC	DW./PAINT	10'-0"	
102	VESTIBULE	STONE TILE	PED. MAT/ST	4" STRT.	GLASS/WC	WC.	GLASS/WC.	WC	DW./PAINT	10'-0"	
103	LOBBY	STONE TILE	STONE TILE	4" STRT.	WC.	WC.	WC./WP.	DW./PAINT	DW./PAINT	10'-0"	NOTE: 6
104	ELEVATOR EQUIP.	SEALED CONC.	VINYL	4" COVE	D.W./PAINT	D.W./PAINT	D.W./PAINT	D.W./PAINT	DW./PAINT	10'-0"	
105	JANITOR	SEALED CONC.	VINYL	4" COVE	D.W./PAINT	D.W./PAINT	D.W./PAINT	D.W./PAINT	EXPOSED CONST.	----	NOTE: 4
106	CORRIDOR	STONE TILE	STONE TILE	4" STRT.	WC.	WC.	WC.	WC	ACOUSTIC TILE	10'-0"	NOTE: 6
107	WOMEN	CERAMIC TILE	CER. TILE	4" COVE	WC.	WC.	WC./CER. TILE	WC	ACOUSTIC TILE	10'-0"	
108	MEN	CERAMIC TILE	CER. TILE	4" COVE	WC./CER. TILE	WC.	WC.	WC.	ACOUSTIC TILE	10'-0"	
109	ELEC./TEL.	SEALED CONC.	VINYL	4" COVE	D.W./PAINT	D.W./PAINT	D.W./PAINT	D.W./PAINT	EXPOSED CONST.	----	
110	FUTURE TENANT	CONCRETE	----	----	EXP. CONST.	EXP. CONST.	EXP. CONST.	EXP. CONST.	EXPOSED CONST.	----	NO DRYWALL ON TENANT SIDE OF CORRIDOR WALL
111	FUTURE TENANT	CONCRETE	----	----	EXP. CONST.	EXP. CONST.	EXP. CONST.	EXP. CONST.	EXPOSED CONST.	----	NO DRYWALL ON TENANT SIDE OF CORRIDOR WALL
112	FUTURE TENANT	CONCRETE	----	----	EXP. CONST.	EXP. CONST.	EXP. CONST.	EXP. CONST.	EXPOSED CONST.	----	NO DRYWALL ON TENANT SIDE OF CORRIDOR WALL
210	WOMEN	CERAMIC TILE	CER. TILE	4" COVE	WC.	WC.	WC./CER. TILE	WC	ACOUSTIC TILE	10'-0"	NOTE: 5
202	MEN	CERAMIC TILE	CER. TILE	4" COVE	WC./CER. TILE	WC.	WC.	WC.	ACOUSTIC TILE	10'-0"	NOTE: 5
203	JANITOR	SEALED CONC.	VINYL	4" COVE	D.W./PAINT	D.W./PAINT	D.W./PAINT	D.W./PAINT	EXPOSED CONST.	----	NOTE: 4
204	FUTURE TENANT	CONCRETE	----	----	EXP. CONST.	EXP. CONST.	EXP. CONST.	EXP. CONST.	EXPOSED CONST.	----	
ST-1	STAIR #1	CARPET	VINYL	4" COVE	D.W./PAINT	D.W./PAINT	D.W./PAINT	D.W./PAINT	ACOUSTIC TILE	10'-0"	PAINT ALL EXPOSED STEEL STRINGERS, RISERS, KICKPLATES, STAIR UNDERSIDES, HANDRAIL/GUARDRAILS.
ST-2	STAIR #2	SEALED CONC.	VINYL	4" COVE	CONC./PAINT	D.W./PAINT	CONC./PAINT	CONC./PAINT	ACOUSTIC TILE	10'-0"	
EL-1	ELEVATOR	CARPET									

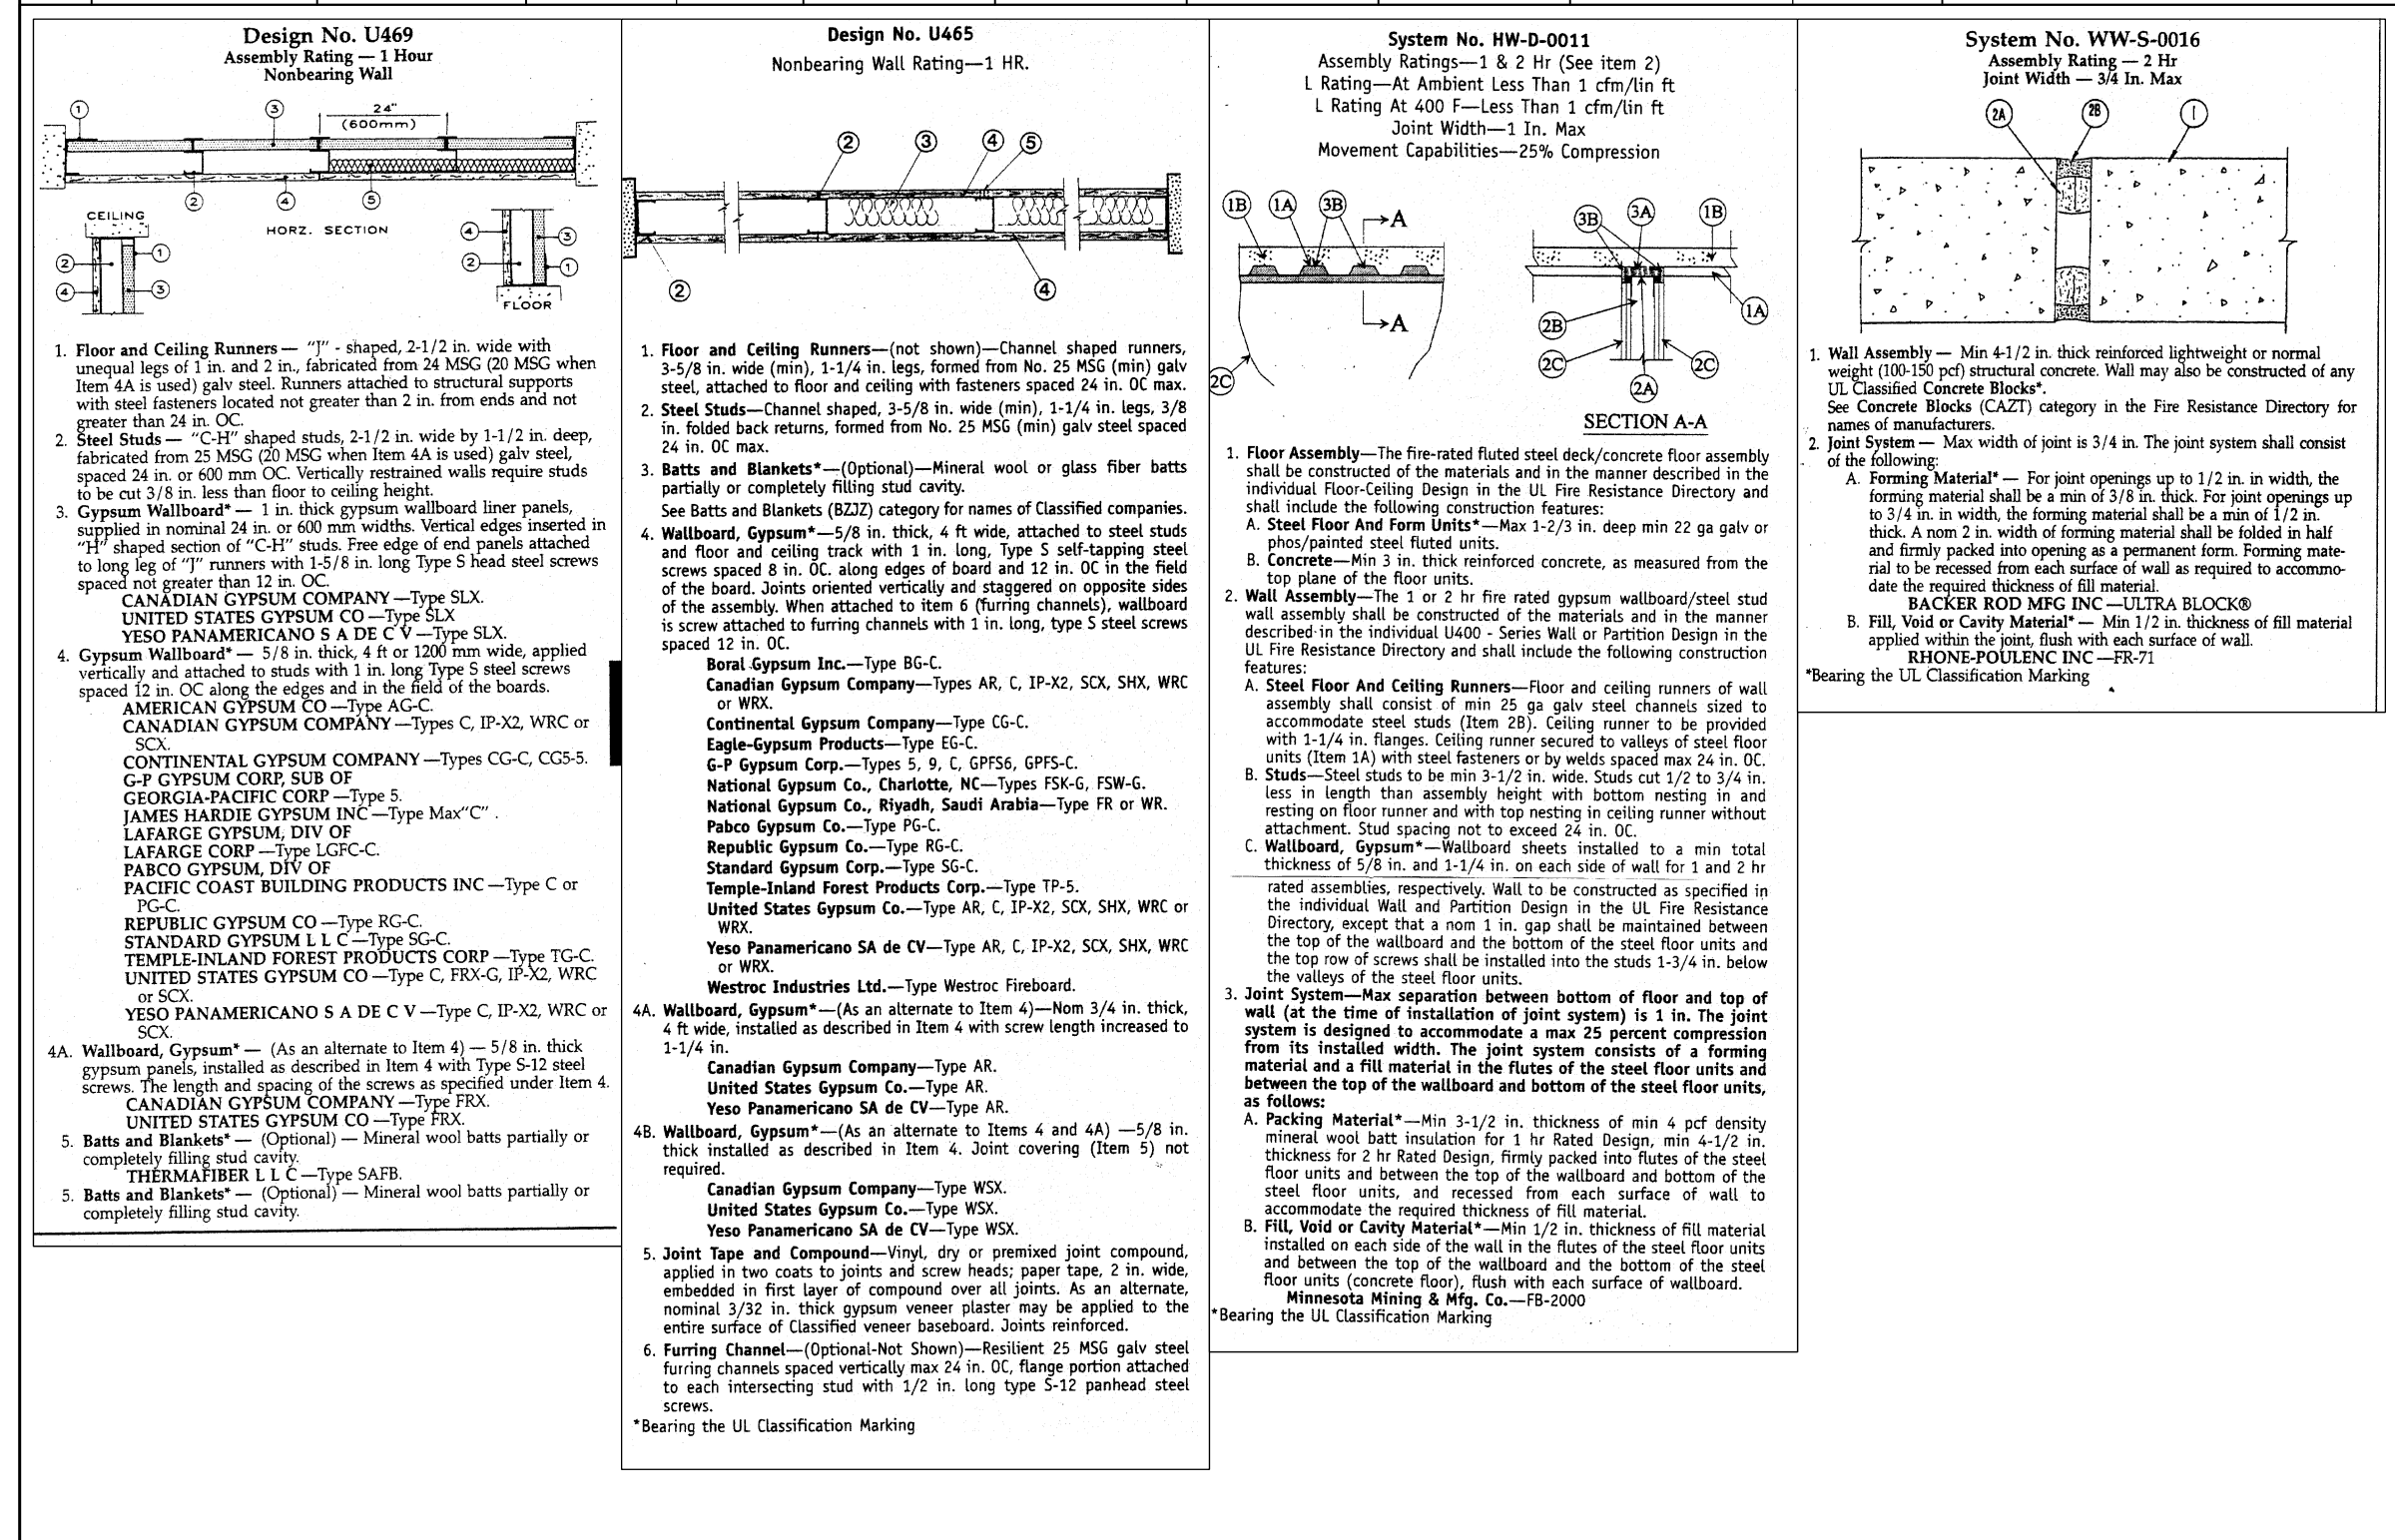

ABBREVIATIONS:
 CONC. = CONCRETE (PRECAST) WALL PANEL
 DW. = DRYWALL
 T&S = TAPED & SANDED ONLY
 PT. = PAINT
 WC. = WALL COVERING
 WP. = WOOD PANELING
 CT. = CERAMIC TILE
 ST. = STONE TILE
 VCT = VINYL COMPOSITE TILE
 FRP = FIBERGLASS REINFORCED PANEL
 EXP. CONST. = EXPOSED CONSTRUCTION

FLAME SPREAD OF ALL INTERIOR FINISHES SHALL BE:
 STAIRS/ELEVATOR: 0 TO 25 (CLASS I)
 CORRIDORS: 26 TO 75 (CLASS II)
 OTHER SPACES: 76 TO 200 (CLASS III)

ROOM FINISH NOTES:
 1. FLOOR SURFACES ALONG ACCESSIBLE ROUTES AND IN ACCESSIBLE ROOMS AND SPACES INCLUDING FLOORS, RAMPS, STAIRS AND CURB RAMPS SHALL BE STABLE, FIRM AND SLIP RESISTANT.
 2. TRANSITIONAL HEIGHTS BETWEEN CARPET AND TILE ALONG ACCESSIBLE ROUTES MAYBE 1/4 IN. VERTICAL AND WITHOUT EDGE TREATMENT. CHANGES IN LEVEL BETWEEN 1/4 IN. AND 1/2 IN. SHALL BE BEVELED WITH A SLOPE NO GREATER THAN 1:2.
 3. ALL EXPOSED INSULATION SHALL BE PROVIDED WITH A PROTECTIVE FOIL FACE BARRIER, HAVING A FLAME SPREAD RATING OF 25 (CLASS A) WHICH SHALL LIMIT THE AVERAGE TEMPERATURE RISE OF THE UNEXPOSED SURFACE TO NOT MORE THAN 250 °F AFTER 15 MINUTES OF FIRE EXPOSURE.
 4. WITH-IN JANITOR CLOSETS PROVIDE A 4'-0" HIGH F.R.P. WAINSCOT @ ALL WALLS.
 5. BELOW THE CERAMIC TILE FLOOR FINISH ON SUSPENDED SLABS, PROVIDE A WATERPROOF MEMBRANE SYSTEM, "LATICRETE 9235" OR EQUAL; A LIQUID-LATEX RUBBER WITH FABRIC REINFORCEMENT.
 6. BELOW THE STONE TILE, PROVIDE A CRACK ISOLATION MEMBRANE ALONG THE CONCRETE CONTROL JOINTS.

Duke
 CONSTRUCTION
 4225 Naperville Road
 Suite 150
 Lisle, IL 60532
 Phone: (630) 577-7900
 Fax: (630) 577-7979



TMA
 Architects - Planners
 Timothy Morgan Associates
 200 Tri-State International Center
 Suite 100
 Lincolnshire, Illinois 60069
 847 374-0058 phone
 847 374-0057 fax

Revisions:
 5/10/05 Initial Building Permit Submittal
 6/29/05 Building Permit Resubmittal
 8/23/05 Shell Construction Set
 10/14/05 Rev's-Owner Finish Rev. Mtg
 03/12/06 — Record Set

Scale: 1/8"=1'-0"
 Date: 03/12/06
 Drawn By: SBT
 Checked By:

PARAGON GLOBAL RESOURCES
 CANTERA CORPORATE CENTER - LOT 1
 27501 BELLA VISTA PARKWAY
 WARRENVILLE, ILLINOIS

Certified By:
 Drawing Number:
 A502
 Of Sheets
 Duke Realty Job Number:
 PARAGN-001
 A/E Job Number:
 04-094

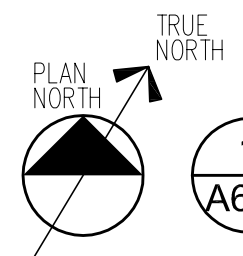
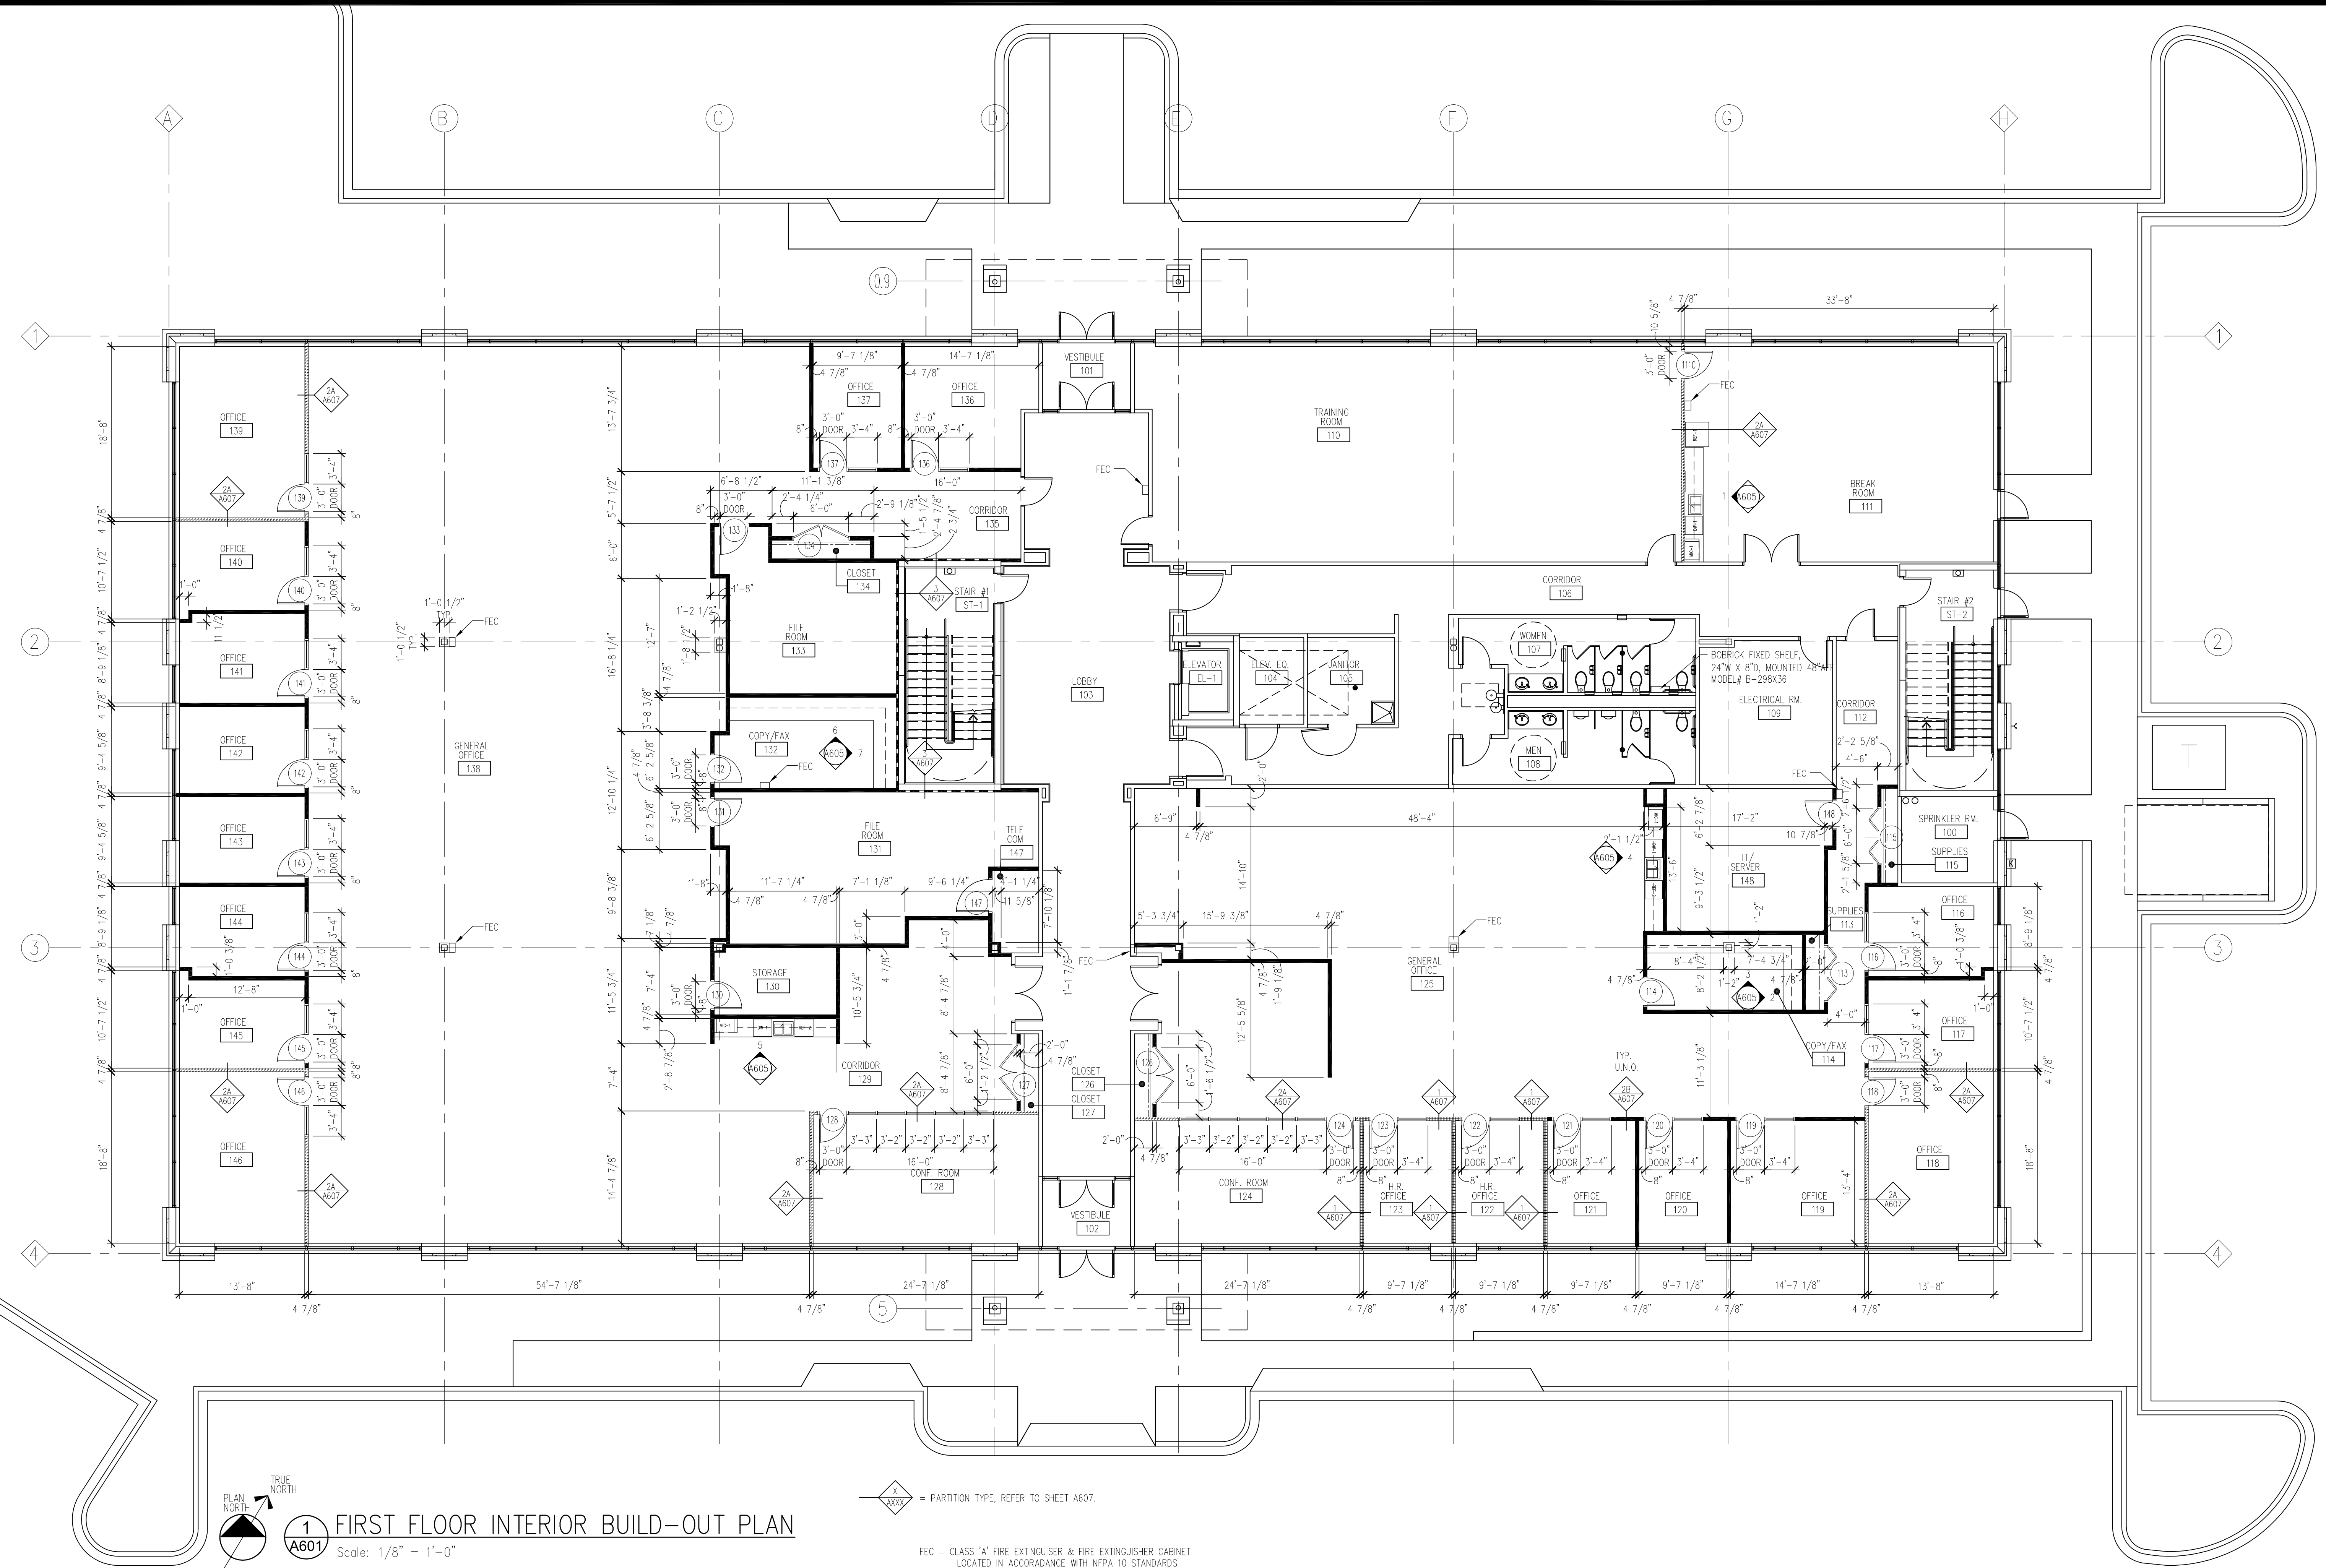


1 FIRST FLOOR INTERIOR BUILD-OUT PLAN
Scale: 1/8" = 1'-0"

= PARTITION TYPE, REFER TO SHEET A607.

FEC = CLASS 'A' FIRE EXTINGUISHER & FIRE EXTINGUISHER CABINET
LOCATED IN ACCORDANCE WITH NFPA 10 STANDARDS

G.C. TO PROVIDE NON-COMBUSTIBLE OR F.R.T. WOOD IN-WALL
BLOCKING @ ALL WALLS WHERE FLAT SCREEN MONITORS ARE TO BE
MOUNTED. OWNER TO SPECIFY FLAT SCREEN MONITOR SIZE &
LOCATIONS PRIOR TO BLOCKING INSTALLATION.

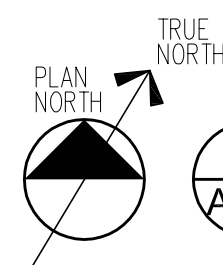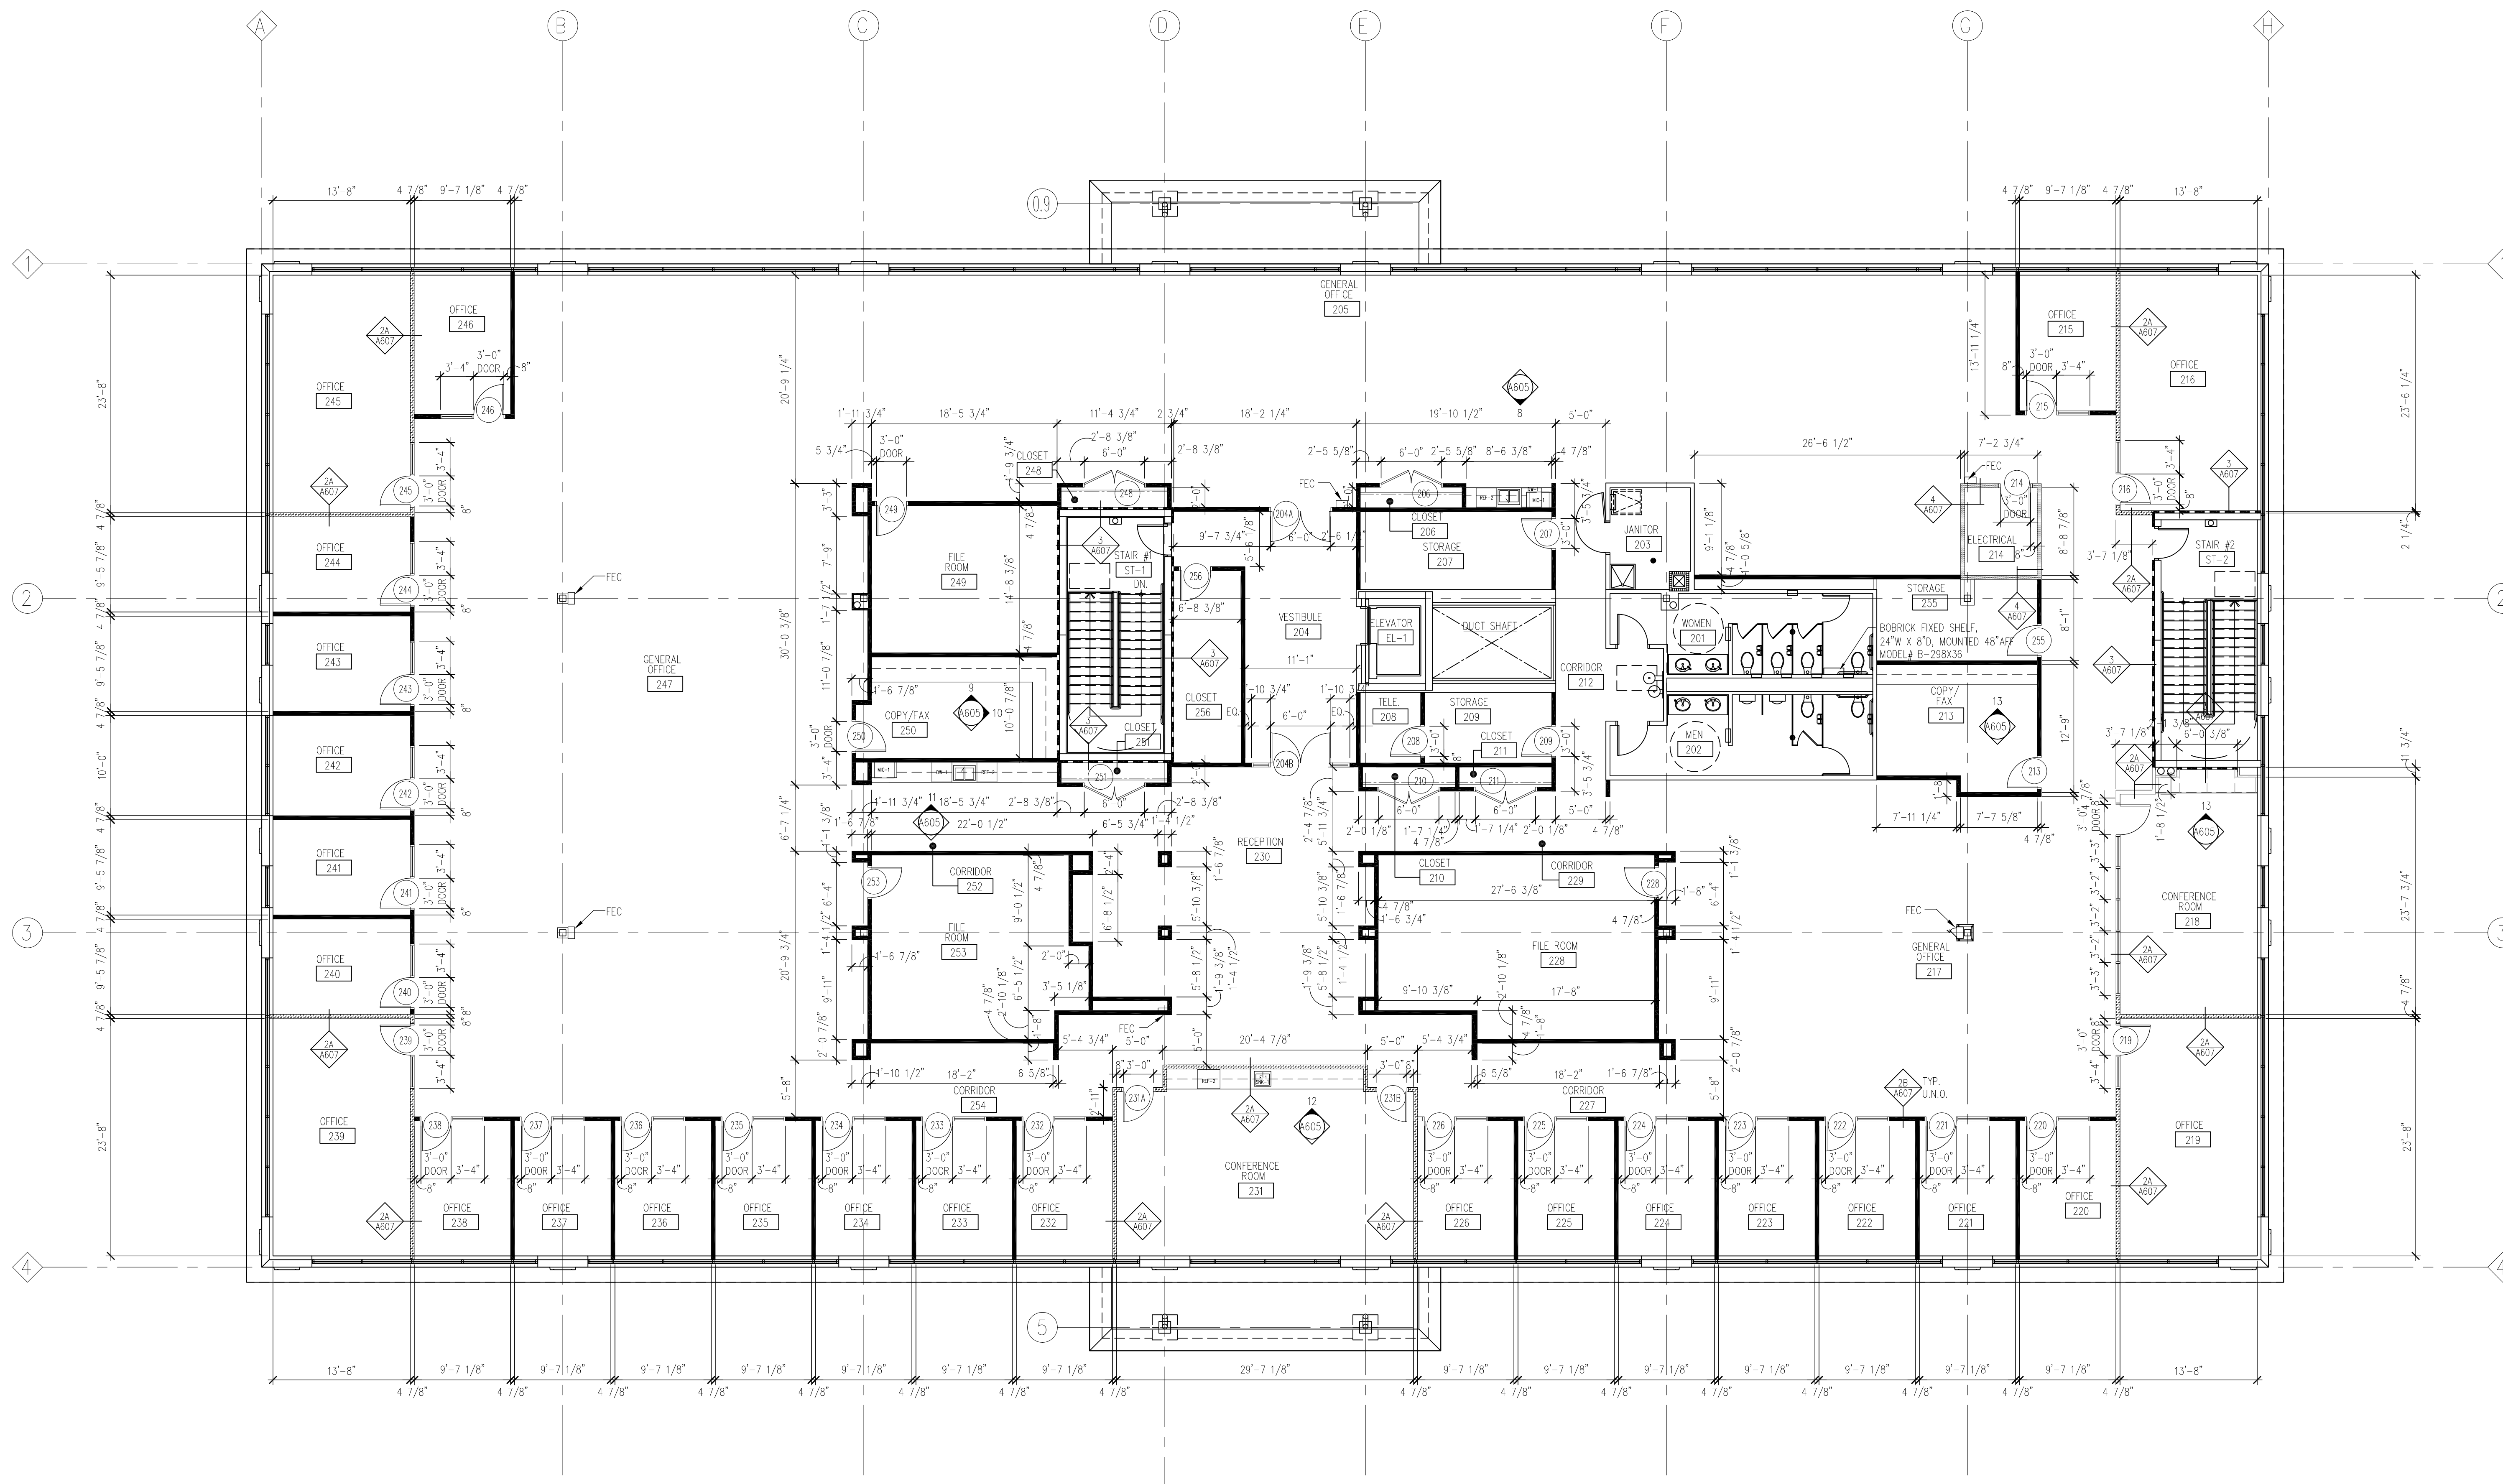



1 SECOND FLOOR INTERIOR BUILD-OUT PLAN
Scale: 1/8" = 1'-0"

X
XXXX = PARTITION TYPE, REFER TO SHEET A607.

FEC = CLASS 'A' FIRE EXTINGUISHER & FIRE EXTINGUISHER CABINET
LOCATED IN ACCORDANCE WITH NFPA 10 STANDARDS


G.C. TO PROVIDE NON-COMBUSTIBLE OR F.R.T. WOOD IN-WALL
BLOCKING @ ALL WALLS WHERE FLAT SCREEN MONITORS ARE TO BE
MOUNTED. OWNER TO SPECIFY FLAT SCREEN MONITOR SIZE &
LOCATIONS PRIOR TO BLOCKING INSTALLATION.

Scale: $1/8" = 1'-0"$

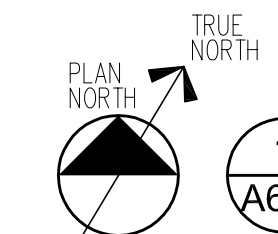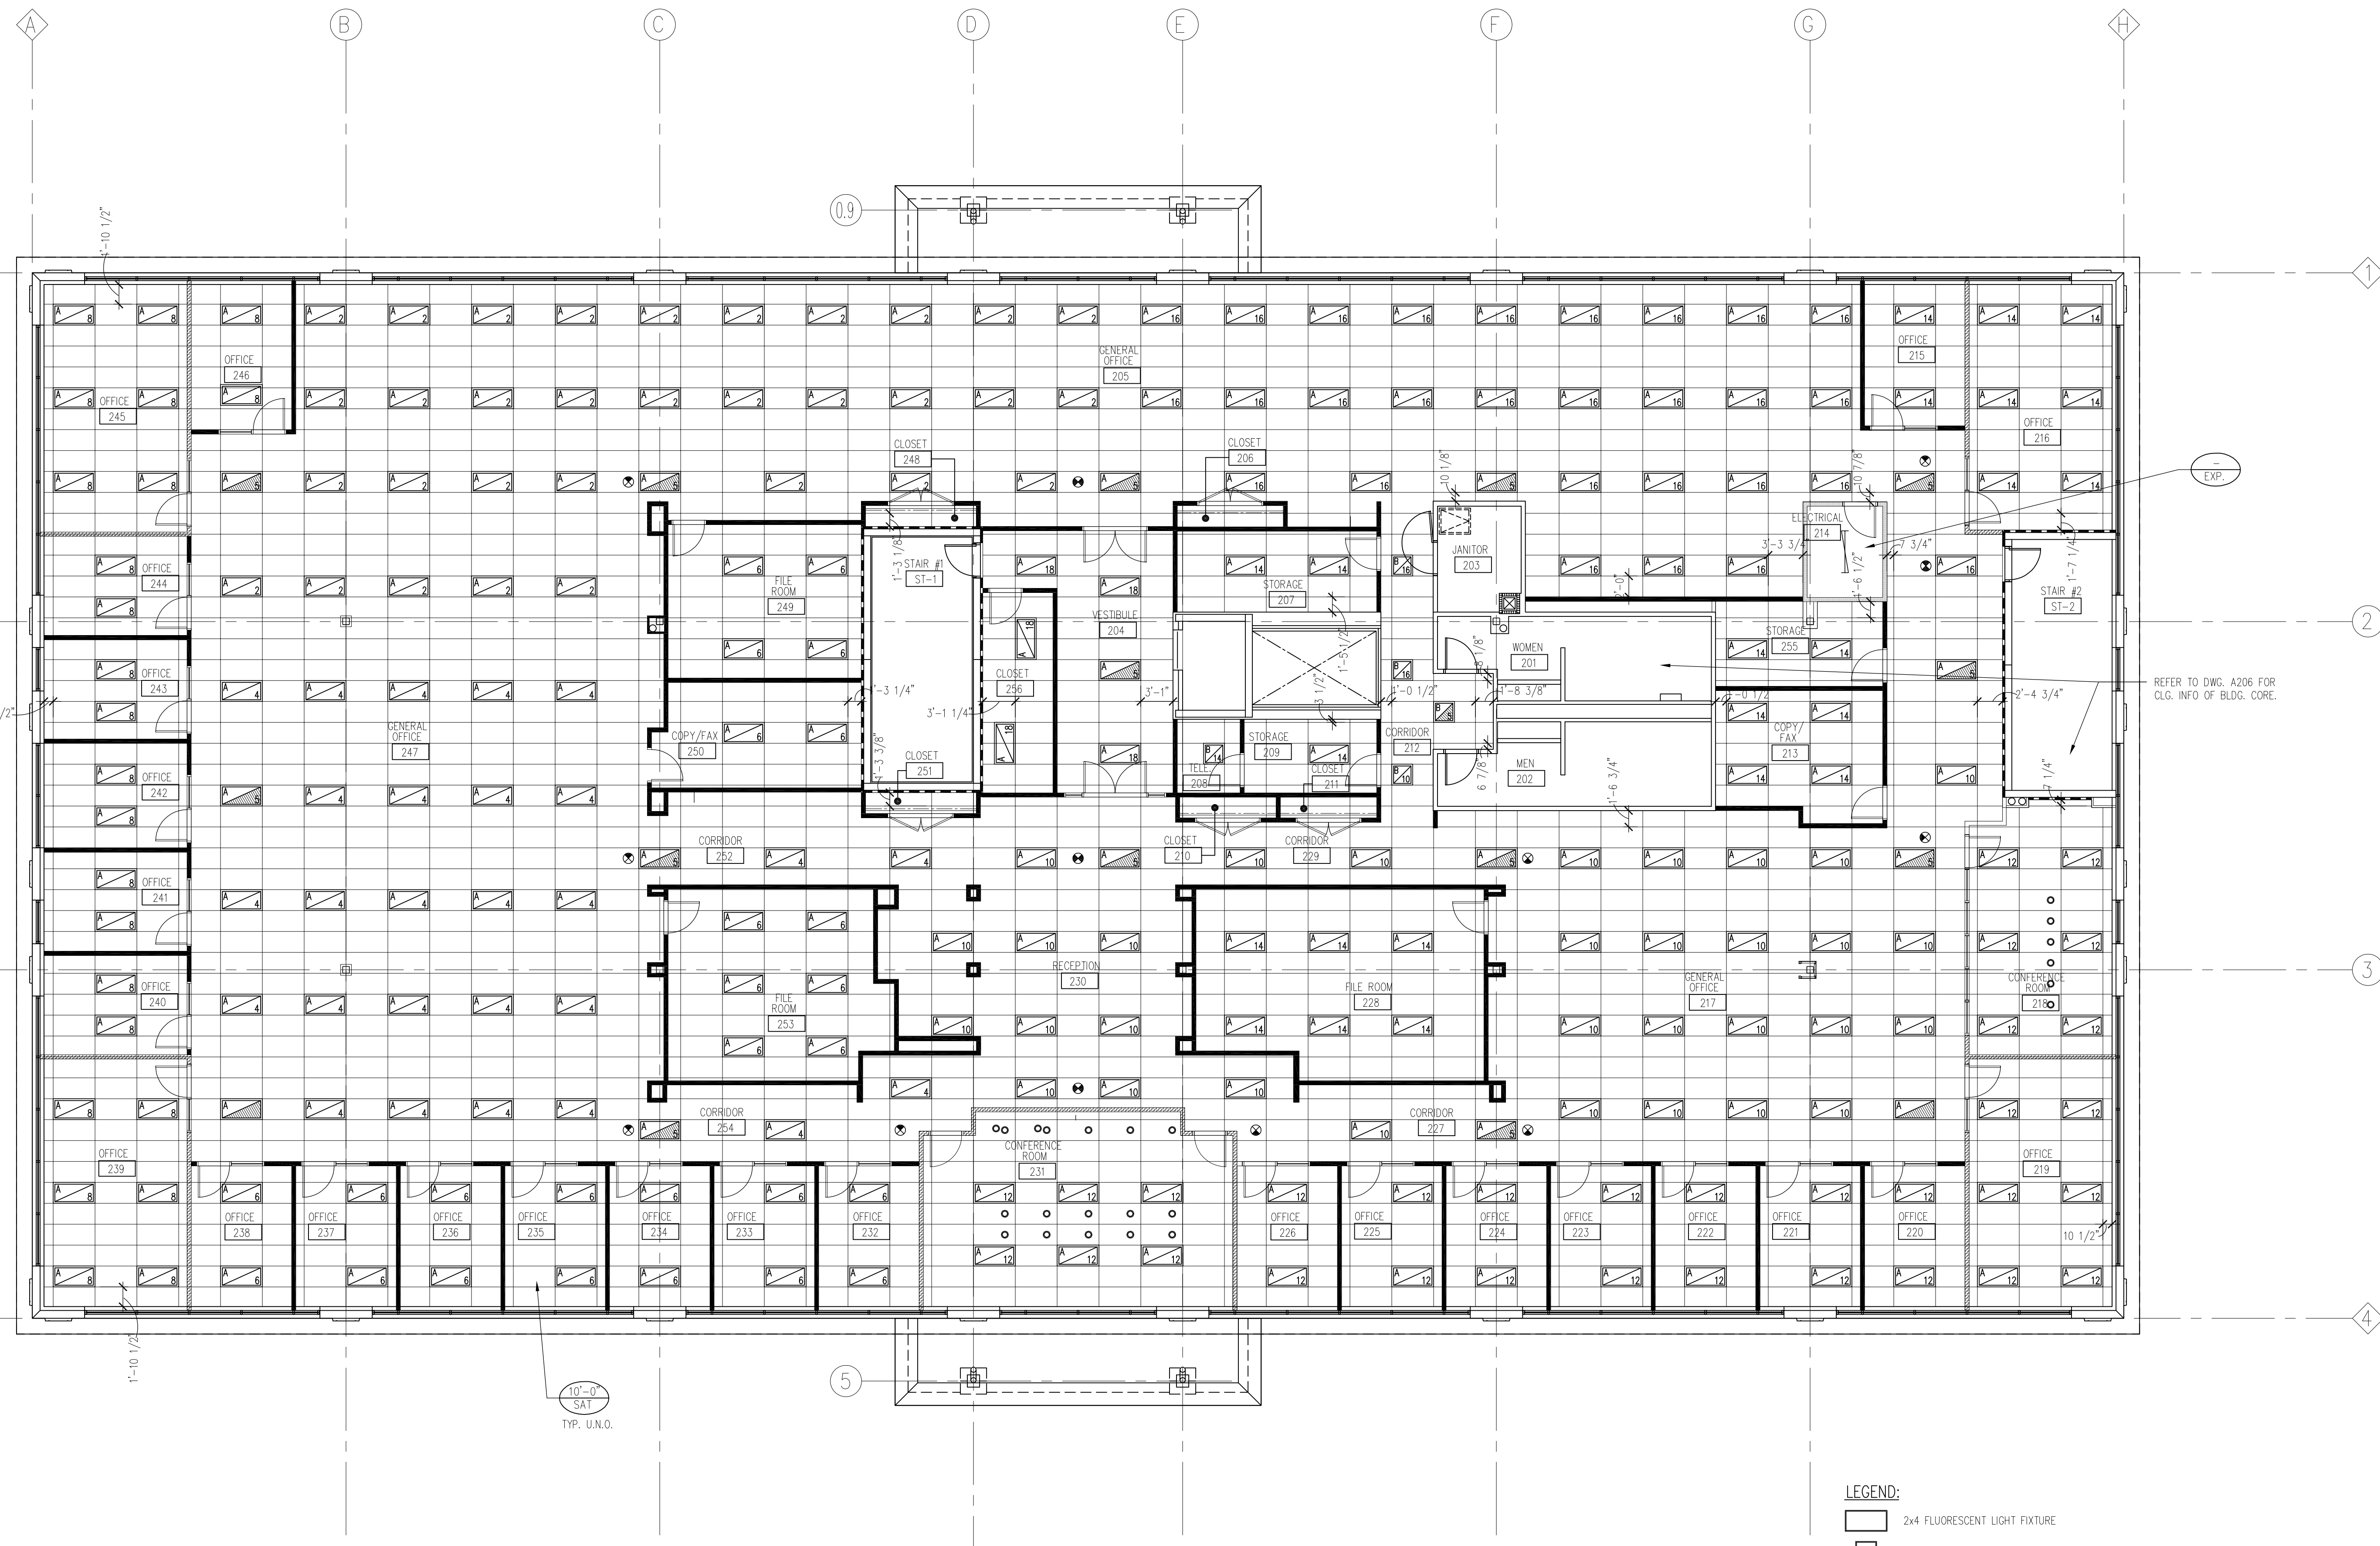


1 SECOND FLOOR INTERIOR BUILD-OUT REFLECTED CEILING PLAN
A604
Scale: 1/8" = 1'-0"


- LEGEND:**
- 2x4 FLUORESCENT LIGHT FIXTURE
 - 2x2 FLUORESCENT LIGHT FIXTURE
 - FLUORESCENT DOWNLIGHT FIXTURE
 - CEILING HT.
 - CEILING MTL. (SUSPENDED ACOUSTICAL TILE)

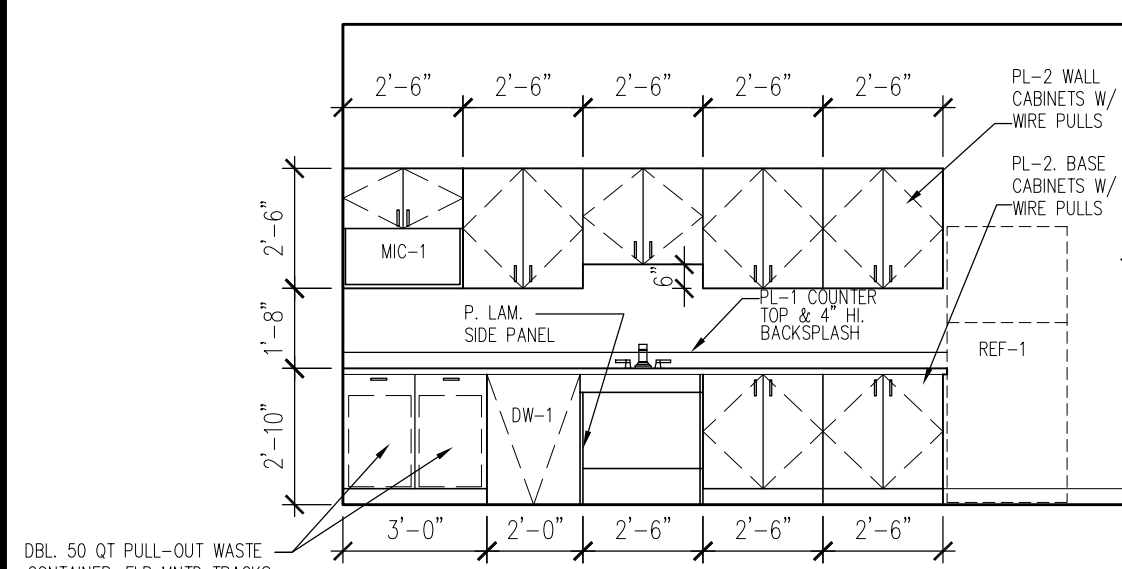


① BREAK ROOM #111 PANTRY
Scale: 1/4" = 1'-0"

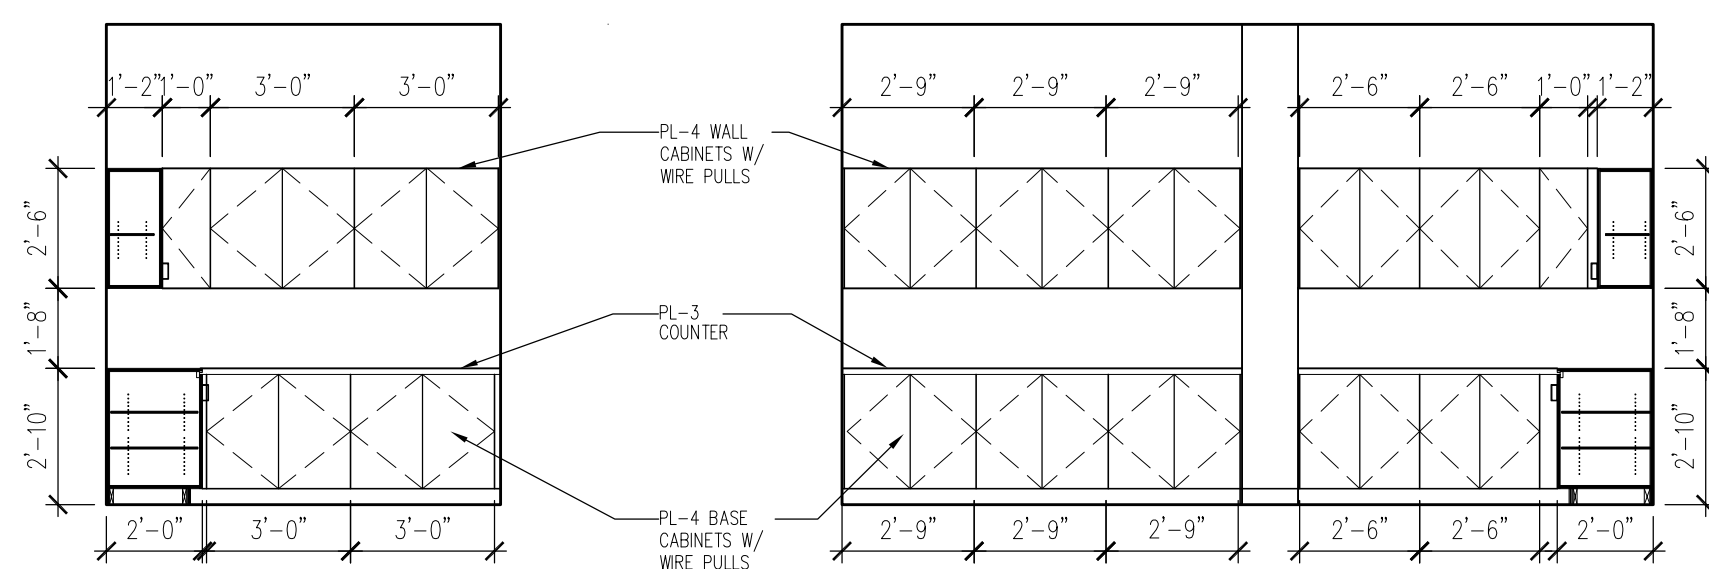

② COPY/FAX #114 WORK AREA
Scale: 1/4" = 1'-0"

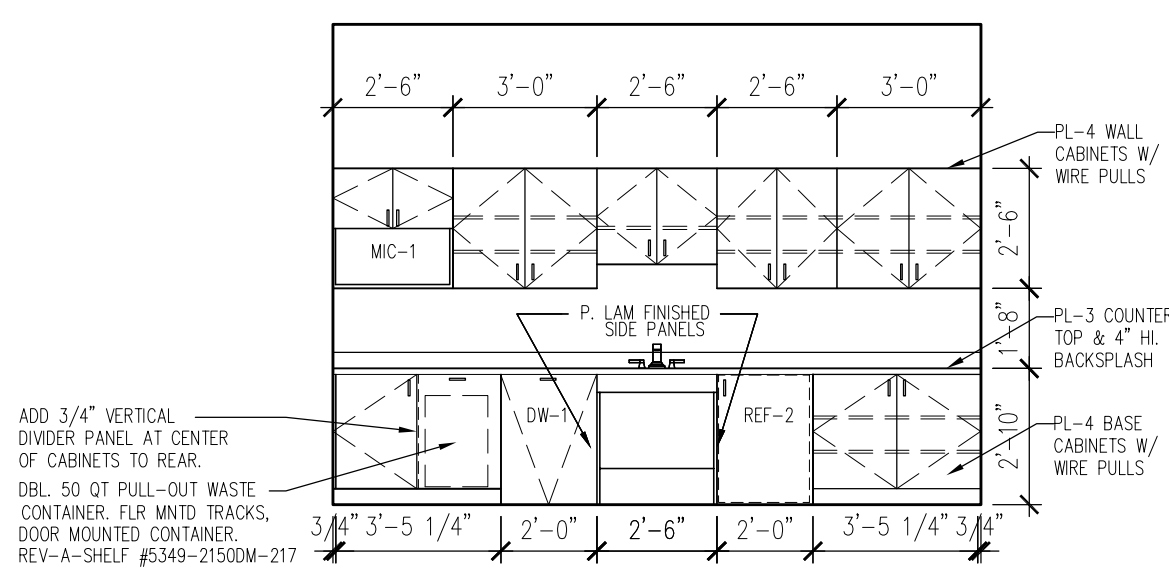


④ GENL. OFFICE #125 PANTRY
Scale: 1/4" = 1'-0"

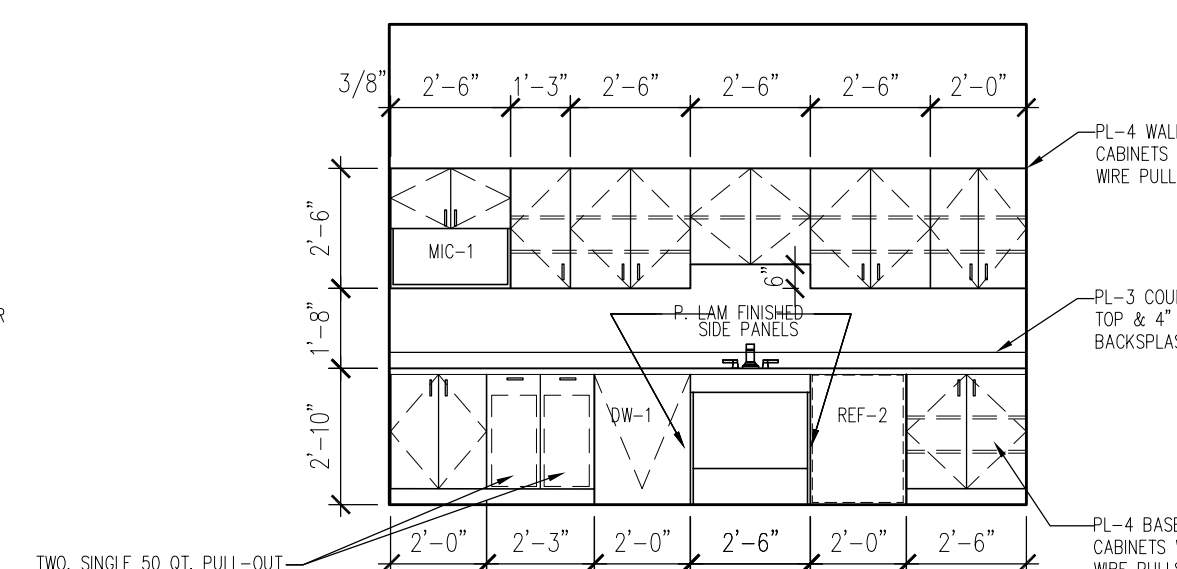


⑤ CORRIDOR #129 PANTRY
Scale: 1/4" = 1'-0"


- NOTES:
1. PROVIDE AND INSTALL WITH-IN WALLS F.R.T. WOOD BLOCKING, AS REQUIRED FOR INSTALLATION OF CABINETRY.
 2. INSULATE TRAP AND HOT WATER PIPES AT ALL SINKS.
 3. SINK FAUCETS SHALL BE LEVER OPERATED.
 4. SINK WATER TEMPERATURE SHALL NOT EXCEED 110 DEGREES F.

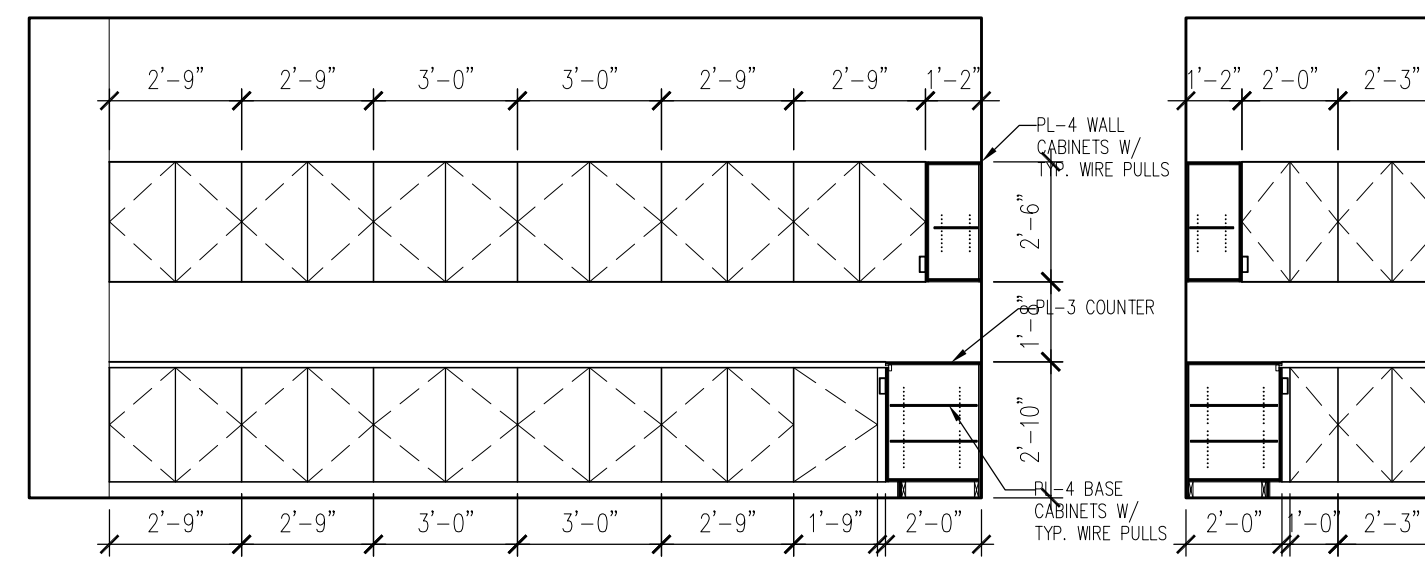


⑥ COPY/FAX #132 WORK AREA
Scale: 1/4" = 1'-0"

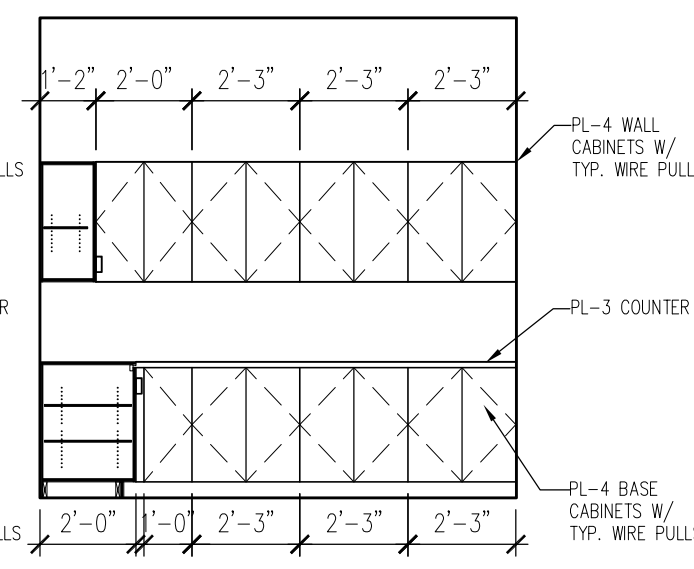


⑦
Scale: 1/4" = 1'-0"

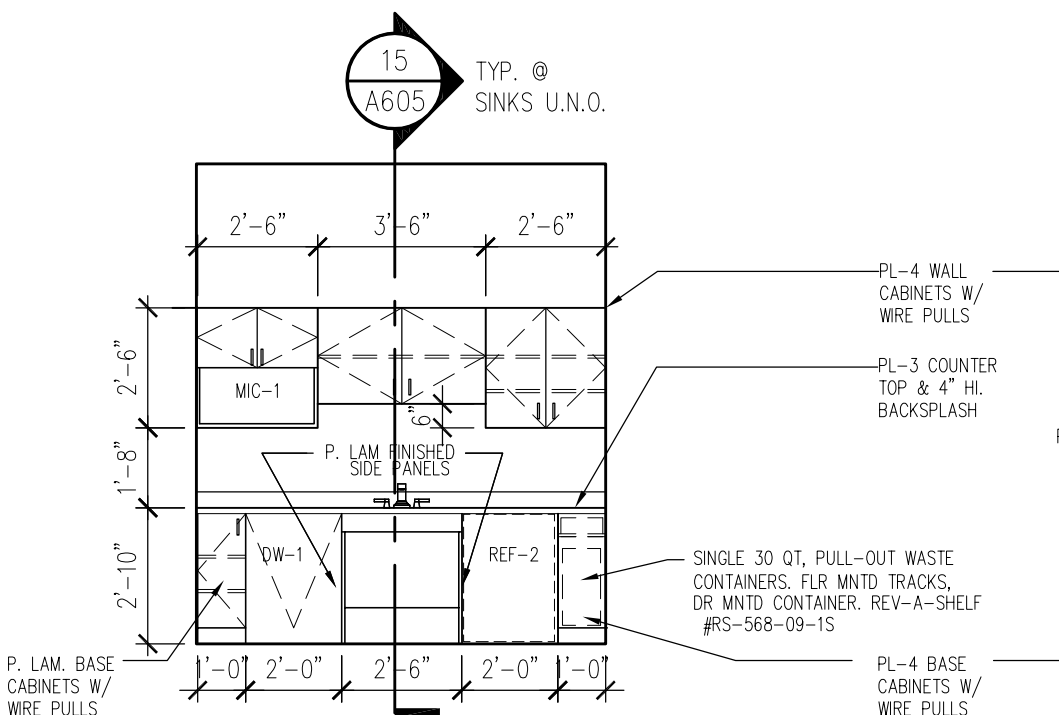


⑧ GENL. OFFICE #205 PANTRY
Scale: 1/4" = 1'-0"

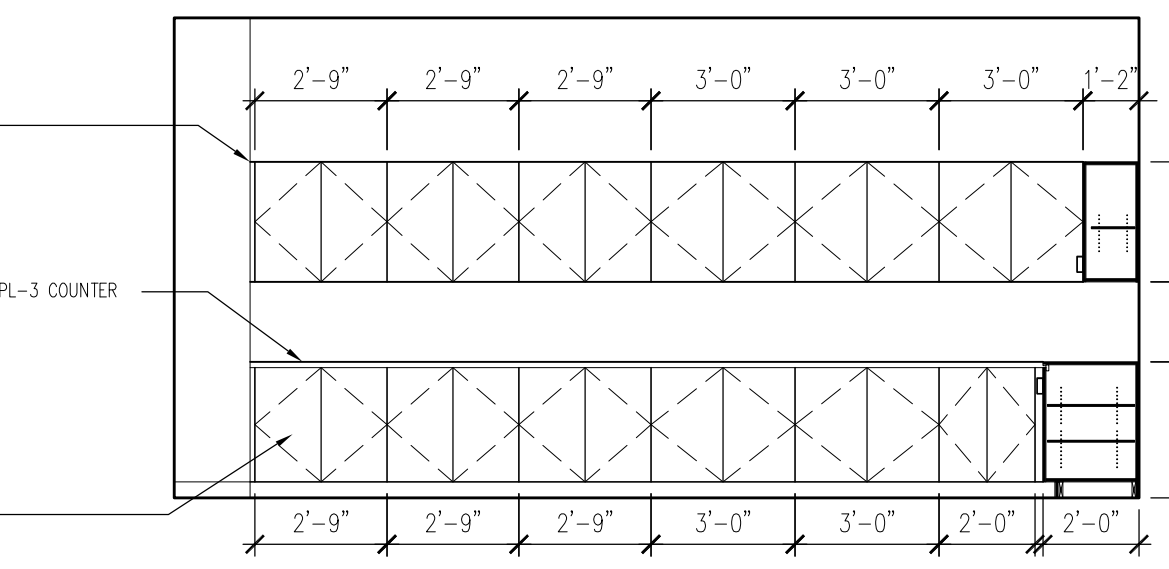


⑨ COPY/FAX #250 WORK AREA
Scale: 1/4" = 1'-0"

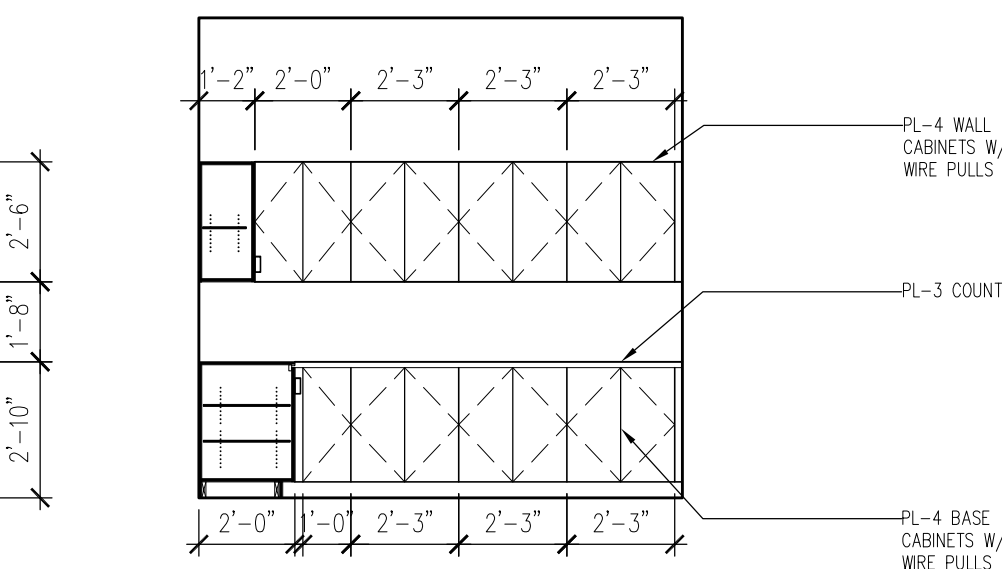


⑩
Scale: 1/4" = 1'-0"

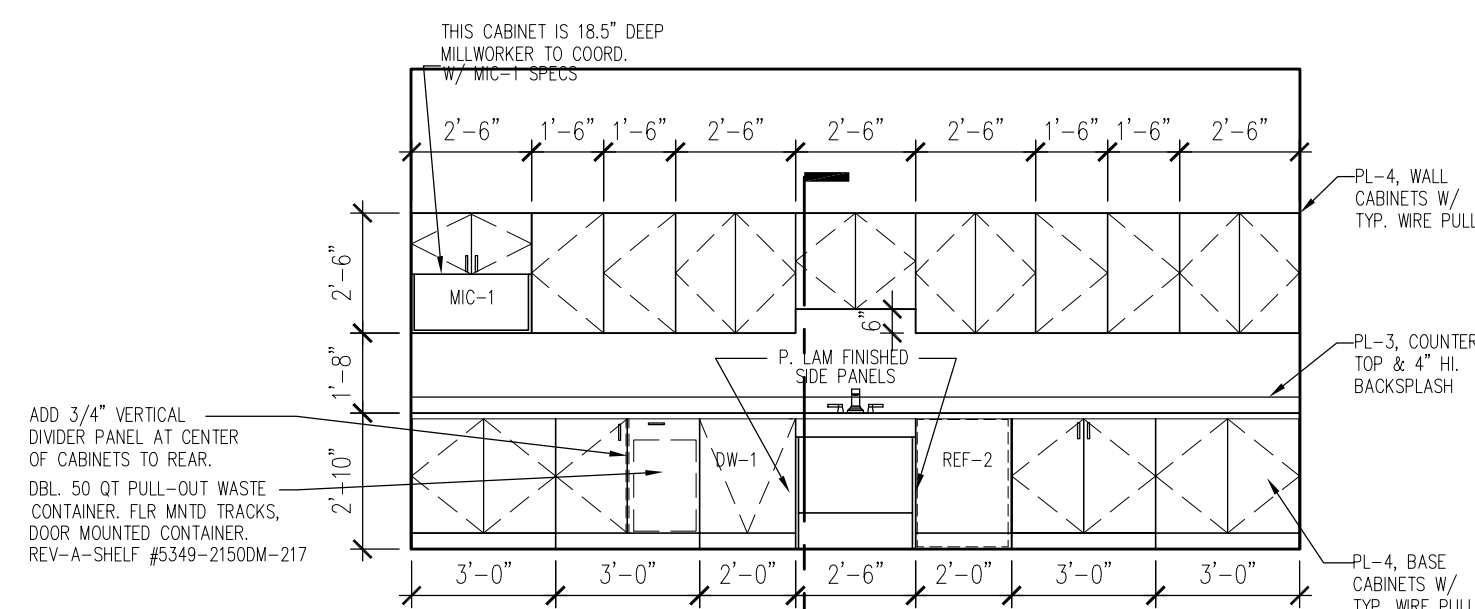


⑪ CORRIDOR #252 PANTRY
Scale: 1/4" = 1'-0"

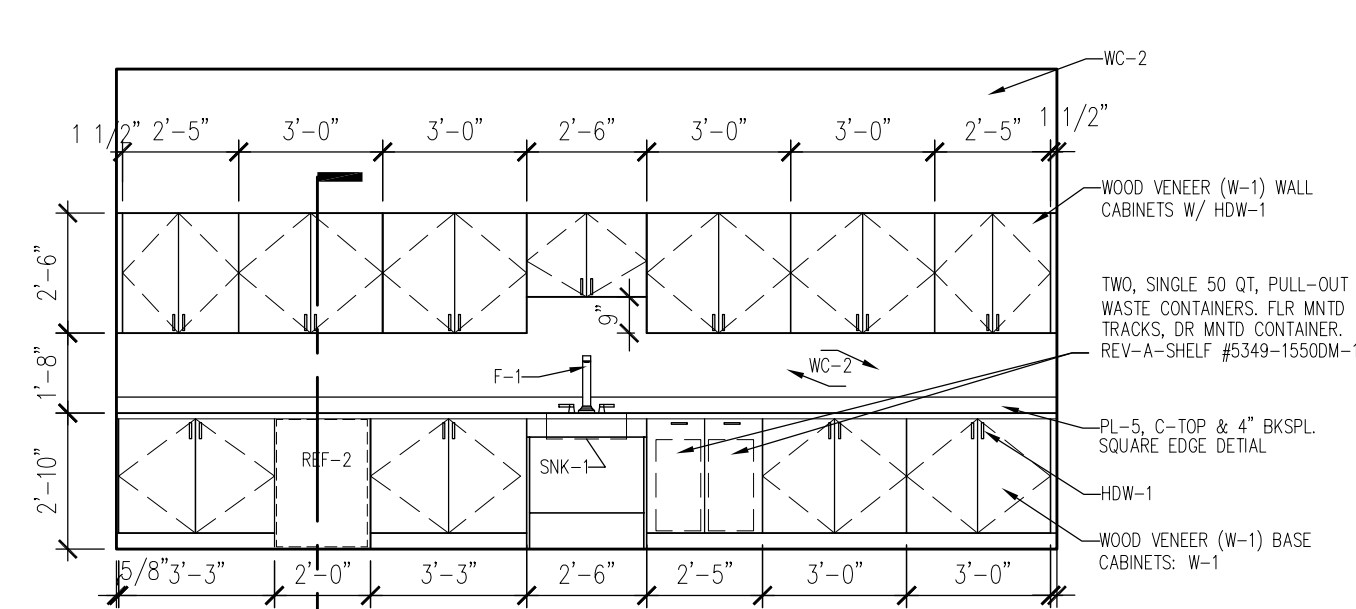


⑫ CONF. RM. #231
Scale: 1/4" = 1'-0"

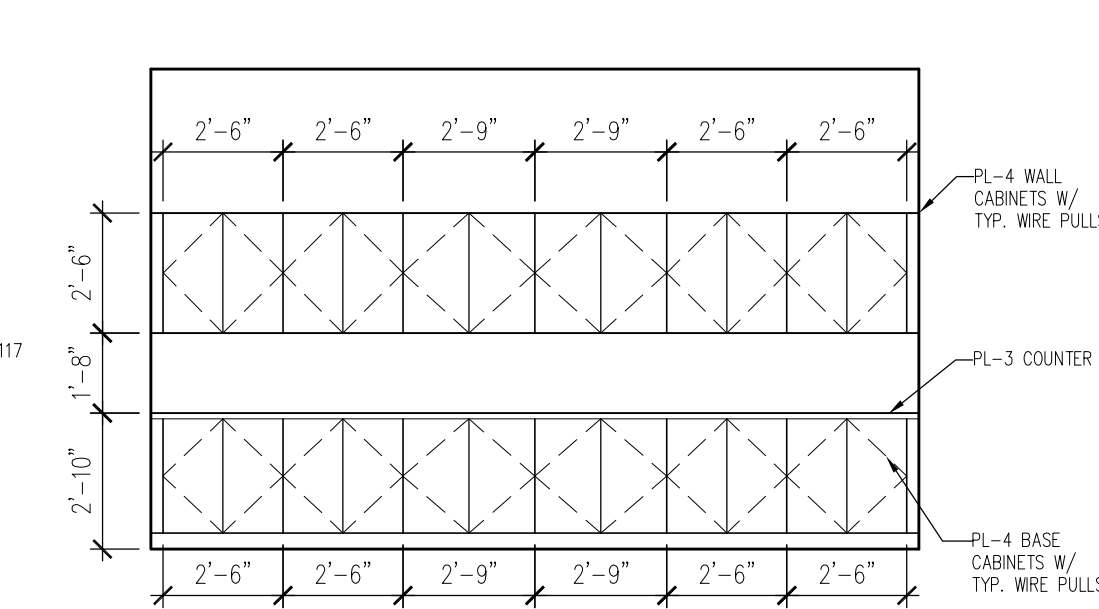


⑬ COPY/FAX #213
Scale: 1/4" = 1'-0"

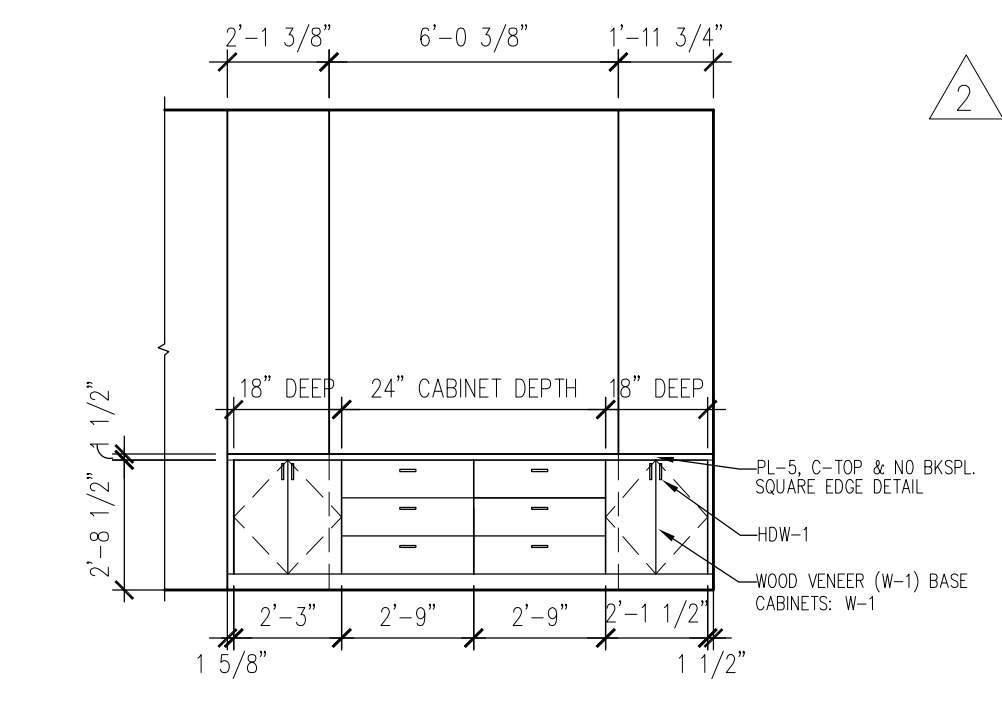


⑬ CONFERENCE #218
Scale: 1/4" = 1'-0"

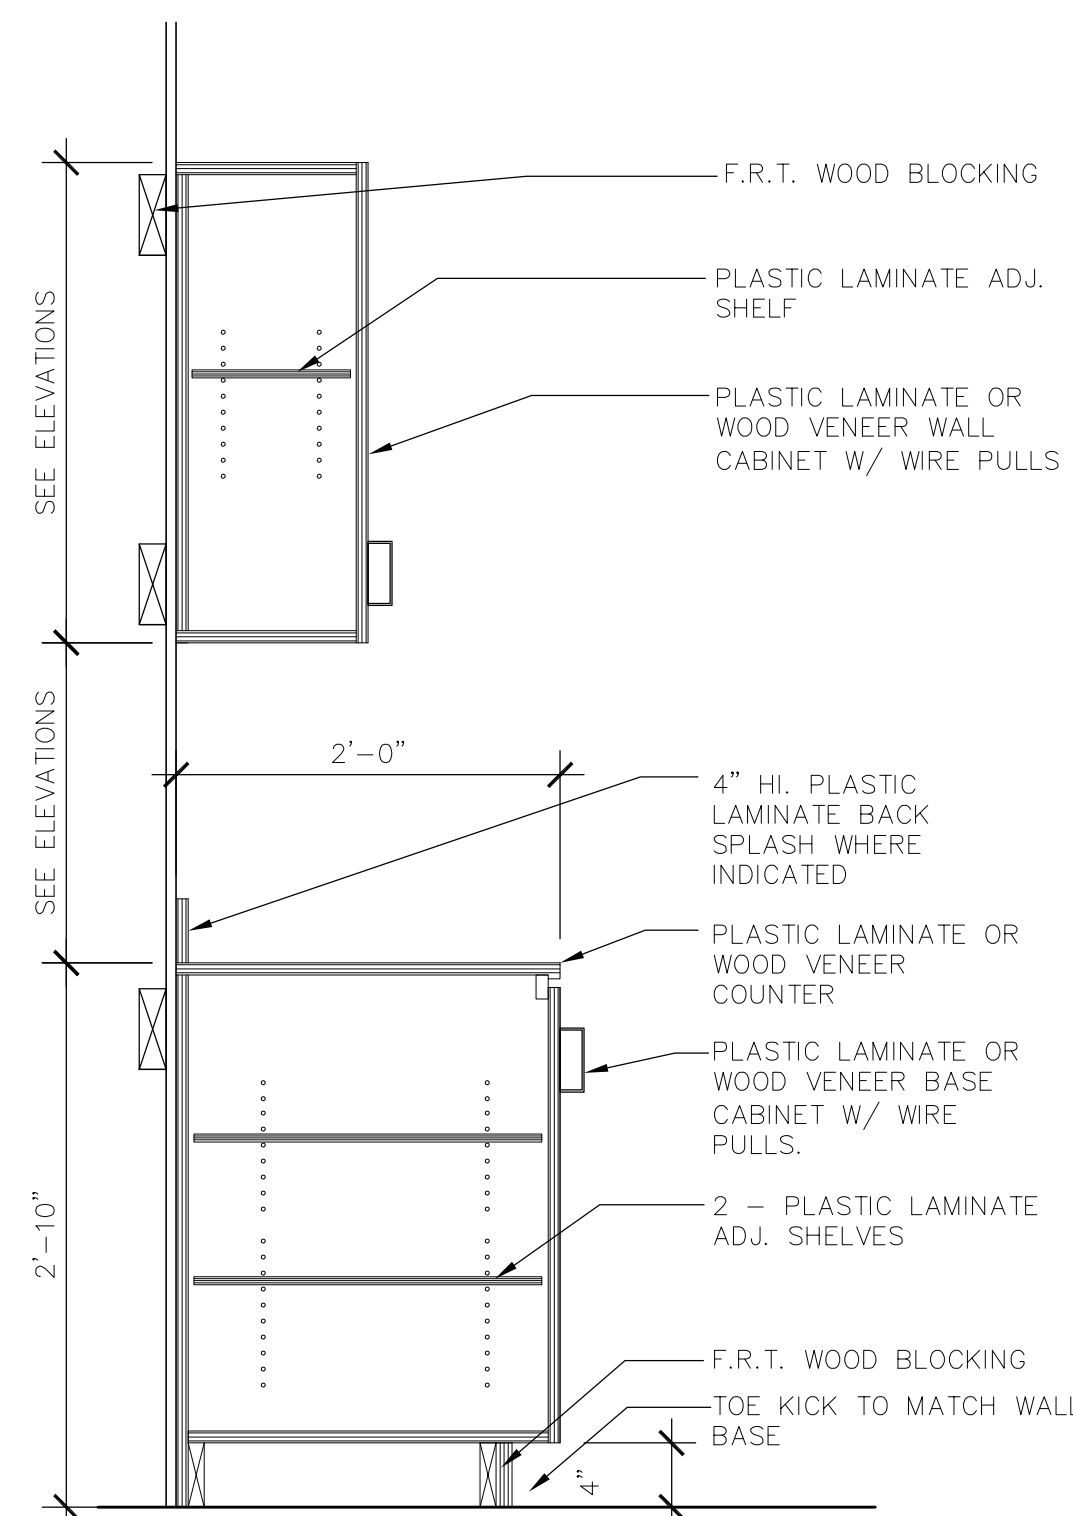

⑭ CABINET SECTION
Scale: 1" = 1'-0"

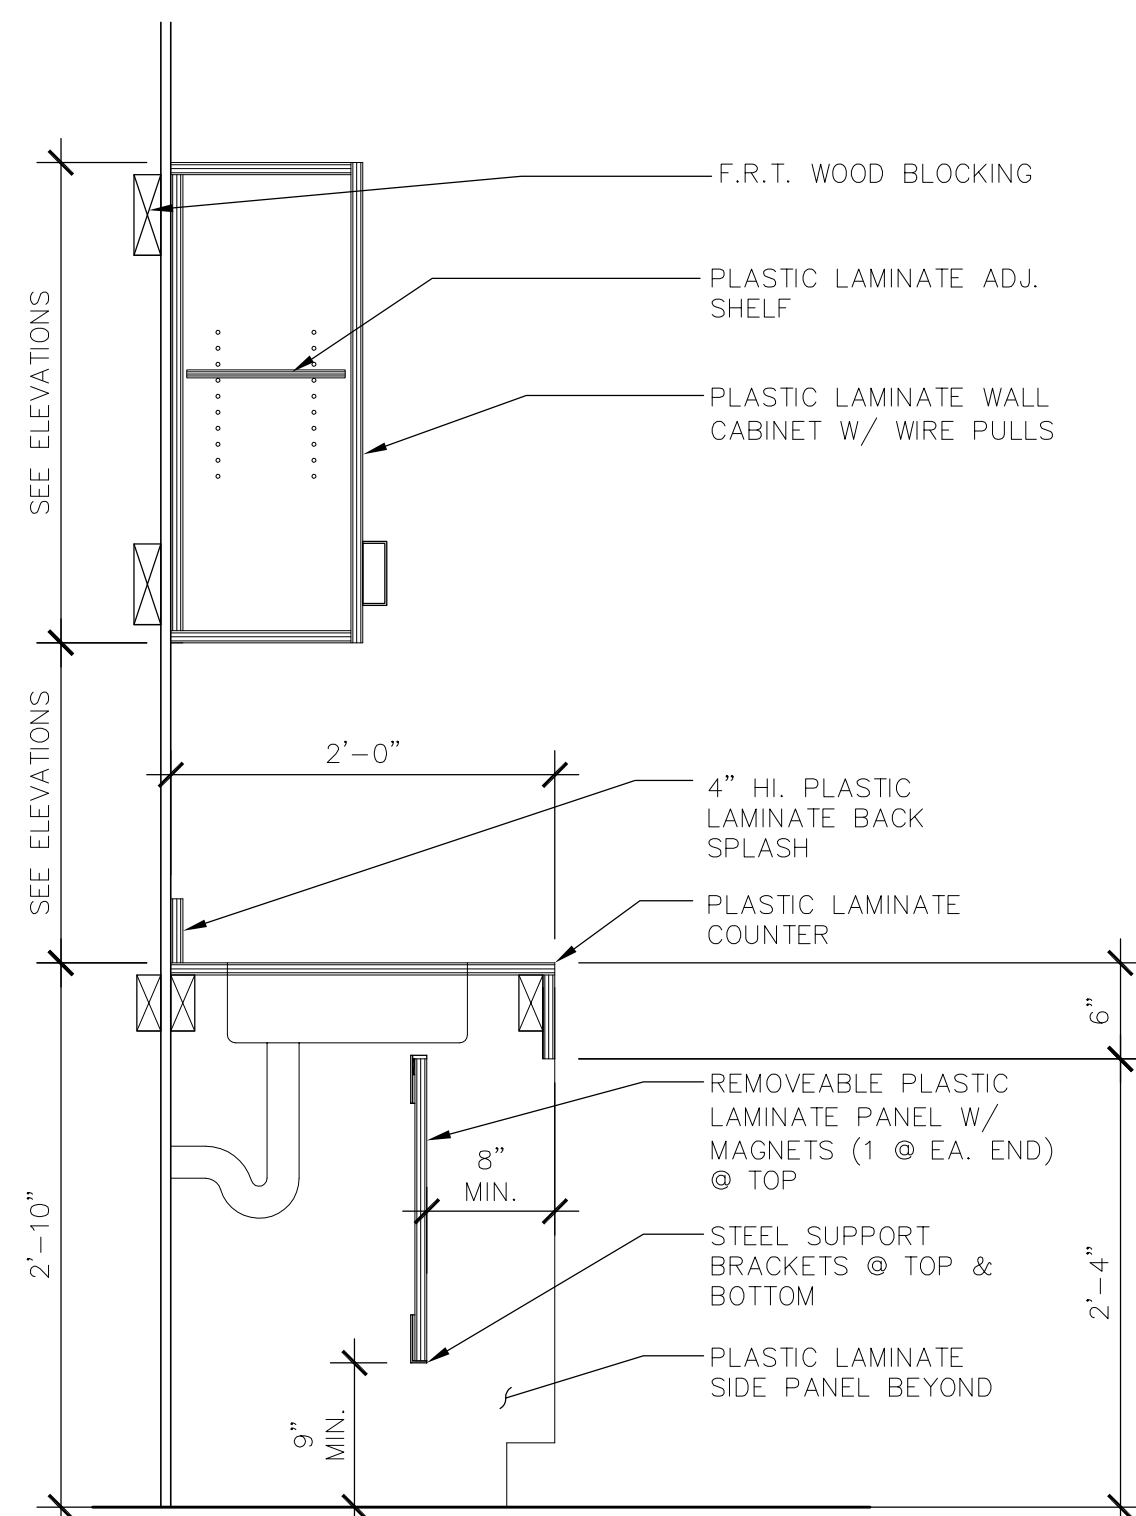


⑮ CABINET SECTION @ SINK
Scale: 1" = 1'-0"

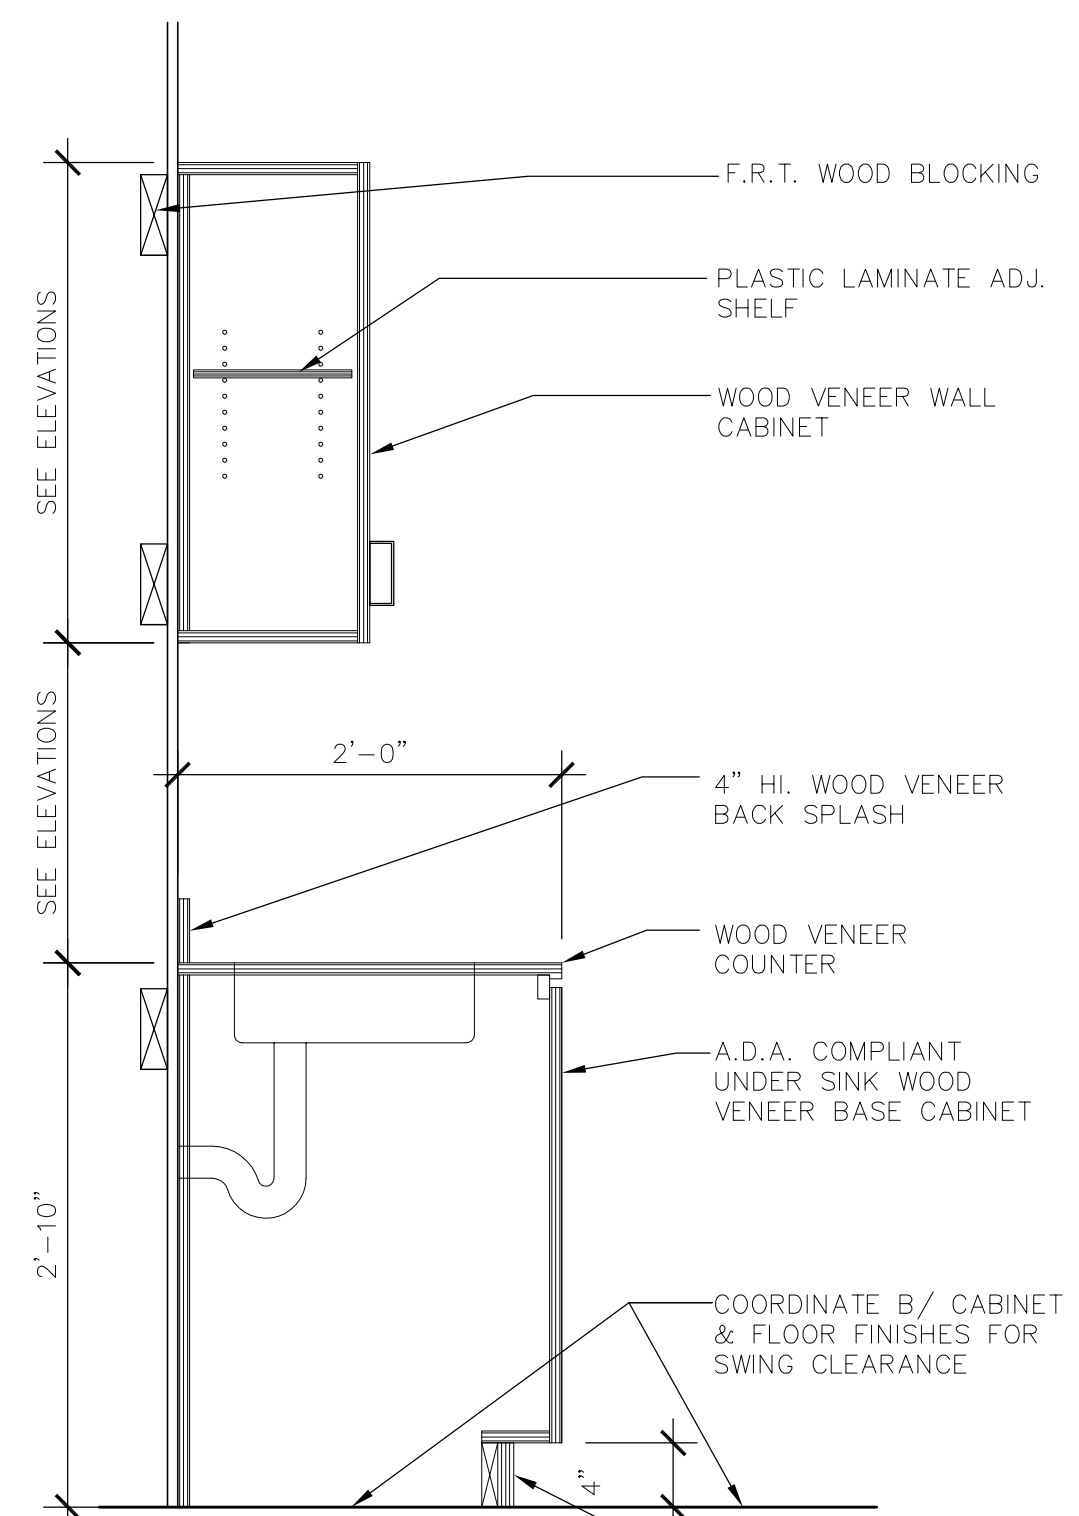


⑯ CABINET SECTION @ SINK
Scale: 1" = 1'-0"

EQUIPMENT & MISCELLANEOUS PARTS SCHEDULE/LEGEND


ABBREVIATION	PRODUCT INFORMATION	REMARKS
REF-1	FULL SIZE REFRIGERATOR W/ ICE MAKER OWNER TO SELECT AT A LATER DATE.	
REF-2	UNDERCOUNTER REFRIGERATOR LOCATION: SEE ELEVATIONS & FLOORPLANS MANUFACTURER: SUMMITT COMMERCIAL MODEL: ALB751 DIMENSIONS: 32" x 23 5/8" x 23 1/2" FINISH: STAINLESS STEEL FRONT, WHITE BODY	SEE APPLIANCE MFR. SPECS.
DW	FULL SIZE DISHWASHER (ADA COMPLIANT) LOCATION: SEE ELEVATIONS & FLOORPLANS MANUFACTURER: EUROTECH MODEL: EDW2346 DIMENSIONS: 32" H X 23-15/16" W X 21-7/8" D	SEE APPLIANCE MFR. SPECS.
MIC	MICROWAVE W/ TURN TABLE LOCATION: SEE ELEVATIONS & FLOORPLANS MANUFACTURER: GE MODEL: J1860SH DIMENSIONS: 13-1/2" X 18-13/16" X 23-7/8" FINISH: STAINLESS STEEL	- MILLWORKER TO COORDINATE CUTOUT SIZE FOR MICROWAVE. SEE APPLIANCE MFR. SPECS. - USE 27" TRIM KIT #JX1827SB FOR A BUILT-IN LOOK.
HDW-1	CONFERENCE ROOM CABINETRY HARDWARE LOCATION: CONFERENCE ROOMS ONLY SUPPLIER: B&B SUPPLY MODEL: BQ-9719-BAC DIMENSIONS: 96MM C/C FINISH: BRUSHED ANTIQUE COPPER	ALL OTHER HARDWARE SHOULD BE STANDARD STAINLESS WIRE PULLS.
F-1	CONFERENCE ROOM FAUCET LOCATION: CONFERENCE ROOMS ONLY MFR: BLANCO MODEL: 157-009-AC / APPLETON 2 HANDLE BAR FAUCET SINGLE HOLE MOUNTING	
SNK-1	CONFERENCE ROOM COPPER SINK LOCATION: CONFERENCE ROOMS ONLY MANUFACTURER: ONE DRAFTS & IMPORTS (408) 267-7536 MODEL: 220202-23 DIMENSIONS: 20" W X 22" L X 6.5" H FINISH: ANTIQUE COPPER	DROP-IN INSTALLATION. ORDER MATCHING FLANGE & DRAIN FROM ANTIQUE HARDWARE ITEM # 02017999. PHONE: 800-787-3355. PLUMBER TO VERIFY SIZE OF OPENING & DRAIN COORDINATE.

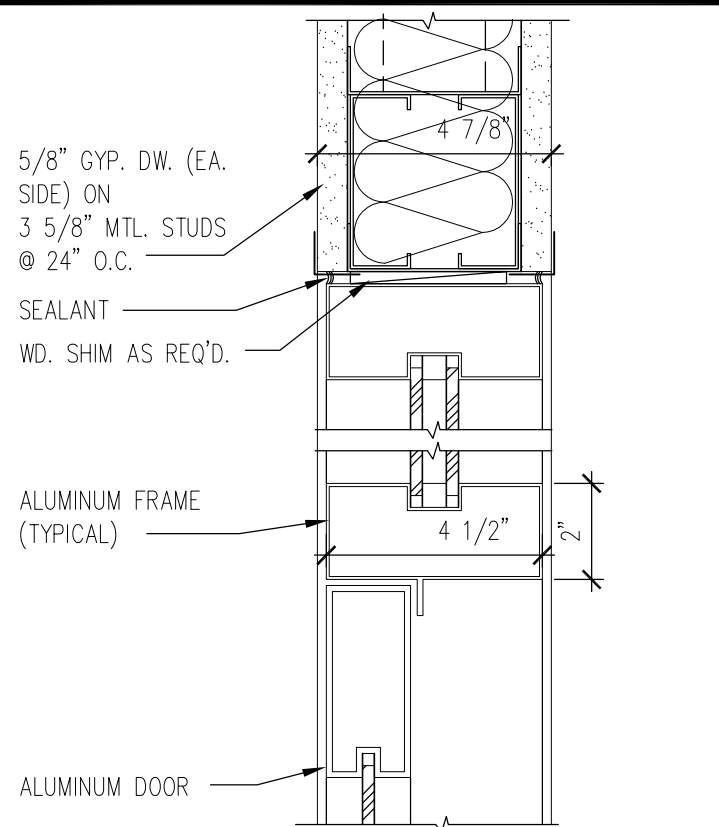

1 DOOR JAMB
Scale: 3" = 1'-0"

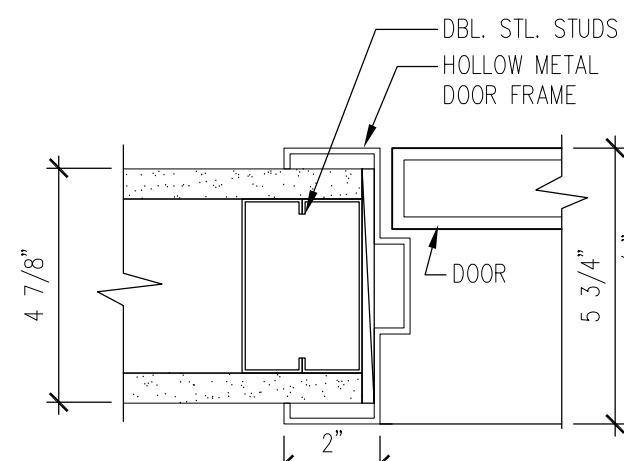

2 DOOR JAMB
Scale: 3" = 1'-0"

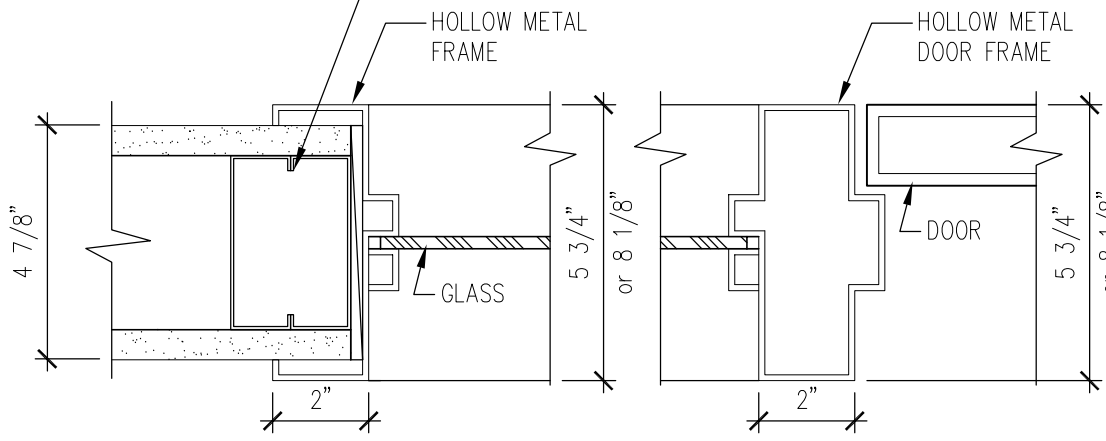

3 JAMB
Scale: 3" = 1'-0"

MATERIALS & FINISH LEGEND

ABBREVIATION	PRODUCT INFORMATION	REMARKS	ABBREVIATION	PRODUCT INFORMATION	REMARKS
CPT-1	CARPETING-MAIN AREAS- BROADLOOM MANUFACTURER: PATCRAFT PATTERN NAME: BEST FOOT FORWARD 10104 COLOR: LOWERS SHIP CONTACT: HOWARD CAROL-847-630-0752		ST- 2	STONE TILE - RECEPTION/LOBBY/CORRIDOR SUPPLIER: TERRAZO & MARBLE SUPPLY MATERIAL: 12" X 12" POLISHED GRANITE COLOR: HOT CHOCOLATE CONTACT: MIKE BRAWLEY: 847-777-6754	IF THIS ITEM IS NOT IN STOCK WITH THE NOTED DISTRIBUTOR, A SUBSTITUTE DISTRIBUTOR CAN PROVIDE SAMES FOR DESIGNER'S APPROVAL.
CPT-2	CARPETING-PRIVATE OFFICE -BROADLOOM MANUFACTURER: MANNINGTON PATTERN NAME: CENTERFIELD COLOR: COMMISSIONER CONTACT: CLYDE AUSTIN 800-241-2262 EXT 8584		ST-3	STONE TILE - RECEPTION/LOBBY/CORRIDOR SUPPLIER: TERRAZO & MARBLE SUPPLY MATERIAL: 12" X 12" TUMBLED MARBLE COLOR: CREAM MARBLE ANTIQUE CONTACT: MIKE BRAWLEY: 847-777-6754	IF THIS ITEM IS NOT IN STOCK WITH THE NOTED DISTRIBUTOR, A SUBSTITUTE DISTRIBUTOR CAN PROVIDE SAMES FOR DESIGNER'S APPROVAL.
CPT-3	CARPETING-CONFERENCE/TRAINING-BROADLOOM MANUFACTURER: PATCRAFT PATTERN NAME: JUST BEAUTIFUL 10091 COLOR: BANFF NATIONAL PARK 91115 CONTACT: HOWARD CAROL-847-630-0752		T- 1	TILE - RESTROOM FLOORS MANUFACTURER: DAL TILE MATERIAL: 12" X 12" CERAMIC TILE COLOR: #CD31 BEIGE CONTACT: JAMIE BUSH 847-208-9194	THIS ITEM IS AVAILABLE IN A 6"x6" BASE COVE TILE. SOME AREAS OF THE FINISH PLAN WILL REFERENCE THIS COLOR NUMBER, BUT USING A BASE COVE TILE.
CPT-4	CARPETING-STAIRWELL-BROADLOOM MANUFACTURER: PATCRAFT PATTERN NAME: COLOR STILL MATTERS 10093 COLOR: PORTABELLA 00261 CONTACT: HOWARD CAROL-847-630-0752		T- 2	TILE - RESTROOM FLOORS MANUFACTURER: DAL TILE MATERIAL: 12" X 12" CERAMIC TILE COLOR: #VS08 BROWN STONE CONTACT: JAMIE BUSH 847-208-9194	THIS ITEM IS AVAILABLE IN A 6"x6" BASE COVE TILE. SOME AREAS OF THE FINISH PLAN WILL REFERENCE THIS COLOR NUMBER, BUT USING A BASE COVE TILE.
CPT-5	CARPETING-TRAINING ROOM ONLY-BROADLOOM MANUFACTURER: PATCRAFT PATTERN NAME: SWEET 10049 COLOR: SWEET IDEAL 49153 CONTACT: HOWARD CAROL-847-630-0752		T- 3	TILE - RESTROOM FLOORS MANUFACTURER: DAL TILE MATERIAL: 12" X 12" CERAMIC TILE COLOR: #CD28 BIANCO CONTACT: JAMIE BUSH 847-208-9194	THIS ITEM IS AVAILABLE IN A 6"x6" BASE COVE TILE. SOME AREAS OF THE FINISH PLAN WILL REFERENCE THIS COLOR NUMBER, BUT USING A BASE COVE TILE.
F-1	FABRIC - ELEVATOR VERTICAL PANELS MANUFACTURER: HBE TEXTILES PATTERN NAME: NEITHER HIDE NOR HAIR #648-36 COLOR: CHURN CONTACT: RENEE SILVERSTEIN-828-328-2064	ELEVATOR MANUFACTURER TO COORDINATE THIS PRODUCT'S APPLICATION TO THE VERTICAL APPLIED PANELS.	T- 4	TILE - RESTROOM WALLS MANUFACTURER: DAL TILE MATERIAL: 4" X 4" PORCELAIN TILE COLOR: #113 CONTACT: JAMIE BUSH 847-208-9194	MAPEI GROUT COLOR: 48 ALMOND
M-1	METAL ACCENT - LOBBY PANELING REVEAL MANUFACTURER: CHEMETAL PATTERN NAME: METAL MICA COLOR: #913 POLISHED BRONZE ALUMINUM CONTACT: PARKWOOD - 847-577-8001		T- 5	TILE - RESTROOM WALLS MANUFACTURER: DAL TILE MATERIAL: 4" X 4" PORCELAIN TILE COLOR: #113 CONTACT: JAMIE BUSH 847-208-9194	MAPEI GROUT COLOR: 48 ALMOND
PL-1	PLASTIC LAMINATE - BREAK ROOM C-TOPS MANUFACTURER: WILSONART COLOR: KALAHARI TOPAZ 4598-07 CONTACT: EKD 847-451-9300	BEVELED EDGE DETAIL	VB-1	VINYL WALL BASE - 4" HIGH MANUFACTURER: ARMSTRONG COLOR: 71 MID GRAY TYPE: STRAIGHT BASE & COVED BASE CONTACT: CAROL SCHIEREN-847-721-8506	STRAIGHT BASE IS TO BE USED ON CARPET LOCATIONS. COVED BASE IS TO BE USED ON VINYL TILE & ALL OTHER LOCATIONS.
PL-2	PLASTIC LAMINATE - BREAK ROOM CABINETRY MANUFACTURER: WILSONART COLOR: PEARL BISSUE 0485-07 CONTACT: EKD 847-451-9300		VB-2	VINYL WALL BASE - 4" HIGH MANUFACTURER: ARMSTRONG COLOR: 71 DEEP BROWN TYPE: STRAIGHT BASE & COVED BASE CONTACT: CAROL SCHIEREN-847-721-8506	STRAIGHT BASE IS TO BE USED ON CARPET LOCATIONS. COVED BASE IS TO BE USED ON VINYL TILE & ALL OTHER LOCATIONS.
PL-3	PLASTIC LAMINATE - ALL OTHER C-TOPS MANUFACTURER: WILSONART COLOR: LESTONE 4789-60 CONTACT: EKD 847-451-9300	SQUARE EDGE DETAIL	VB-3	VINYL WALL BASE - 4" HIGH MANUFACTURER: ARMSTRONG COLOR: 20 OYSTER TYPE: STRAIGHT BASE & COVED BASE CONTACT: CAROL SCHIEREN-847-721-8506	STRAIGHT BASE IS TO BE USED ON CARPET LOCATIONS. COVED BASE IS TO BE USED ON VINYL TILE & ALL OTHER LOCATIONS.
PL-4	PLASTIC LAMINATE - ALL OTHER CABINETRY MANUFACTURER: WILSONART COLOR: NATURAL ALMOND 030-60 CONTACT: EKD 847-451-9300		VB-4	VINYL WALL BASE - 4" HIGH MANUFACTURER: ARMSTRONG COLOR: 64 FRESH TAUPÉ TYPE: STRAIGHT BASE & COVED BASE CONTACT: CAROL SCHIEREN-847-721-8506	STRAIGHT BASE IS TO BE USED ON CARPET LOCATIONS. COVED BASE IS TO BE USED ON VINYL TILE & ALL OTHER LOCATIONS.
PL-5	PLASTIC LAMINATE - CONFERENCE ROOM C-TOPS MANUFACTURER: WILSONART COLOR: 4846-60 MORRO ZEPHYR CONTACT: EKD 847-451-9300	SQUARE EDGE DETAIL	VCT-1	VINYL COMPOSITION TILE MANUFACTURER: ARMSTRONG PATTERN NAME: PREMIUM EXCELLEN / STONETEX COLOR: #52139 LIMESTONE BEIGE	
PT-1	PAINT - MANUFACTURER: SHERWIN WILLIAMS COLOR: #0909 STURBRIDGE STONE FINISH: EGGSHELL	SEE FINISH PLANS FOR DETAILS ABOUT LOCATIONS.	VCT-2	VINYL COMPOSITION TILE MANUFACTURER: ARMSTRONG PATTERN NAME: PREMIUM EXCELLEN / STONETEX COLOR: #52139 DUSTY KAYAK	
PT-2	PAINT - MANUFACTURER: SHERWIN WILLIAMS COLOR: SW1144 IMPORT IVORY FINISH: EGGSHELL	SEE FINISH PLANS FOR DETAILS ABOUT LOCATIONS.	WC-1	WALLCOVERING - TYPE II MANUFACTURER: SANTITAS & METRO PATTERN NAME: OBAMA #002-08A-03 COLOR: #002-08A-03 CONTACT: CARON CHRISTY 800-479-1109 LOCATION: RECEPTION	
PT-3	PAINT - MANUFACTURER: SHERWIN WILLIAMS COLOR: SW1949 WHITE RADISH FINISH: EGGSHELL	SEE FINISH PLANS FOR DETAILS ABOUT LOCATIONS.	WC-2	WALLCOVERING - TYPE II MANUFACTURER: SANTITAS & METRO PATTERN NAME: LAVINIA SILK #002-LVS-03 COLOR: #002-LVS-03 CONTACT: CARON CHRISTY 800-479-1109 LOCATION: CONFERENCE ROOMS	
PT-4	PAINT - MANUFACTURER: SHERWIN WILLIAMS COLOR: SW1132 TUMBLEWEED FINISH: EGGSHELL	SEE FINISH PLANS FOR DETAILS ABOUT LOCATIONS.	WC-3	WALLCOVERING - TYPE II MANUFACTURER: SANTITAS & METRO PATTERN NAME: LAVINIA SILK #002-LVS-18 COLOR: #002-LVS-18 CONTACT: CARON CHRISTY 800-479-1109 LOCATION: 2ND FLOOR ELEV. LOBBY	
PT-5	PAINT - MANUFACTURER: SHERWIN WILLIAMS COLOR: 1141 CROQUET TAN FINISH: EGGSHELL	SEE FINISH PLANS FOR DETAILS ABOUT LOCATIONS.	WC-4	WALLCOVERING - TYPE II MANUFACTURER: SANTITAS & METRO PATTERN NAME: INDULGENCE #9021-29 COLOR: VIA APPA CONTACT: CARON CHRISTY 800-479-1109 LOCATION: 1ST FLOOR ELEV. LOBBY	
PT-6	PAINT - MANUFACTURER: SHERWIN WILLIAMS COLOR: 3135 CASTLE FOAM FINISH: EGGSHELL	SEE FINISH PLANS FOR DETAILS ABOUT LOCATIONS.	WC-5	WALLCOVERING - TYPE II MANUFACTURER: MAHARAM PATTERN NAME: WHIRLWIND COLOR: CRYSTAL 3394001-003 CONTACT: MAHARAM 800-645-3943 LOCATION: WOMEN'S RESTROOMS	
PT-7	PAINT - MANUFACTURER: BENJAMIN MOORE COLOR: 20-314 MEADOW MIST FINISH: EGGSHELL	SEE FINISH PLANS FOR DETAILS ABOUT LOCATIONS.	WC-6	WALLCOVERING - TYPE II MANUFACTURER: MAHARAM PATTERN NAME: WHIRLWIND COLOR: CRYSTAL 3394001-003 CONTACT: MAHARAM 800-645-3943 LOCATION: MEN'S RESTROOMS	
PT-8	PAINT-STANDARD WHITE W/O PIGMENT ADDED MANUFACTURER: SHERWIN WILLIAMS COLOR: NONE - FINISH: FLAT	SEE FINISH PLANS FOR DETAILS ABOUT LOCATIONS. MOSTLY USED IN MECHANICAL LOCATIONS AND AREAS WITH SEALED CONCRETE.	WC-7	WALLCOVERING - TYPE II MANUFACTURER: MDC WALLCOVERINGS/AYCON PATTERN NAME: AYCON VALUE PROGRAM COLOR: #251-4241 CONTACT: MDC WALLCOVERING (800) 621-4006 LOCATION: TENANT RECEPTION AREAS	
PT-9	PAINT-METAL DOOR FRAMES MANUFACTURER: SHERWIN WILLIAMS COLOR TO MATCH: 2731 OLIVE BROWN FINISH: ALL SURFACE LATEX GLOSS	ALL INTERIOR METAL DOOR FRAMES, UNLESS OTHERWISE NOTED ON DOOR SCHEDULE.	W-1	WOOD FINISH MANUFACTURER: MARSHFIELD - 800-869-3667 SPECIES: PLAIN Sliced WHITE MAPLE STAIN: #1000 CONTACT: MARSHFIELD 800-869-3667 LOCATION: ALL INTERIOR DOORS	IF THIS FINISH IS SPECIFIED FOR BUILT-IN CABINETRY, THE CABINETRY MUST BE MADE FROM THE SAME SPECIES/OUT & STAINED TO MATCH THIS PRODUCT.
SS-1	SOLID SURFACE - RESTROOM C-TOPS MANUFACTURER: CORYAN COLOR: ABALONE (E)	3/4" MATERIAL SQUARE EDGE ATTACHED CREATING 1.5" OVERALL EDGE THICKNESS	WO-1	RECESSED WALK OFF MAT- CARPET THREAD MANUFACTURER: J INDUSTRIES 952-835-6850 MODEL: #1000 CONTACT: J INDUSTRIES 952-835-6850 LOCATION: 1ST FLOOR VESTIBULE	
ST-1	STONE TILE - RECEPTION/LOBBY/CORRIDOR SUPPLIER: TERRAZO & MARBLE SUPPLY MATERIAL: 12" X 12" POLISHED MARBLE COLOR: MAGGIORE CONTACT: MIKE BRAWLEY: 847-777-6754	IF THIS ITEM IS NOT IN STOCK WITH THE NOTED DISTRIBUTOR, A SUBSTITUTE DISTRIBUTOR CAN PROVIDE SAMES FOR DESIGNER'S APPROVAL.			MAPEI GROUT COLOR: 47 CHARCOAL ANTHRACITE

DOOR & FRAME SCHEDULE																											
DOOR NUMBER	DOOR					FRAME							HARDWARE													DOOR REMARKS:	
	SIZE			MATERIAL	TYPE	LOUVER		MATL	TYPE	DETAILS				FIRE RATING IN HOURS	DOOR CLOSER	PANIC LOCK SET	LATCH SET	PRIVACY LOCK	PUSH/PULL	KICK PLATE	WALL STOP	THRESHOLD STRIPPING	SIGNAGE	180° PEEPHOLE	FLUSH BOLTS	No. PAIR BUTTS	SEE LISTING NEXT TO SCHEDULE
	WIDTH	HEIGHT	THICK.			WIDTH	HEIGHT			JAMB	HEAD	SILL	1														
111C	3'-0"	8'-0"	1 3/4"	WOOD	2			H.M.	A	2	2	SIM.														2	
113	(2)3'-0"	8'-0"	1 3/4"	WOOD	3			H.M.	A	2		-														4	13
114	3'-0"	8'-0"	1 3/4"	WOOD	2			H.M.	A	2	2	SIM.														2	
115	(2)3'-0"	8'-0"	1 3/4"	WOOD	3			H.M.	A	2		-														4	13
116	3'-0"	8'-0"	1 3/4"	WOOD	2			H.M.	B	3	2	SIM.														2	
117	3'-0"	8'-0"	1 3/4"	WOOD	2			H.M.	B	3	2	SIM.														2	
118	3'-0"	8'-0"	1 3/4"	WOOD	2			H.M.	A	2	2	SIM.														2	
119	3'-0"	8'-0"	1 3/4"	WOOD	2			H.M.	B	3	2	SIM.														2	
120	3'-0"	8'-0"	1 3/4"	WOOD	2			H.M.	B	3	2	SIM.														2	
121	3'-0"	8'-0"	1 3/4"	WOOD	2			H.M.	B	3	2	SIM.														2	
122	3'-0"	8'-0"	1 3/4"	WOOD	2			H.M.	B	3	2	SIM.														2	
123	3'-0"	8'-0"	1 3/4"	WOOD	2			H.M.	B	3	2	SIM.														2	
124	3'-0"	8'-0"	1 3/4"	WOOD	2			H.M.	B	3	2	SIM.														2	
126	(2)3'-0"	8'-0"	1 3/4"	WOOD	2			H.M.	A	2	2	SIM.														4	
127	(2)3'-0"	8'-0"	1 3/4"	WOOD	2			H.M.	A	2	2	SIM.														4	
144	3'-0"	8'-0"	1 3/4"	WOOD	2			H.M.	B	3	2	SIM.														2	
145	3'-0"	8'-0"	1 3/4"	WOOD	2			H.M.	B	3	2	SIM.														2	
146	3'-0"	8'-0"	1 3/4"	WOOD	2			H.M.	B	3	2	SIM.														2	
147	3'-0"	8'-0"	1 3/4"	WOOD	2			H.M.	A	2	2	SIM.														2	
148	3'-0"	8'-0"	1 3/4"	WOOD	2			H.M.	A	2	2	SIM.														2	12
				</																							

ROOM FINISH SCHEDULE																							
R/N NUMBER	ROOM NAME	FLOOR	BASE		WALLS				CEILING		REMARKS REFER TO NOTES NEXT TO SCHEDULE.	R/N NUMBER	ROOM NAME	FLOOR	BASE		WALLS				CEILING		REMARKS REFER TO NOTES NEXT TO SCHEDULE.
			MATERIAL	HT.	NORTH NORTHWEST	EAST NORTHEAST	SOUTH SOUTHEAST	WEST SOUTHWEST	MATERIAL	HEIGHT					MATERIAL	HT.	NORTH NORTHWEST	EAST NORTHEAST	SOUTH SOUTHEAST	WEST SOUTHWEST	MATERIAL	HEIGHT	
100	EXIST. SPINK. RM.	EXIST.	EXIST.	EXIST.	EXIST.	EXIST.	EXIST.	EXIST.	EXIST.	EXIST.			EXIST. WOMEN	EXIST.		EXIST.	EXIST.	EXIST.	EXIST.	EXIST.	EXIST.		
101	EXIST. VESTIBULE	EXIST.	EXIST.	EXIST.	EXIST.	EXIST.	EXIST.	EXIST.	EXIST.	EXIST.		201	EXIST. WOMEN	EXIST.		EXIST.	EXIST.	EXIST.	EXIST.	EXIST.	EXIST.		
102	EXIST. VESTIBULE	EXIST.	EXIST.	EXIST.	EXIST.	EXIST.	EXIST.	EXIST.	EXIST.	EXIST.		202	EXIST. MEN	EXIST.		EXIST.	EXIST.	EXIST.	EXIST.	EXIST.	EXIST.		
103	EXIST. LOBBY	EXIST.	EXIST.	EXIST.	EXIST.	EXIST.	EXIST.	EXIST.	EXIST.	EXIST.		203	EXIST. JANITOR	EXIST.		EXIST.	EXIST.	EXIST.	EXIST.	EXIST.	EXIST.		
104	EXIST. ELEV. EQUIP	EXIST.	EXIST.	EXIST.	EXIST.	EXIST.	EXIST.	EXIST.	EXIST.	EXIST.		204	VESTIBULE	STONE TILE	VINYL	4" COVE	WC	WC	WC	WC	ACOUSTIC TILE	10'-0"	
105	EXIST. JANITOR	EXIST.	EXIST.	EXIST.	EXIST.	EXIST.	EXIST.	EXIST.	EXIST.	EXIST.	7	205	GENERAL OFFICE	CPT	VINYL	4"	D.W./PAINT	D.W./PAINT	D.W./PAINT	D.W./PAINT	ACOUSTIC TILE	10'-0"	
106	EXIST. CORRIDOR	EXIST.	EXIST.	EXIST.	EXIST.	EXIST.	EXIST.	EXIST.	EXIST.	EXIST.		206	CLOSET	CPT	VINYL	4"	D.W./PAINT	D.W./PAINT	D.W./PAINT	D.W./PAINT	ACOUSTIC TILE	10'-0"	
												254	CORRIDOR	CPT	VINYL	4"	D.W./PAINT	D.W./PAINT	D.W./PAINT	D.W./PAINT	ACOUSTIC TILE	10'-0"	
												255	STORAGE	VCT	VINYL	4" COVE	D.W./PAINT	D.W./PAINT	D.W./PAINT	D.W./PAINT	ACOUSTIC TILE	10'-0"	
												256	CLOSET	VCT	VINYL	4" COVE	D.W./PAINT	D.W./PAINT	D.W./PAINT	D.W./PAINT	ACOUSTIC TILE	10'-0"	
							</																

ABBREVIATIONS:

CONC. = CONCRETE (PRECAST) WALL PANEL
DW. = DRYWALL
T&S = TAPED & SANDED ONLY
PT. = PAINT
WC. = WALL COVERING
WP. = WOOD PANELING
CT. = CERAMIC TILE
ST. = STONE TILE
VCT = VINYL COMPOSITE TILE
CPT = CARPET
FRP = FIBERGLASS REINFORCED PANEL
EXP. CONST. = EXPOSED CONSTRUCTION

FLAME SPREAD OF ALL INTERIOR

FINISHES SHALL BE:

STAIRS/ELEVATOR: 0 TO 25 (CLASS I)
CORRIDORS: 26 TO 75 (CLASS II)
OTHER SPACES: 76 TO 200 (CLASS III)

ROOM FINISH NOTES:

1. FLOOR SURFACES ALONG ACCESSIBLE ROUTES AND IN ACCESSIBLE ROOMS AND SPACES INCLUDING FLOOR, RAMPS, STAIRS AND CURB RAMPS SHALL BE STABLE, FIRM AND SLIP RESISTANT.

2. TRANSITIONAL HEIGHTS BETWEEN CARPET AND TILE ALONG ACCESSIBLE ROUTES MAYBE 1/4 in. VERTICAL AND WITHOUT EDGE TREATMENT. CHANGES IN LEVEL BETWEEN 1/4 in. AND 1/2 in. SHALL BE BEVELED WITH A SLOPE NO GREATER THAN 1:2.

3. ALL EXPOSED INSULATION SHALL BE PROVIDED WITH A PROTECTIVE FOIL FACE BARRIER, HAVING A FLAME SPREAD RATING OF 25 (CLASS A) WHICH SHALL LIMIT THE AVERAGE TEMPERATURE RISE OF THE UNEXPOSED SURFACE TO NOT MORE THAN 250 °F AFTER 15 MINUTES OF FIRE EXPOSURE.

4. WITH-IN JANITOR CLOSETS
PROVIDE A F.R.P. PANEL ADJACENT TO THE MOP SINK.


5. BELOW THE CERAMIC TILE FLOOR FINISH ON SUSPENDED SLABS, PROVIDE A WATERPROOF MEMBRAN SYSTEM, 'LATICRETE 9235' OR EQUAL; A LIQUID-LATEX RUBBER WITH FABRIC REINFORCEMENT.

6. BELOW THE STONE TILE, PROVIDE A CRACK ISOLATION MEMBRANE ALONG THE CONCRETE CONTROL JOINTS.


7. WITHIN JANITOR CLOSETS
PROVIDE A 4'-0" HIGH F.R.P. WAINSCOT @ ALL WALLS

NOTES:
-- PROVIDE BRACING AS REQUIRED TO UNDERSIDE OF BAR JOISTS OR DECK @ 48" O.C. & @ EACH SIDE OF ALL DOOR OPENINGS


-- ALL EXPOSED INSULATIONS SHALL BE PROVIDED WITH A PROTECTIVE FOIL BARRIER, THIS SHALL INCLUDE THE AREA BETWEEN CEILING (LAY-IN) TILES AND THE FLOOR OR ROOF ABOVE. BATTS & BLANKETS 25 FLAME SPREAD OR LESS.

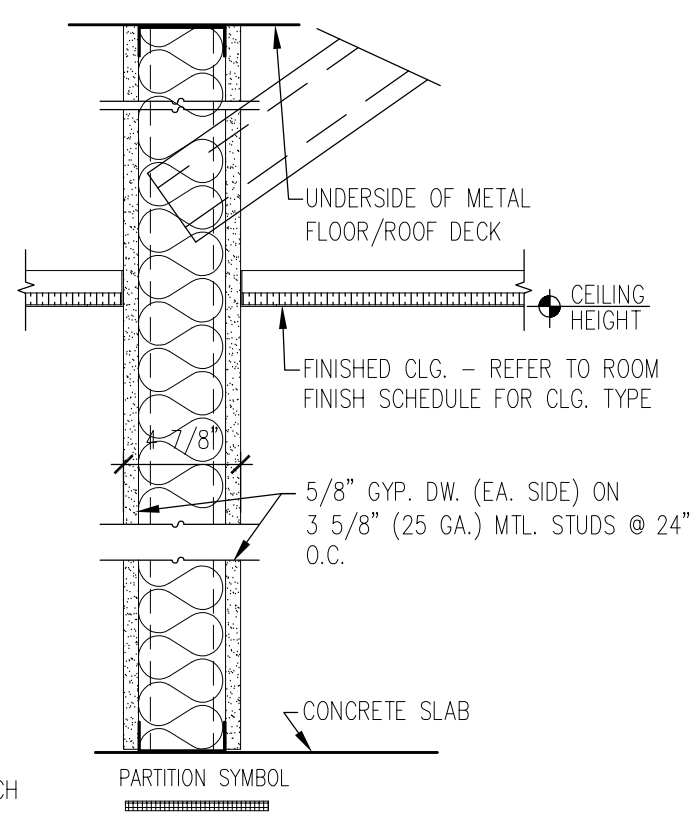


1 PARTITION TYPE
A607 Scale: 1 1/2" = 1'-0"

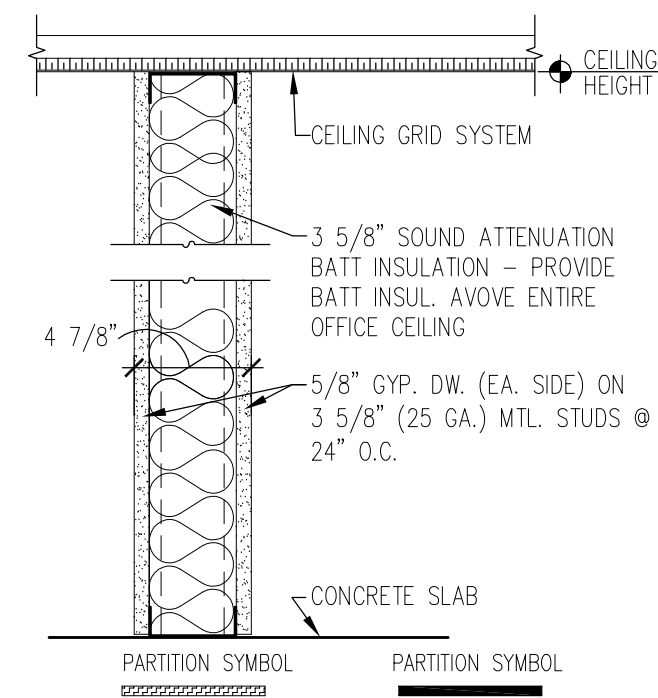


2 PARTITION TYPE
A607 Scale: 1 1/2" = 1'-0"

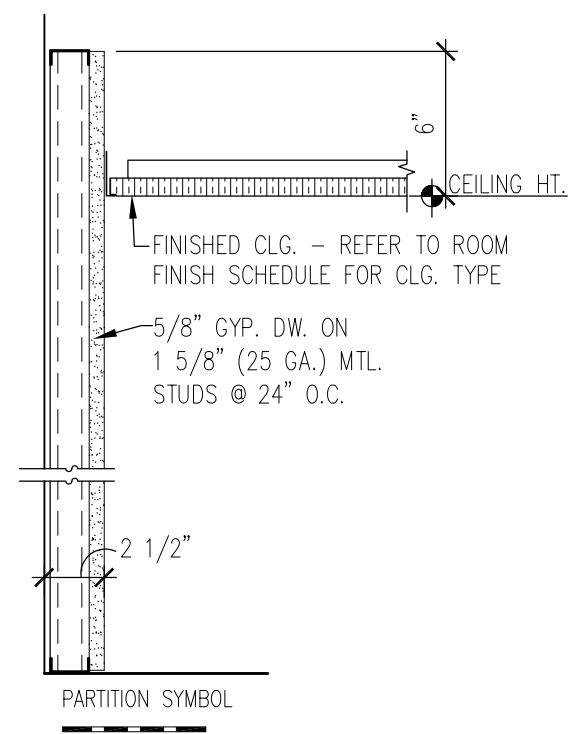

3 WALL FURRING
A607 Scale: 1 1/2" = 1'-0"

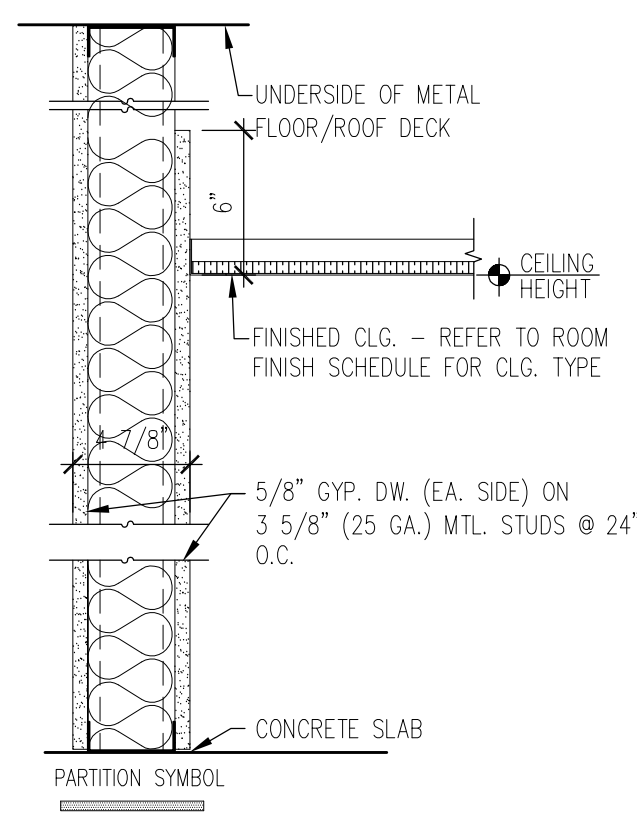

4 PARTITION TYPE
A607 Scale: 1 1/2" = 1'-0"

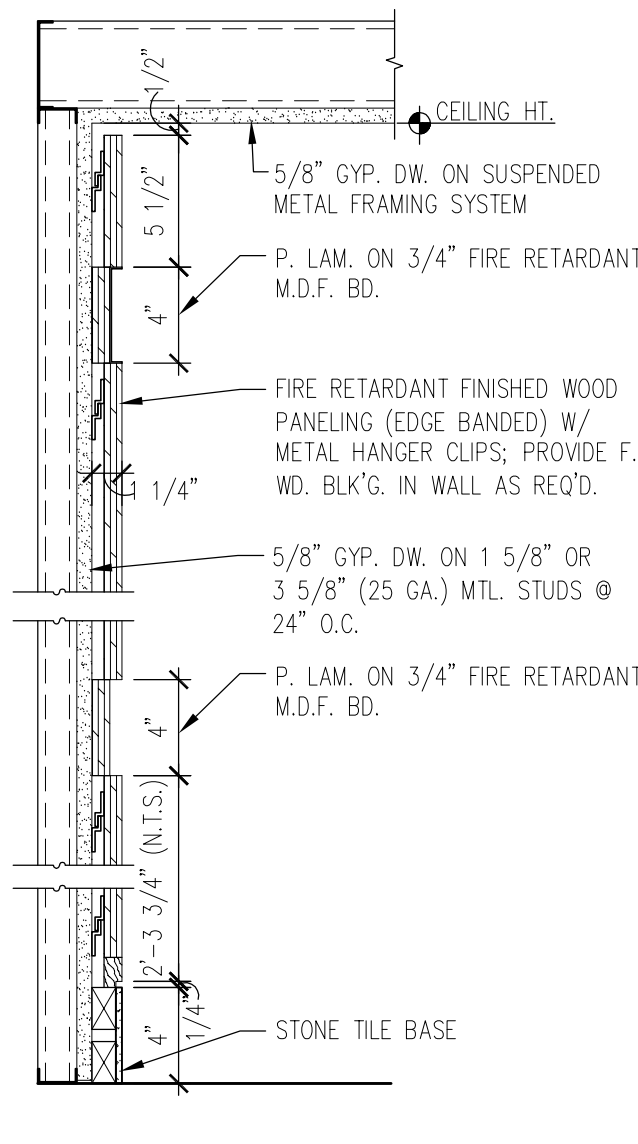

5 WALL FURRING
A607 Scale: 1 1/2" = 1'-0"

Revisions:
8/31/05 Initial Interior Permit Submittal
10/14/05 Rev's-Owner Fnsh Rev. M
1/11/06 Owner Revisions
03/12/06 - Record Set

Scale: 1 1/2" = 1'

Date: 03/12/06

Drawn By:

PARAGON GLOBAL RESOURCES
CANTERA CORPORATE CENTER – LOT 1
27501 BELLA VISTA PARKWAY
WARRENVILLE, ILLINOIS

Certified By


Drawing Number

A607

Of Sheets

A/E Job Number: 04-094

 Duke CONSTRUCTION 4225 Naperville Road Suite 150 Naperville, IL 60563 Phone: (630) 577-7900 Fax: (630) 577-7979	
TMA Architects - Planners Timothy Morgan Associates 200 Tri-State International Center Suite 100 Lisle, IL 60532 847 374-0058 phone 847 374-0057 fax	
Revisions: 8/31/05 Initial Interior Permit Submittal 10/14/05 Rev's—Owner F'nsh Rev. Mtg. 1/11/06 Owner Revisions 03/12/06 — Record Set	Scales: 1" = 1/2" = 1' Date: 03/12/06 Drawn By: MUK Checked By:
PARAGON GLOBAL RESOURCES CANTERA CORPORATE CENTER — LOT 1 27501 BELLA VISTA PARKWAY WARRENVILLE, ILLINOIS	
INTERIOR BUILD—OUT ROOM FINISH SCHEDULE, DETAILS	
Certified By:	
Drawing Number: A607 Of Sheets	
Duke Realty Job Number: PARAGON—001	
A/E Job Number: 04—094	

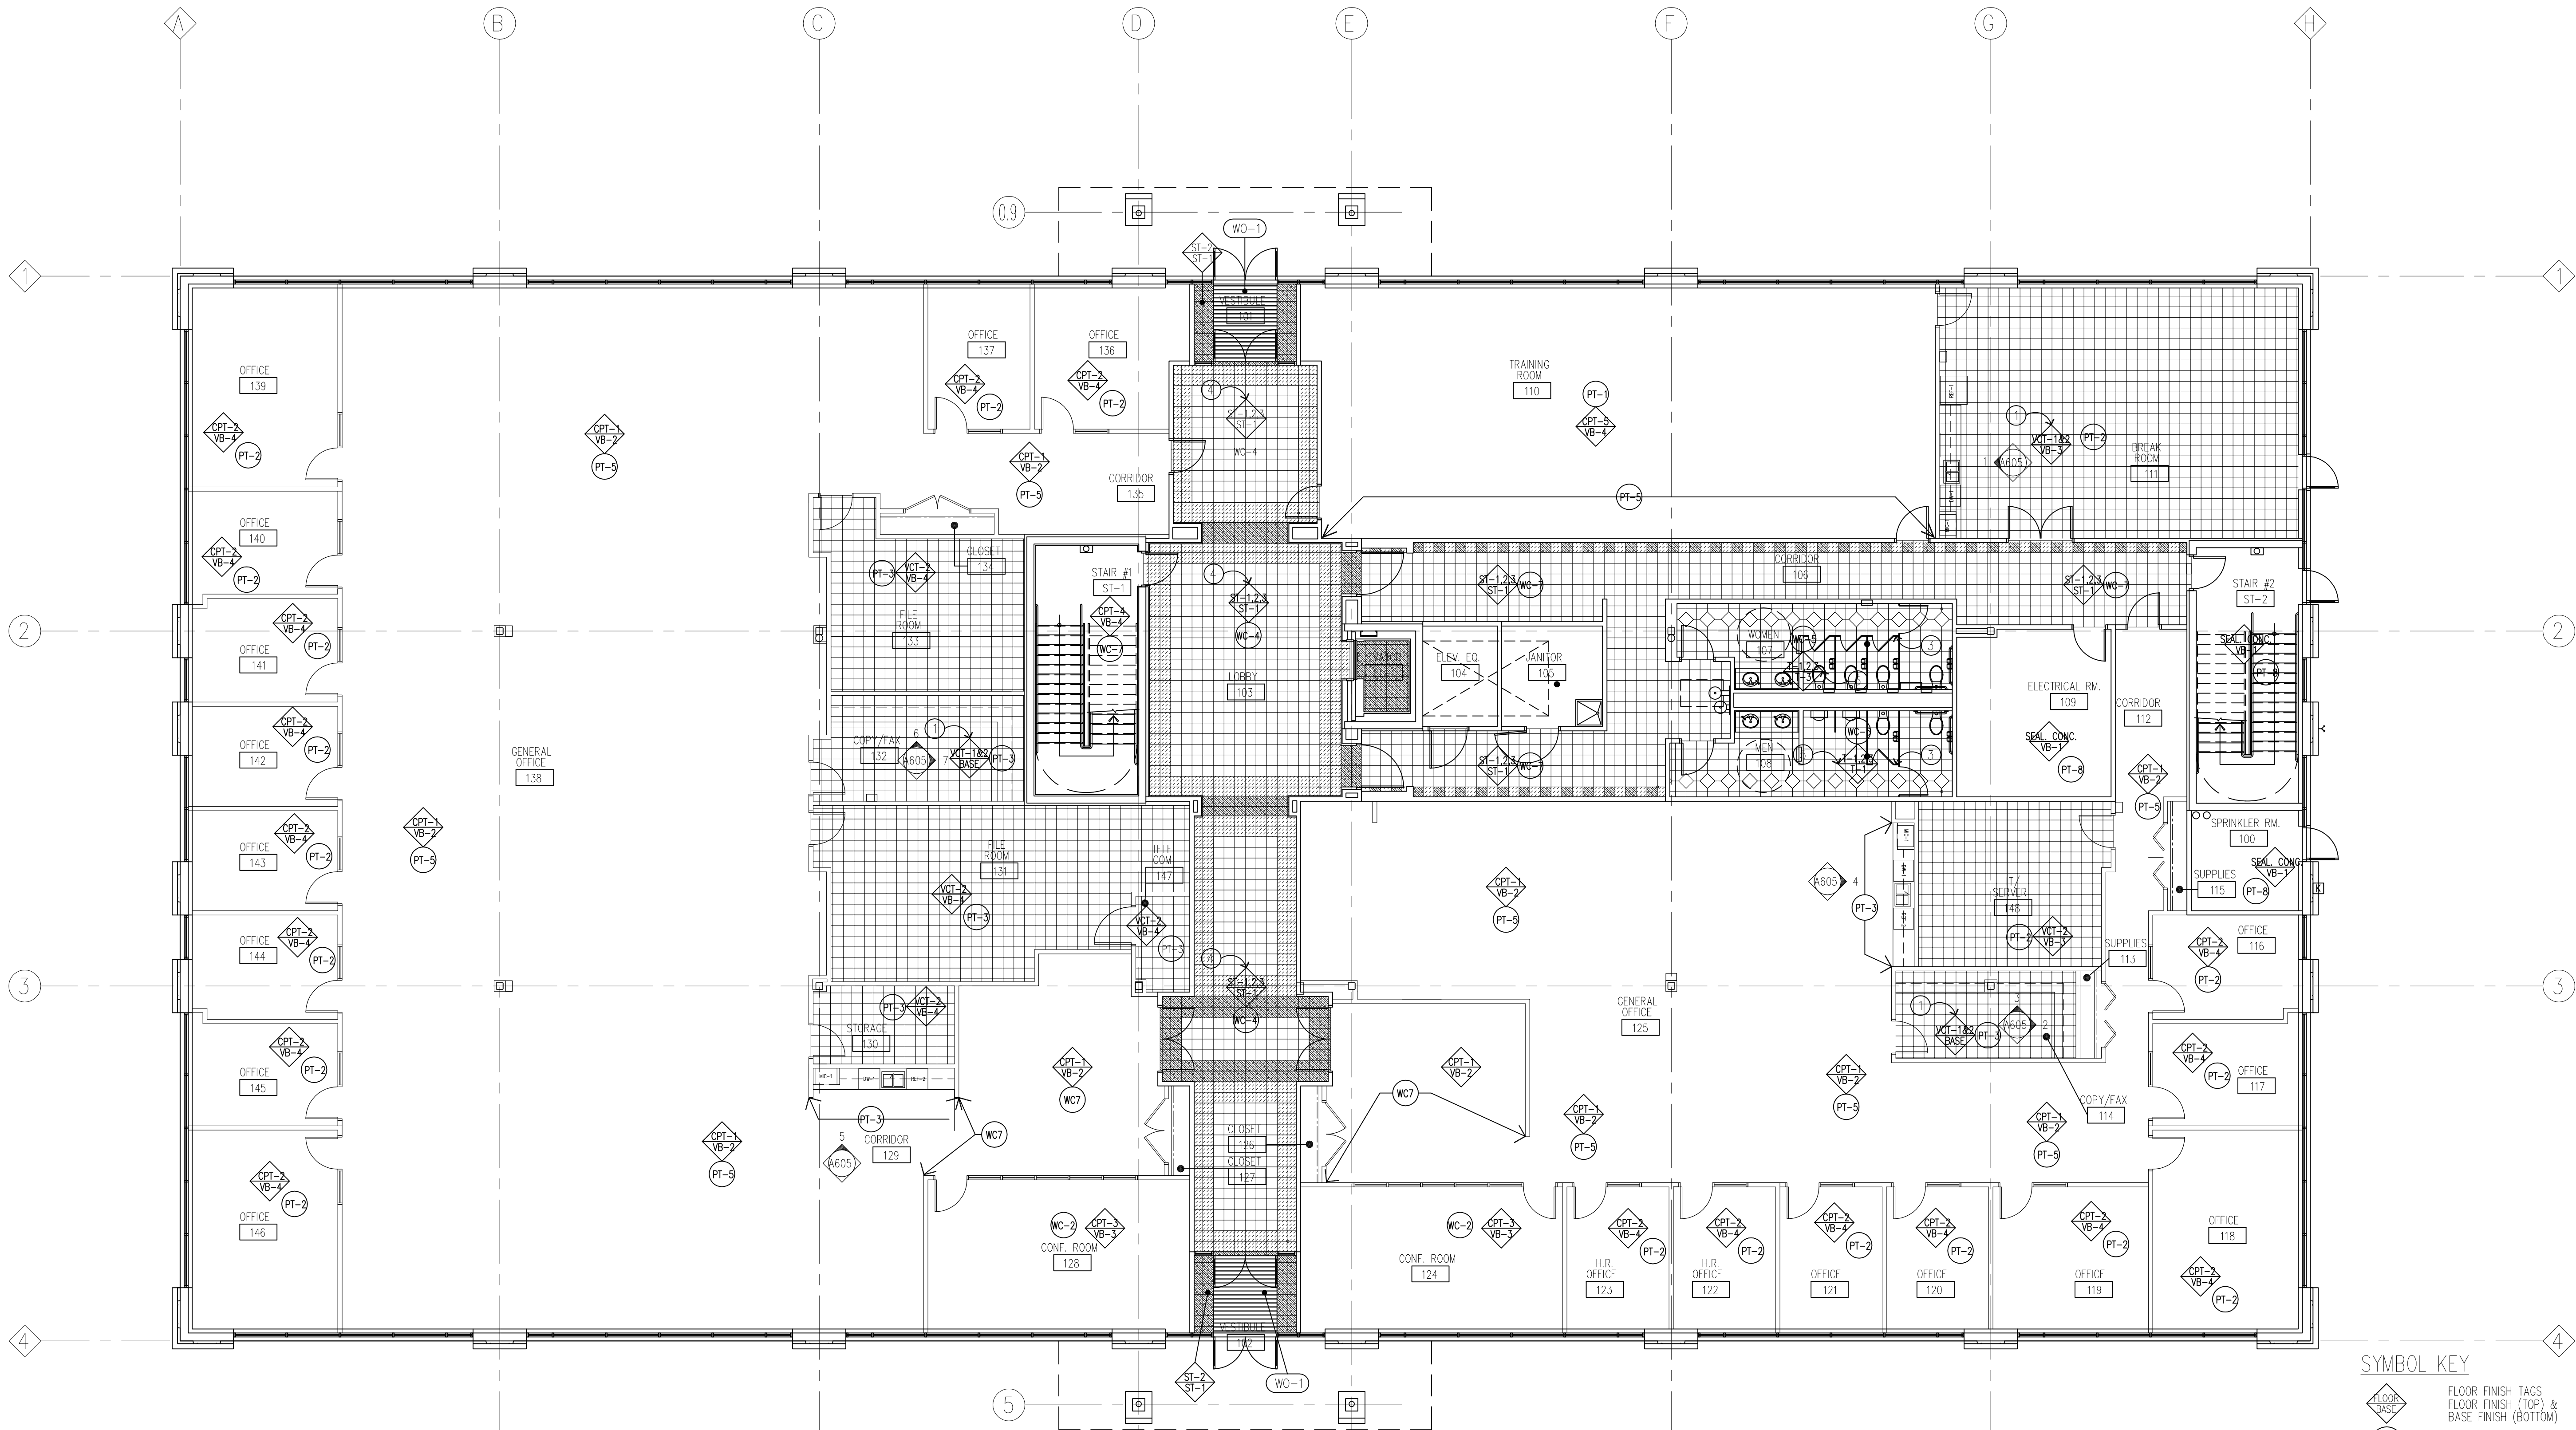

GENERAL FINISH NOTES (SEE FINISH LEGEND ON SHEET #A606 FOR PRODUCT INFORMATION):

1. ALL FLOOR FINISHES ARE TO TRANSITION UNDER THE CENTER OF THE DOORWAY, UNLESS OTHERWISE NOTED.
2. ALL STONE TILE BASE SHALL BE 4" X 12" PIECES CUT FROM 12"X12" STONE TILES SPECIFIED.
3. PLEASE CROSS REFERENCE ALL ELEVATIONS FOR EVERY VERTICAL FINISH LOCATION.
4. ALL CLOSET INTERIORS ARE FINISHED WITH THE SAME PAINT AND CARPET AS THEIR ADJOINING CORRIDOR FINISHES, UNLESS OTHERWISE NOTED.
5. THE WALL FINISH LISTED ON THE WALL TAG IN THE CENTER OF EACH ROOM IS THE 'MAIN' WALL FINISH. SOME ROOMS HAVE ACCENT WALLS OF A SECONDARY FINISH (SEE NOTED PLANS).
6. SEE FINISH LEGEND FOR GROUT COLORS. EACH TILE HAS A MATCHING GROUT COLOR.
7. MINIBLINDS FOR ALL WINDOWS SHOULD MATCH THE ALUMINUM WINDOW FRAMING. MINIBLINDS SHOULD BE TYPICAL 1" BLINDS WITH OPERATIONAL WAND AND DRAW-CORD.
8. COMMON AREA CEILINGS THAT ARE FINISHED WITH DRYWALL SHOULD BE PAINTED WITH PT-3.
9. ALL FINISH INFORMATION ON SHEET #608 SUPERCEDES FINISH INFORMATION ON OTHER SHEETS.
10. ALL EXPOSED STEEL IN STAIR WELLS TO BE PAINTED PT-9.

REFERENCE NOTES:


1. VCT TILE IN THIS LOCATION IS A CHECKER BOARD PATTERN OF VCT-1 & VCT-2
2. IN EACH RESTROOM T-1 & T-3 CREATE A CHECKER BOARD PATTERN THROUGHOUT THE RESTROOM. T-2 IS THE DIAGONAL ACCENT SHOWN AGAINST THE LONG WALL OF EACH RESTROOM. SEE TILE PATTERN DRAWN ABOVE IN THE FINISH PLAN.
3. ALL TOILET PARTITIONS ARE PAINTED TO MATCH PT-2 (SHERWIN WILLIAMS #1144, IMPORT IVORY).
4. SEE STONE POCHÉ KEY TO RIGHT FOR LOCATIONS OF ST-1, ST-2, ST-3.
5. IN ALL RESTROOMS T-1 & T-3 CREATE A CHECKER-BOARD PATTERN. T-2 IS THE DIAGONAL ACCENT ALONG THE LONG WALL ONLY. SEE FINISH TAGS FOR TILE BASE INFORMATION.

SYMBOL KEY

- FLOOR FINISH TAGS
FLOOR FINISH (TOP) &
BASE FINISH (BOTTOM)
- WALL FINISH TAG
- WALL FINISH LOCATION INDICATOR
- REFERENCE NOTE
- FINISH MATERIALS TAG
FINISH TRANSITION

STONE TILE FINISH POCHÉ KEY:

- TILE FINISH: ST-1
- TILE FINISH: ST-2
- TILE FINISH: ST-3

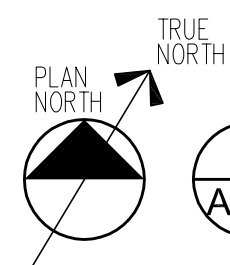

1
A609

SECOND FLOOR - FINISH PLAN

Scale: 1/8" = 1'-0"

GENERAL FINISH NOTES (SEE FINISH LEGEND ON SHEET #A606 FOR PRODUCT INFORMATION):

1. ALL FLOOR FINISHES ARE TO TRANSITION UNDER THE CENTER OF THE DOORWAY, UNLESS OTHERWISE NOTED.
2. ALL STONE TILE BASE SHALL BE 4" X 12" PIECES CUT FROM 12"X12" STONE TILES SPECIFIED.
3. PLEASE CROSS REFERENCE ALL ELEVATIONS FOR EVERY VERTICAL FINISH LOCATION.
4. ALL CLOSET INTERIORS ARE FINISHED WITH THE SAME PAINT AND CARPET AS THEIR ADJOINING CORRIDOR FINISHES, UNLESS OTHERWISE NOTED.
5. THE WALL FINISH LISTED ON THE WALL TAG IN THE CENTER OF EACH ROOM IS THE 'MAIN' WALL FINISH. SOME ROOMS HAVE ACCENT WALLS OF A SECONDARY FINISH (SEE NOTED PLANS).
6. SEE FINISH LEGEND FOR GROUT COLORS. EACH TILE HAS A MATCHING GROUT COLOR.
7. MINIBLINDS FOR ALL WINDOWS SHOULD MATCH THE ALUMINUM WINDOW FRAMING. MINIBLINDS SHOULD BE TYPICAL 1" BLINDS WITH OPERATIONAL WAND AND DRAW-CORD.
8. COMMON AREA CEILINGS THAT ARE FINISHED WITH DRYWALL SHOULD BE PAINTED WITH PT-3.
9. ALL FINISH INFORMATION ON SHEET #608 SUPERCEDES FINISH INFORMATION ON OTHER SHEETS.
10. ALL EXPOSED STEEL IN STAIR WELLS TO BE PAINTED PT-9.

REFERENCE NOTES:

1. VCT TILE IN THIS LOCATION IS A CHECKER BOARD PATTERN OF VCT-1 & VCT-2
2. IN EACH RESTROOM T-1 & T-3 CREATE A CHECKER BOARD PATTERN THROUGHOUT THE RESTROOM. T-2 IS THE DIAGONAL ACCENT SHOWN AGAINST THE LONG WALL OF EACH RESTROOM. SEE TILE PATTERN DRAWN ABOVE IN THE FINISH PLAN.
3. ALL TOILET PARTITIONS ARE PAINTED TO MATCH PT-2 (SHERWIN WILLIAMS #1144, IMPORT IVORY).
4. SEE STONE POCHÉ KEY TO RIGHT FOR LOCATIONS OF ST-1, ST-2, ST-3.
5. IN ALL RESTROOMS T-1 & T-3 CREATE A CHECKER-BOARD PATTERN. T-2 IS THE DIAGONAL ACCENT ALONG THE LONG WALL ONLY. SEE FINISH TAGS FOR TILE BASE INFORMATION.

SYMBOL KEY

- FLOOR BASE
- FLOOR FINISH TAGS: FLOOR FINISH (TOP) & BASE FINISH (BOTTOM)
- WALL FINISH TAG
- WALL FINISH LOCATION INDICATOR
- REFERENCE NOTE
- FINISH MATERIALS TAG
- FINISH TRANSITION

STONE TILE FINISH POCHÉ KEY:

- TILE FINISH: ST-1
- TILE FINISH: ST-2
- TILE FINISH: ST-3


Revisions:

Scale:	1/8"=1'
Date:	4/8/05
Drawn By:	STAFF
Checked By:	BER

PARAGON GLOBAL RESOURCES
CANTERA CORPORATE CENTER
LOT 1 - BELLA VISTA PARKWAY
WARRENVILLE, ILLINOIS
FOUNDATION PLAN

Certified By:


Drawing Number:
S1
Of Sheets
Duke Realty Job Number:
PARAGN-001
A/E Job Number:
05-0078

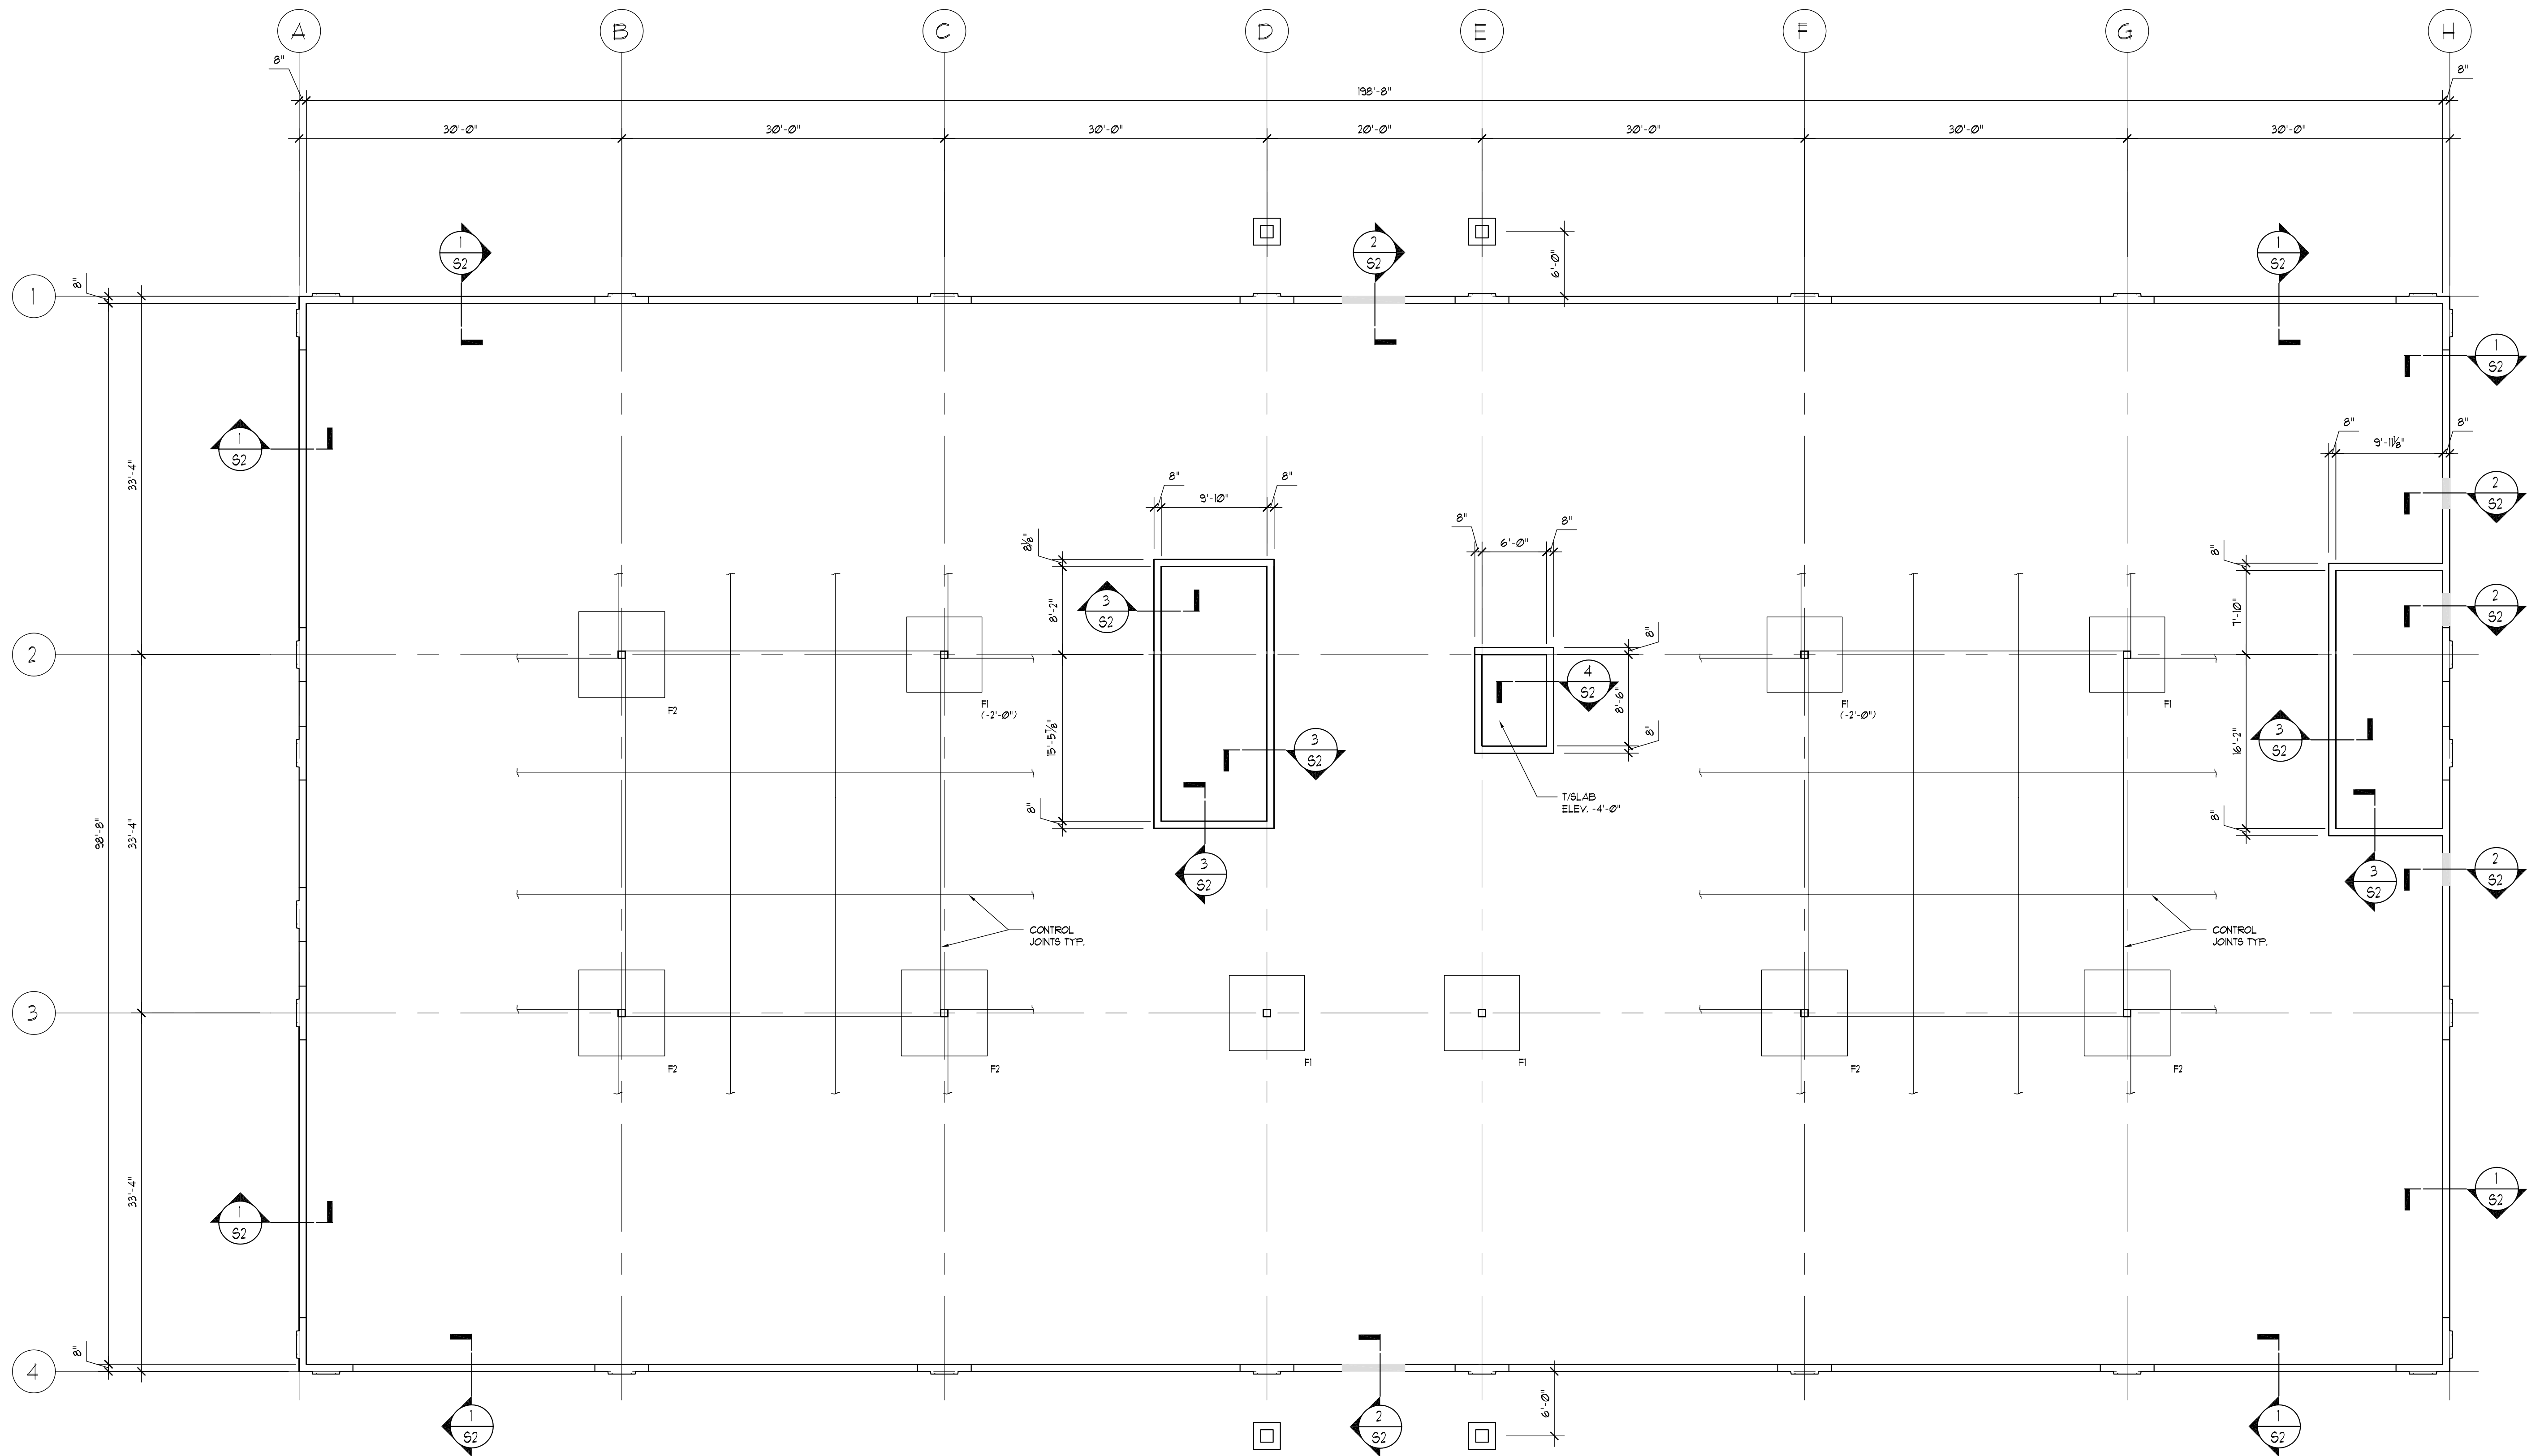

FOOTING SCHEDULE					
MARK	WIDTH	LENGTH	THICKNESS	REINFORCING (BOT. EACH WAY UON)	REMARKS
F1	1'-0"	1'-0"	2'-6"	NONE	
F2	8'-0"	8'-0"	2'-6"	NONE	
F3					
F4					
F5					

FOUNDATION PLAN

SCALE 1/8"=1'-0"

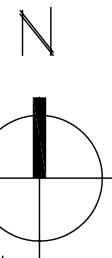


5" CONCRETE SLAB ON 4" WELL GRADED GRANULAR FILL ON 6 MIL VAPOR BARRIER. FINISH FLOOR SLAB TO F1+25 AND F1+15 FRO FLATNESS AND LEVELNESS, RESPECTIVELY.
TOP OF INTERIOR FOOTING ELEVATION -1'-0" UNLESS NOTED
TOP OF EXTERIOR TRENCH FOOTING ELEVATION -1'-0" UNLESS NOTED
BOTTOM OF EXTERIOR TRENCH FOOTING -4'-0" UNLESS NOTED
TOP OF WALL ELEVATION -1'-0" UNLESS NOTED




PROFESSIONAL DESIGN FIRM
STRUCTURAL ENGINEERING CORP.
LICENSE NUMBER 184-003320
EXPIRATION 04/30/2007


EXP. DATE _____
DATE _____

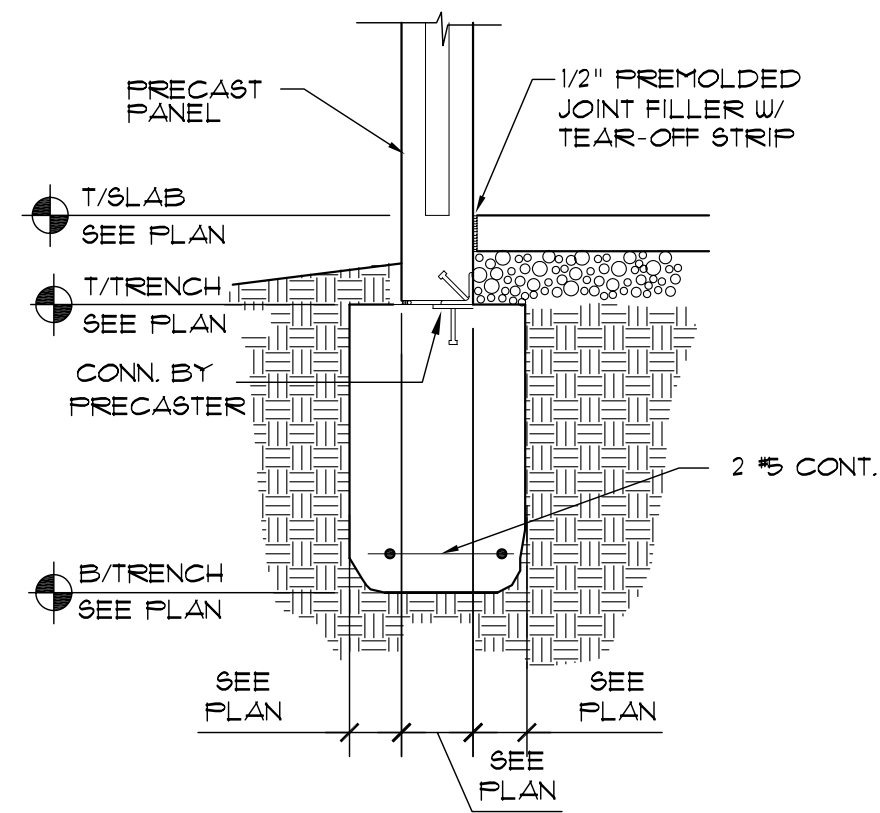


SECTION 1
SCALE 1/2"=1'-0"

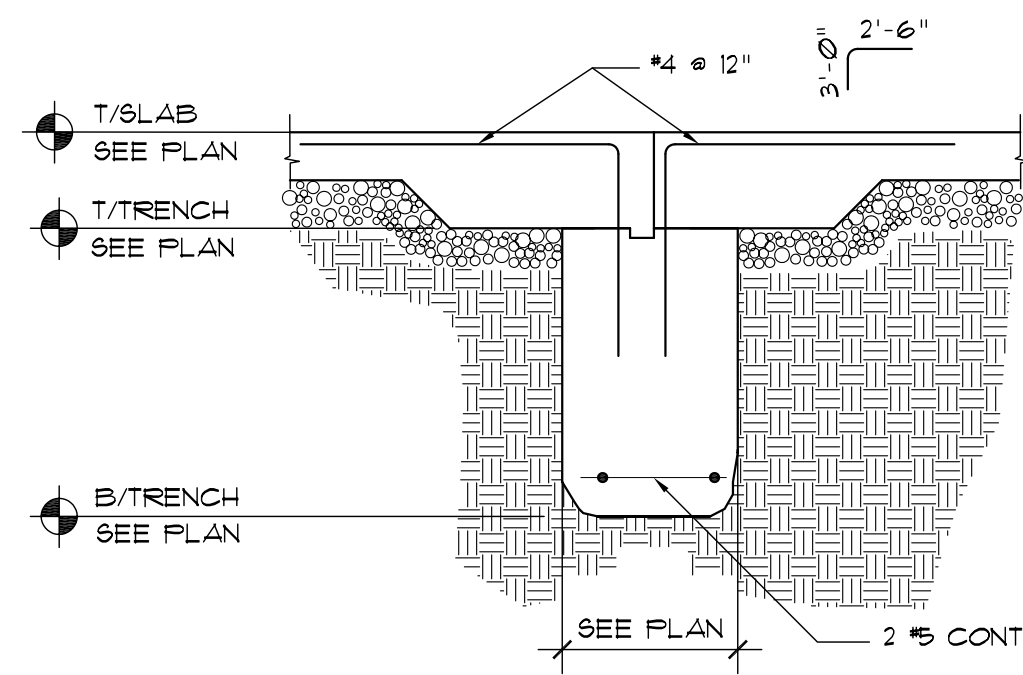


SECTION 2
SCALE 1/2"=1'-0"

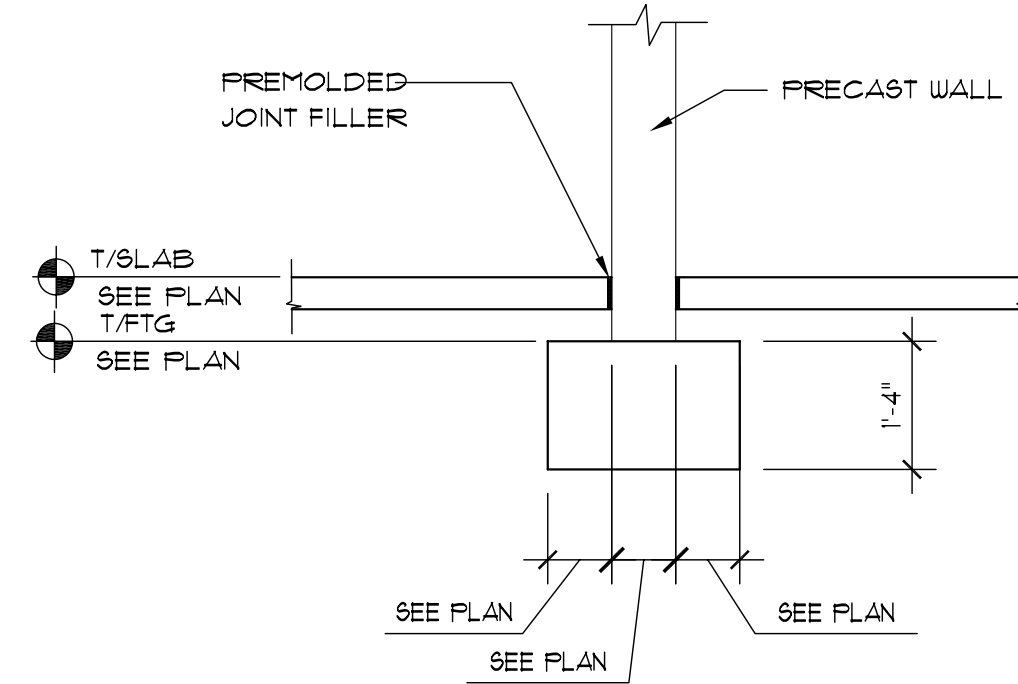



SECTION 3
SCALE 1/2"=1'-0"

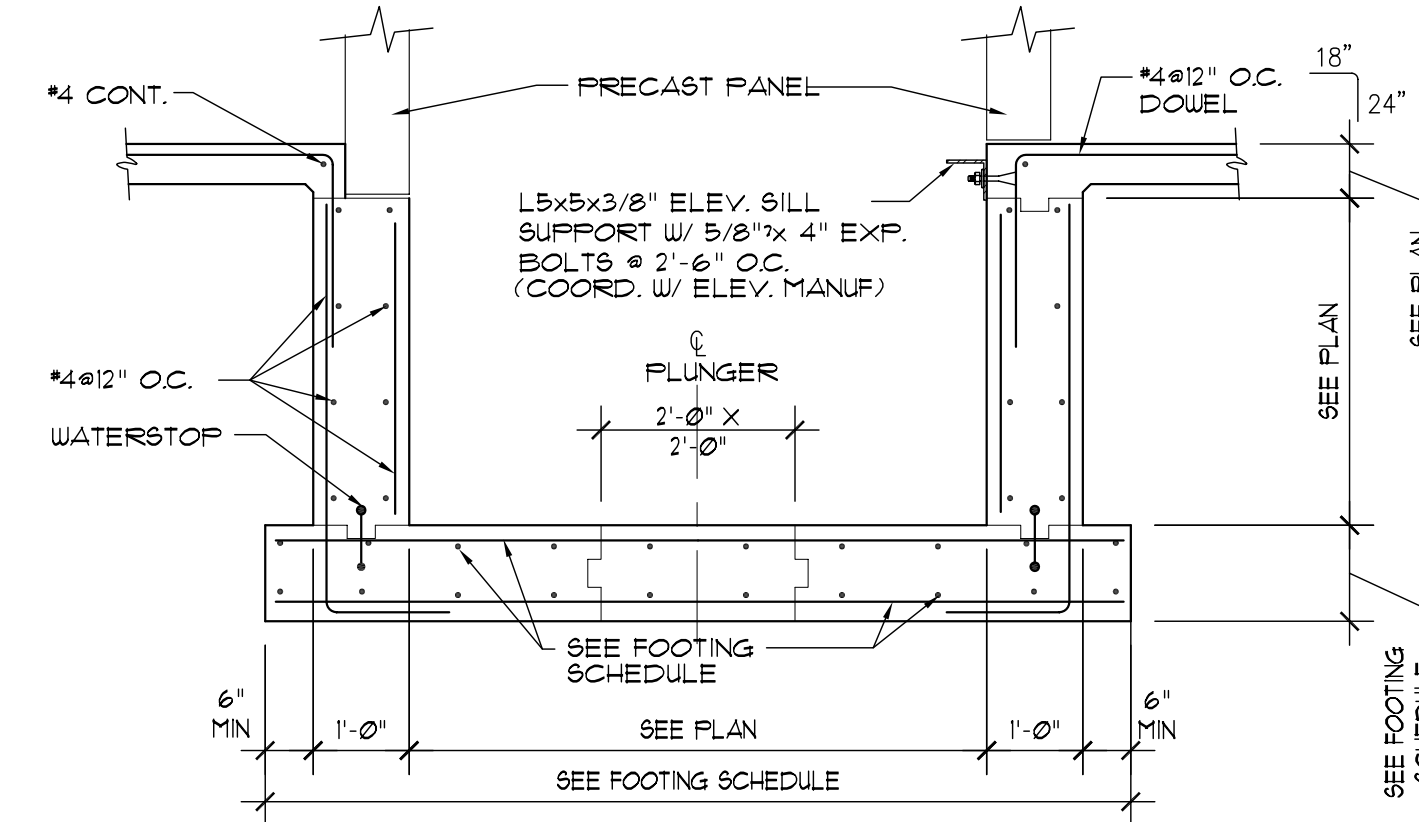

SECTION 4
SCALE 1/2"=1'-0"

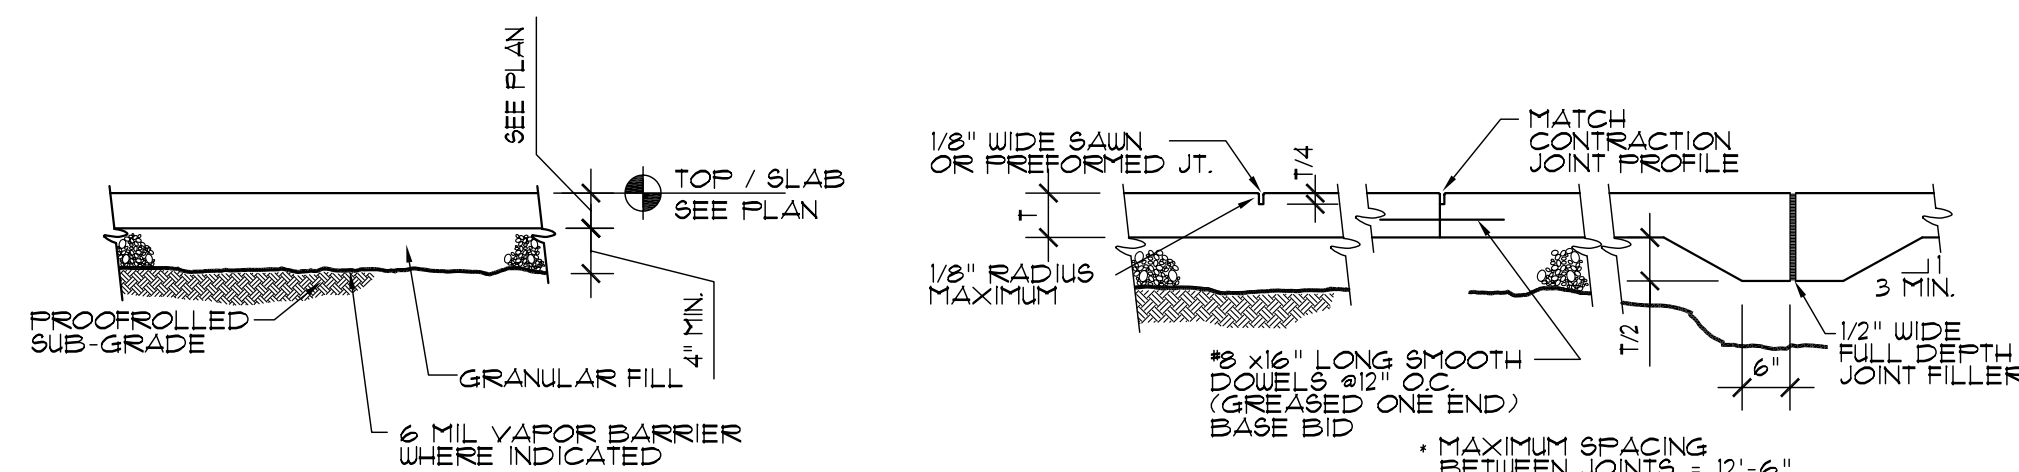

TYPICAL SLAB-ON-GRADE DETAILS
NO SCALE

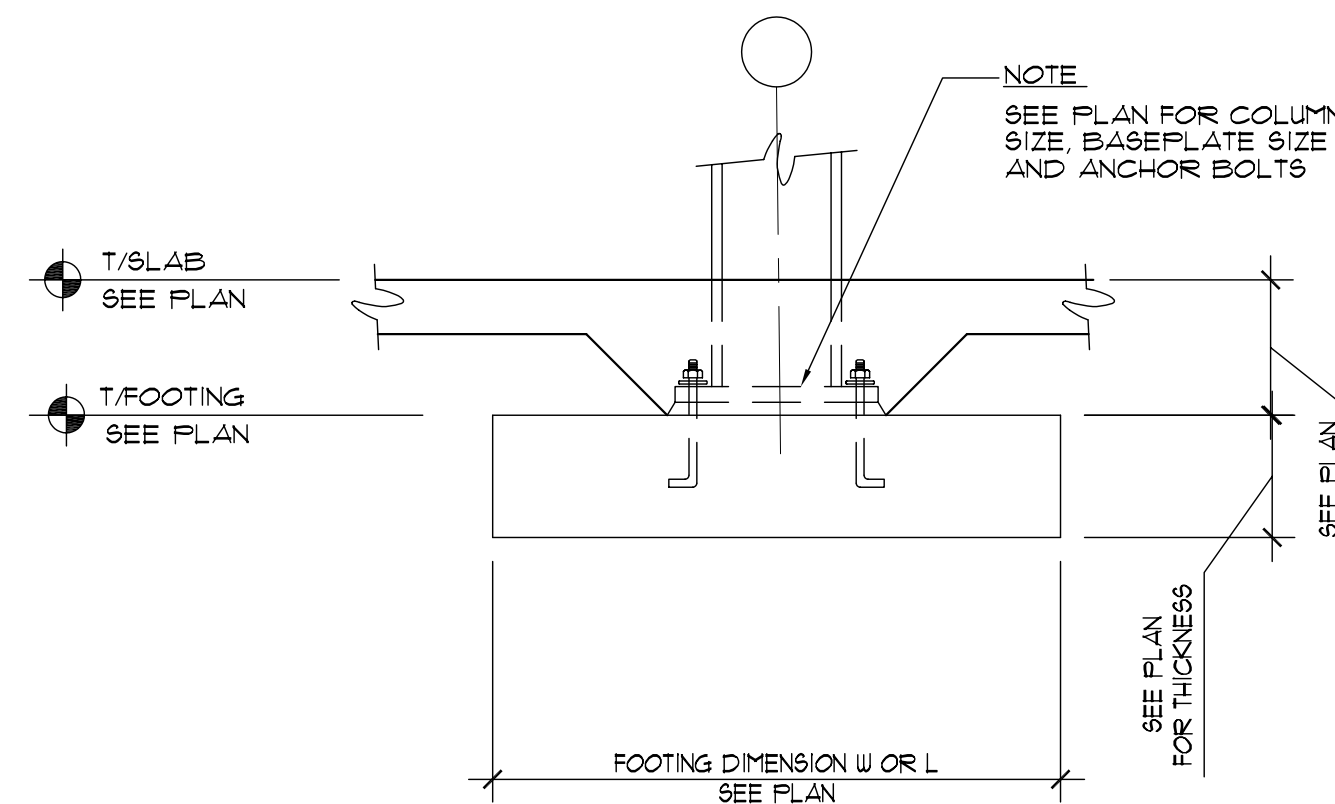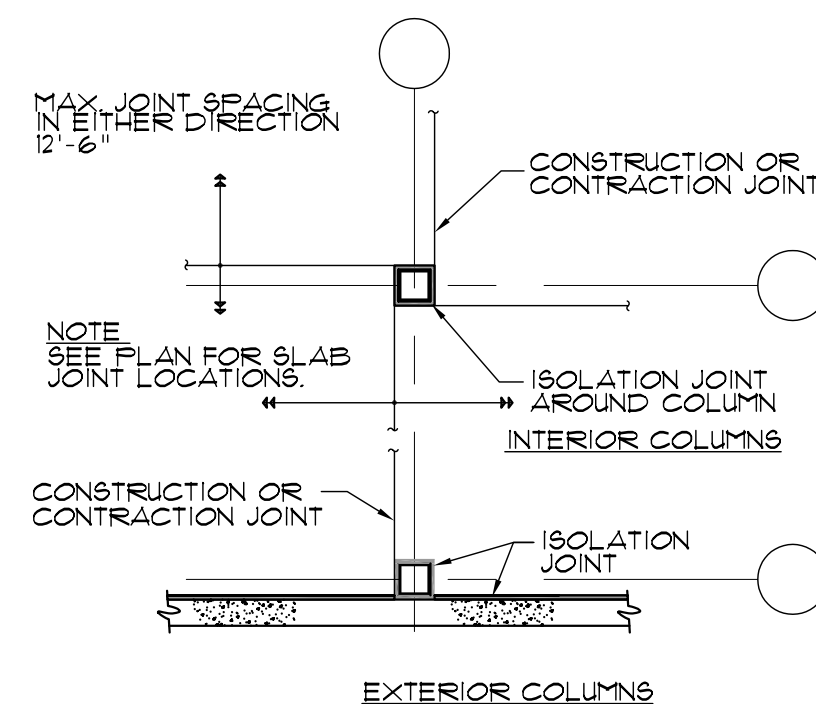

TYPICAL COLUMN FOOTING
SCALE 1/2"=1'-0"

EXP. DATE _____

DATE _____



475 SEYBROOKE LANE
CRYSTAL LAKE, IL 60012
TEL: 815.444.6424
FAX: 815.444.6525

PROFESSIONAL DESIGN FIRM
STRUCTURAL ENGINEERING CORP.
LICENSE NUMBER 184-003320
EXPIRATION 04/30/2007

EXP. DATE _____
DATE _____

Revisions:


Scale:	1/8"=1'
Date:	4/8/05
Drawn By:	STAFF
Checked By:	BER

PARAGON GLOBAL RESOURCES CANTERA CORPORATE CENTER LOT 1 - BELLA VISTA PARKWAY WARRENVILLE, ILLINOIS	ROOF FRAMING PLAN
--	-------------------


Certified By:

Drawing Number:
S4
Of Sheets


Duke Realty Job Number:
PARAGN-001
A/E Job Number:
05-0078

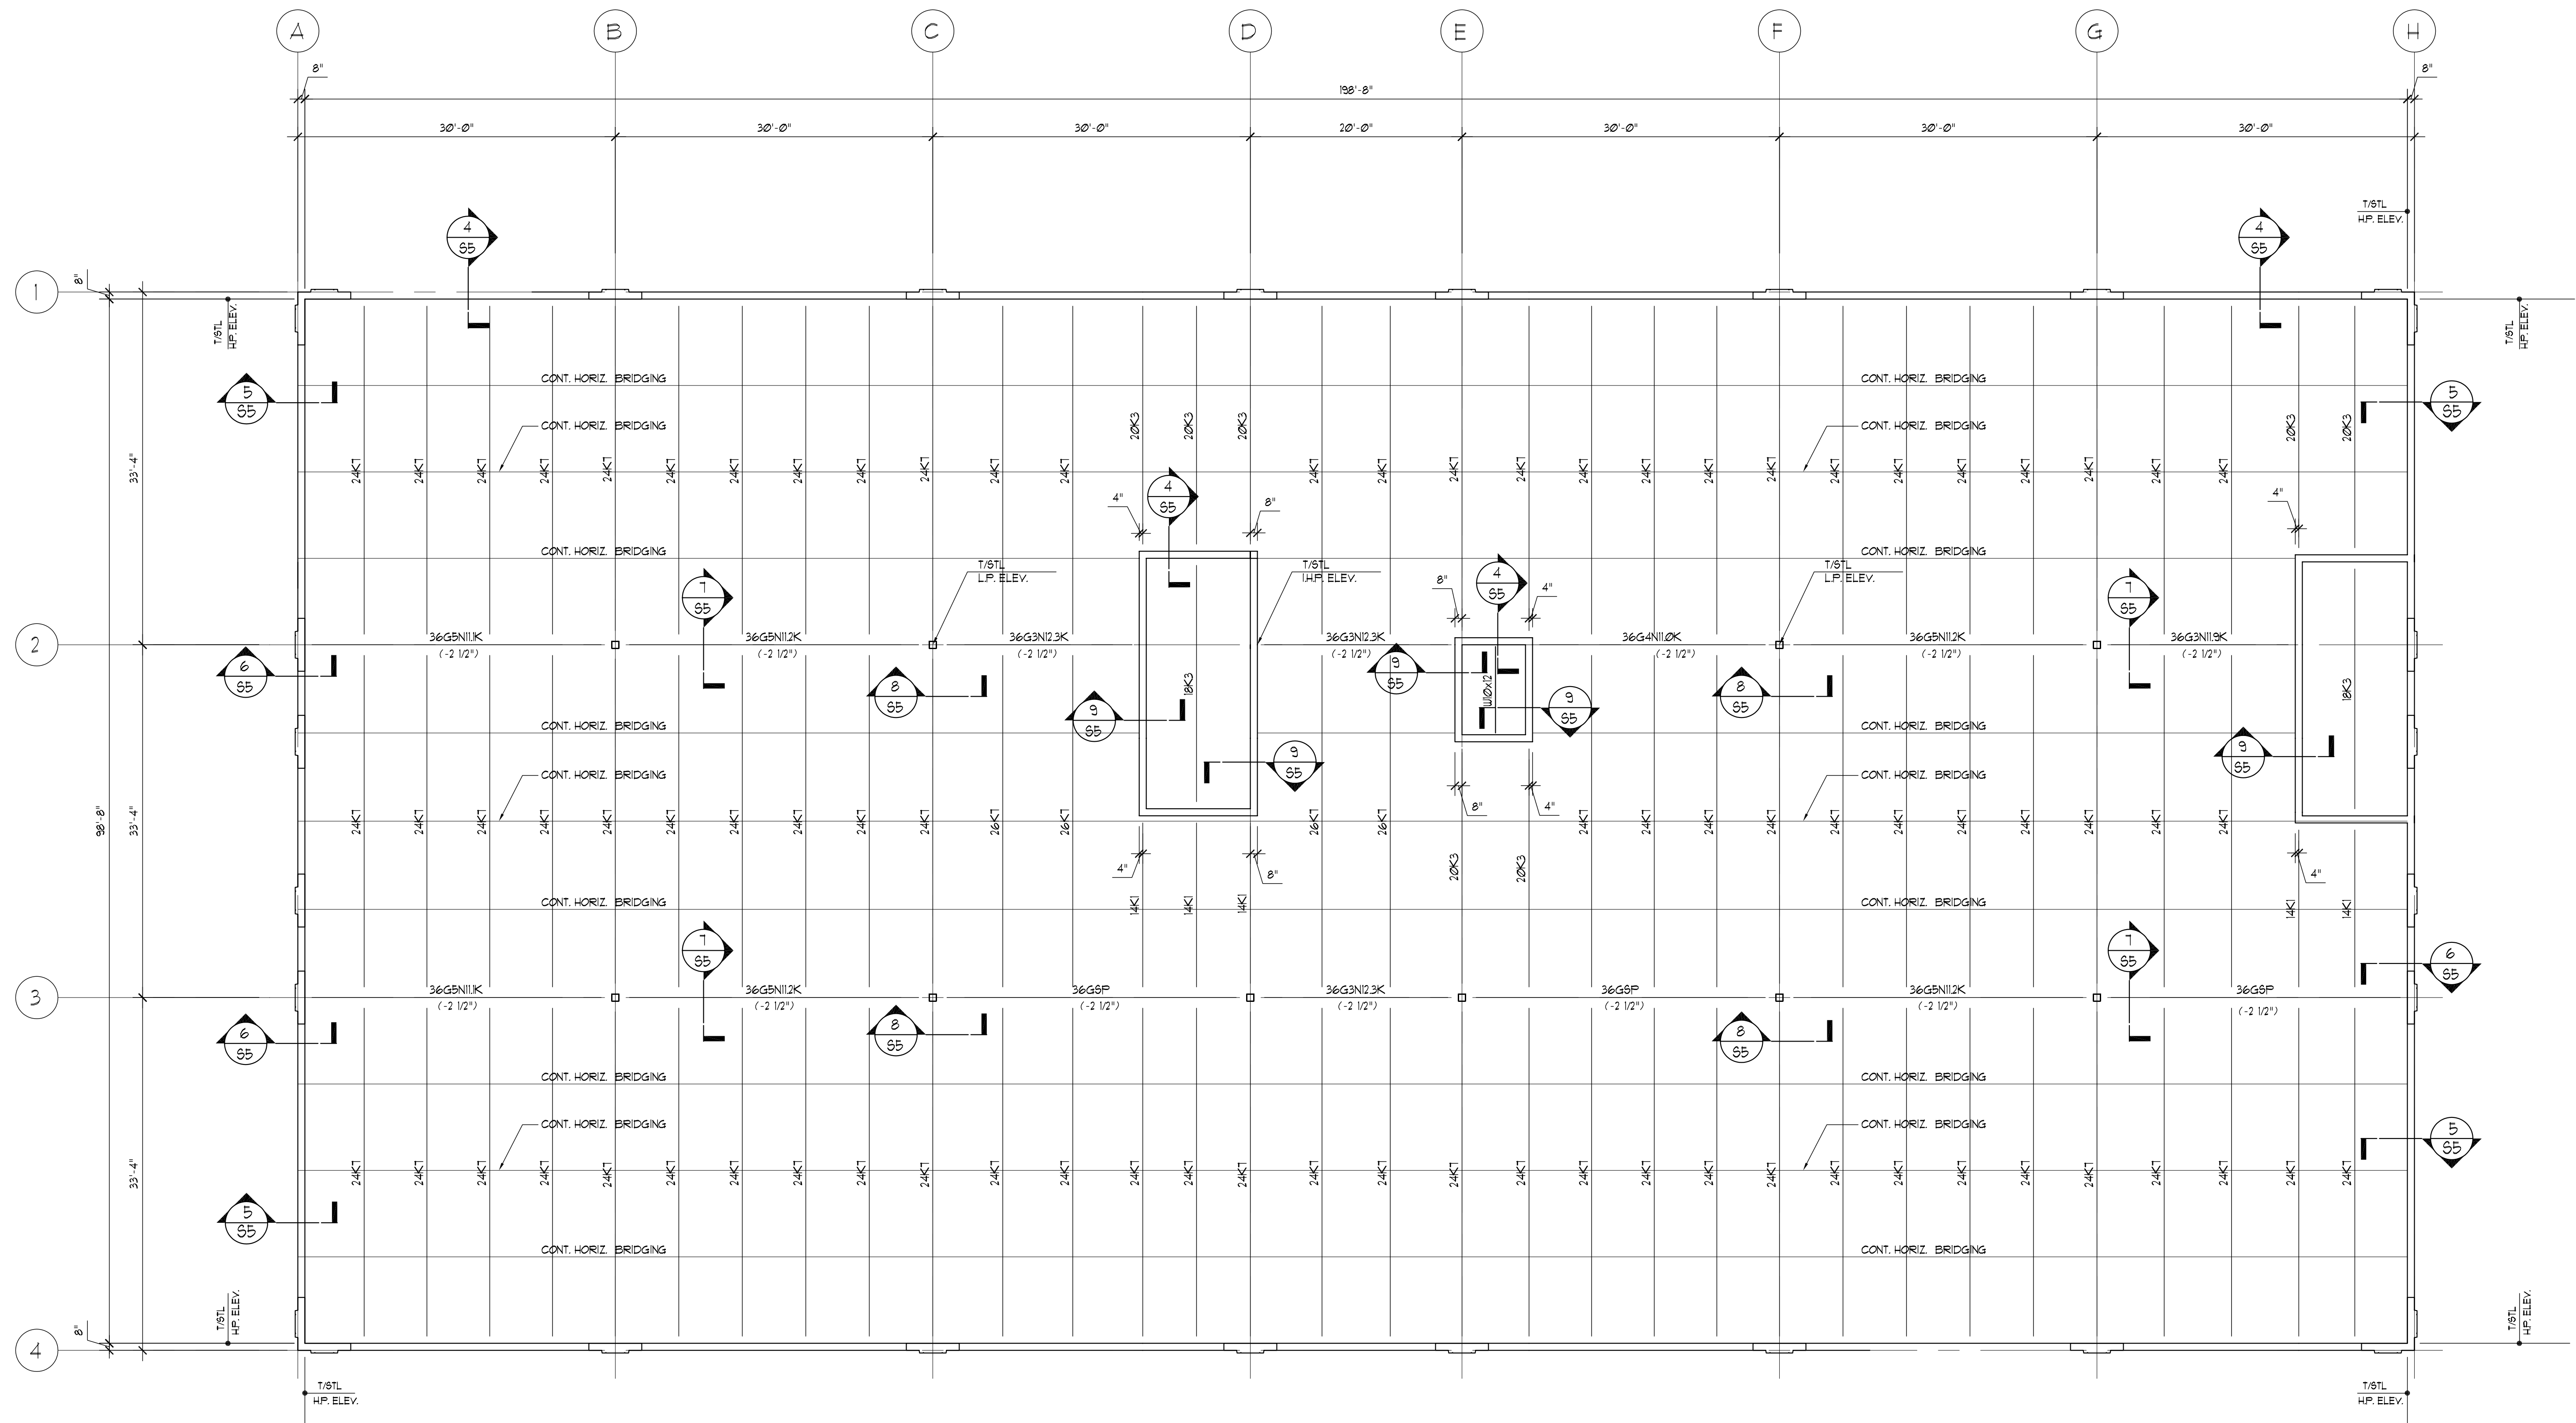

ROOF FRAMING PLAN
SCALE 1/8"=1'-0"

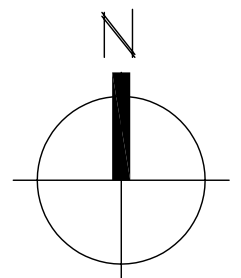

1 1/2" 22 GAGE WIDE RIB TYPE B METAL ROOF DECK PAINTED
END REACTIONS GIVEN ARE SERVICE LOADS
TO BE USED IN DESIGN OF PRECAST PANELS
TOP OF STEEL AT HIGH POINT ELEVATION 29'-2"
TOP OF STEEL AT LOW POINT ELEVATION 21'-9 1/2"
TOP OF STEEL AT INTERMEDIATE HIGH POINT ELEVATION 28'-3 1/2"

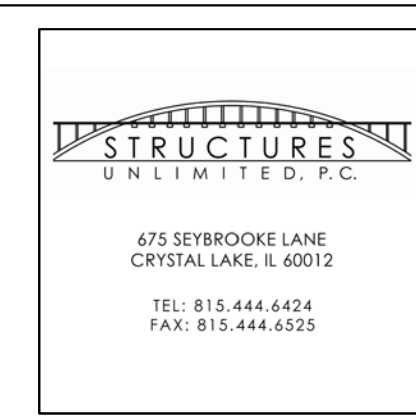

PROFESSIONAL DESIGN FIRM
STRUCTURAL ENGINEERING CORP.
LICENSE NUMBER 184-003320
EXPIRATION 04/30/2007

EXP. DATE _____
DATE _____

